


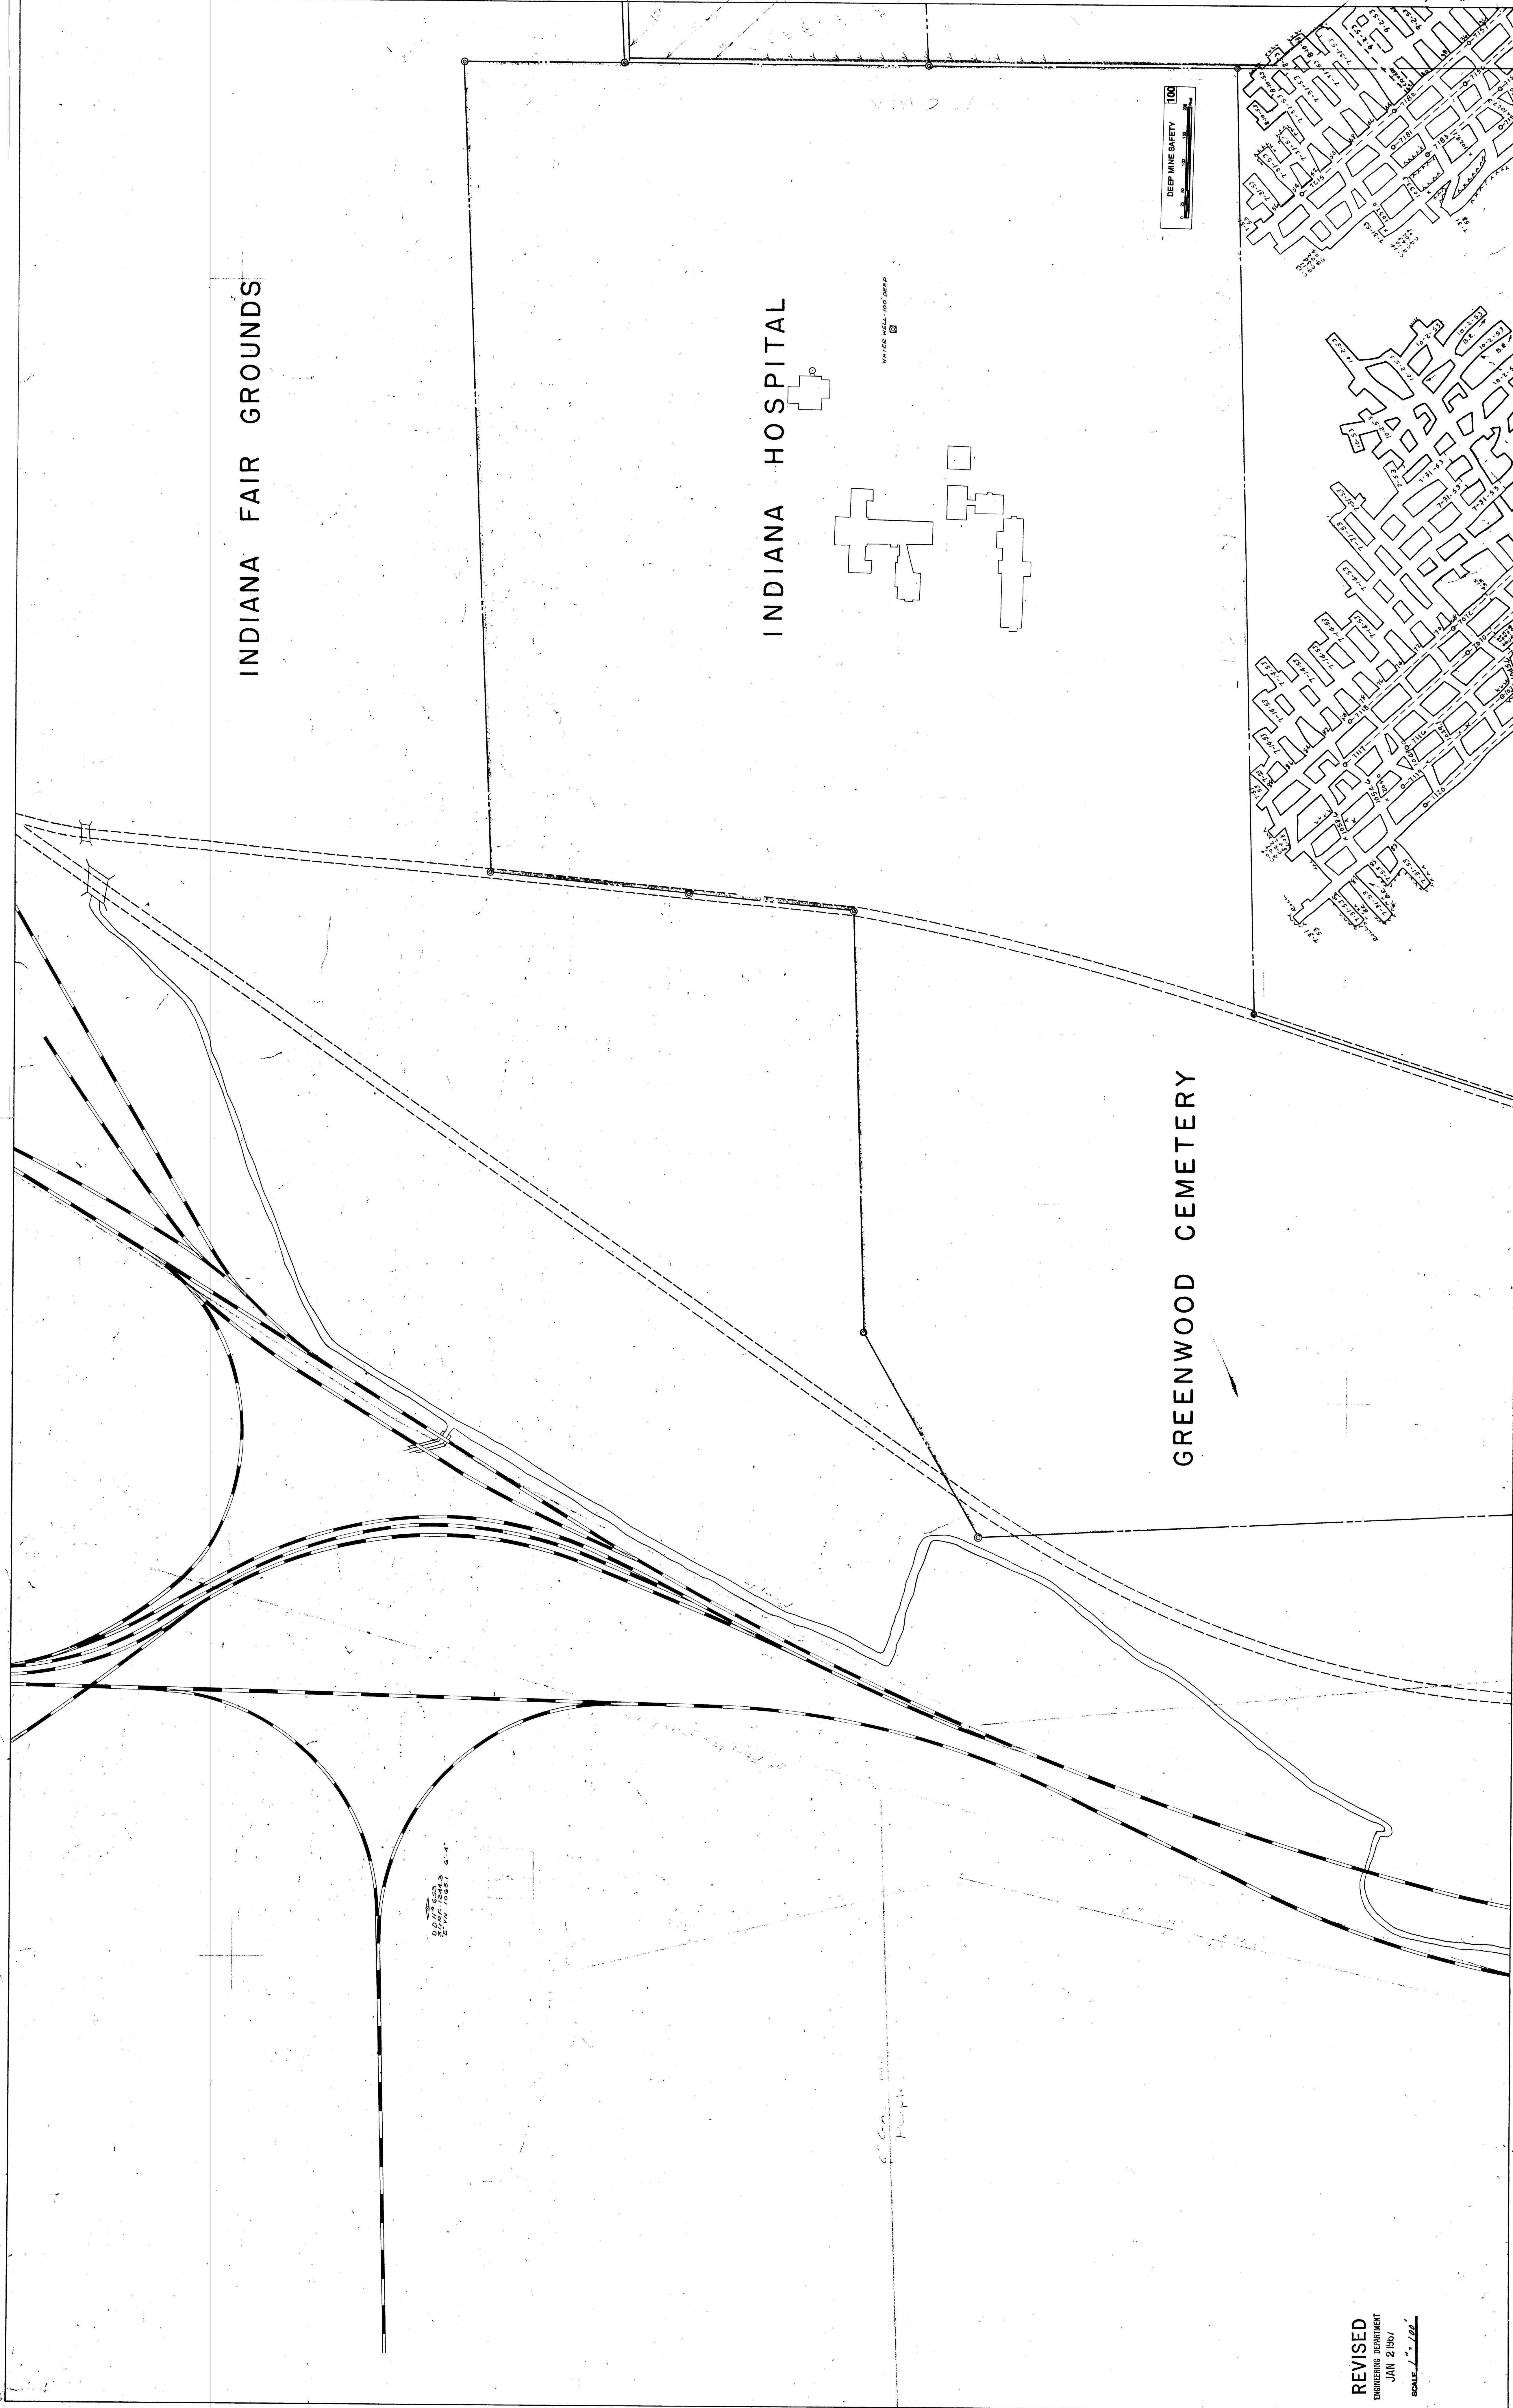

REVISED  
ENGINEERING DEPARTMENT  
JAN 2 1967  
SCALE 1" = 100'