


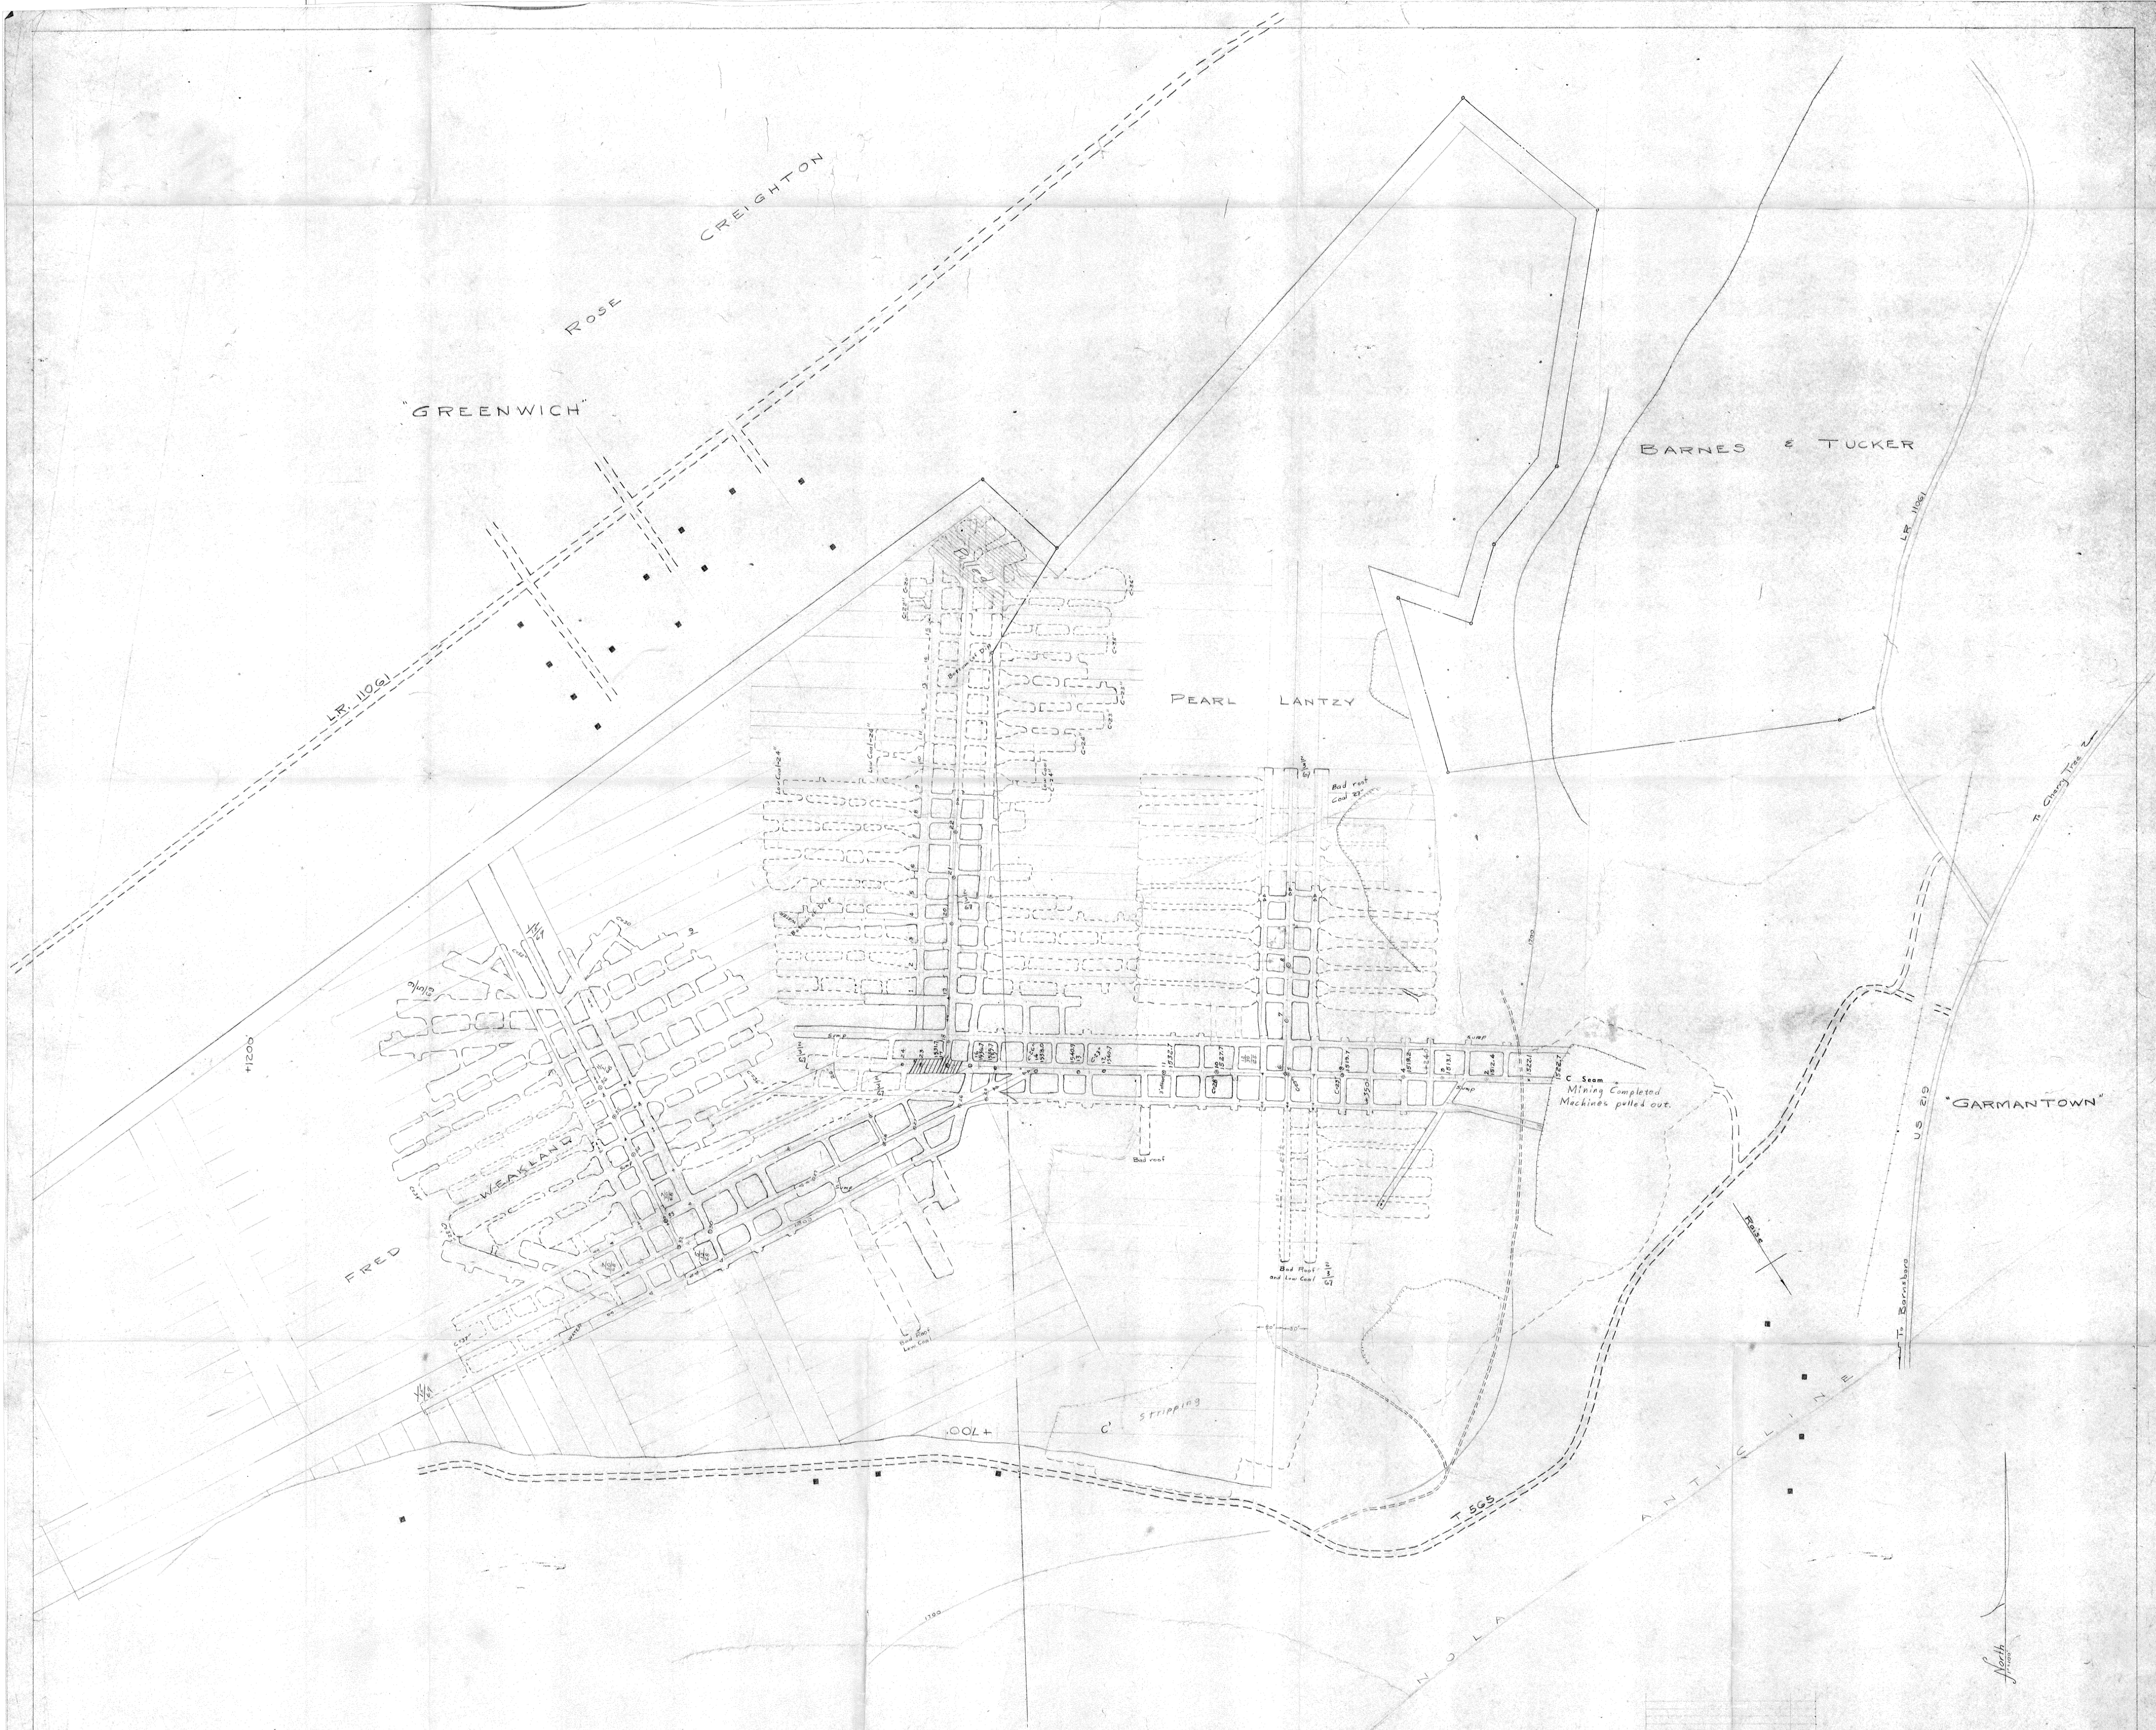

LEGEND
□ Contemplated Mining
February 3, 1961 to August 3, 1963
□ Mining Completed SSA

For Completion	3/17/63	RST
Mine Works	11/2/60	WRR
Mine Works	11/5/60	GAT
Mine Works	7/30/60	RST
Mine Works	5/13/60	WRR
Mine Works	4/27/57	RST
Up to date	2/2/61	GAT
Mine Works	12/30/60	RST

REVISIONS

PERMIT #64-1

HEPBURNIA COAL CO.	
LULA MAY NO 1	
SUSQUEHANNA TWP	CAMARIA CO, PA.
SCALE 1 inch=100 feet	
AUGUST 2, 1963	JOHN W. HESS
CLEARFIELD, PA.	ENGINEER