



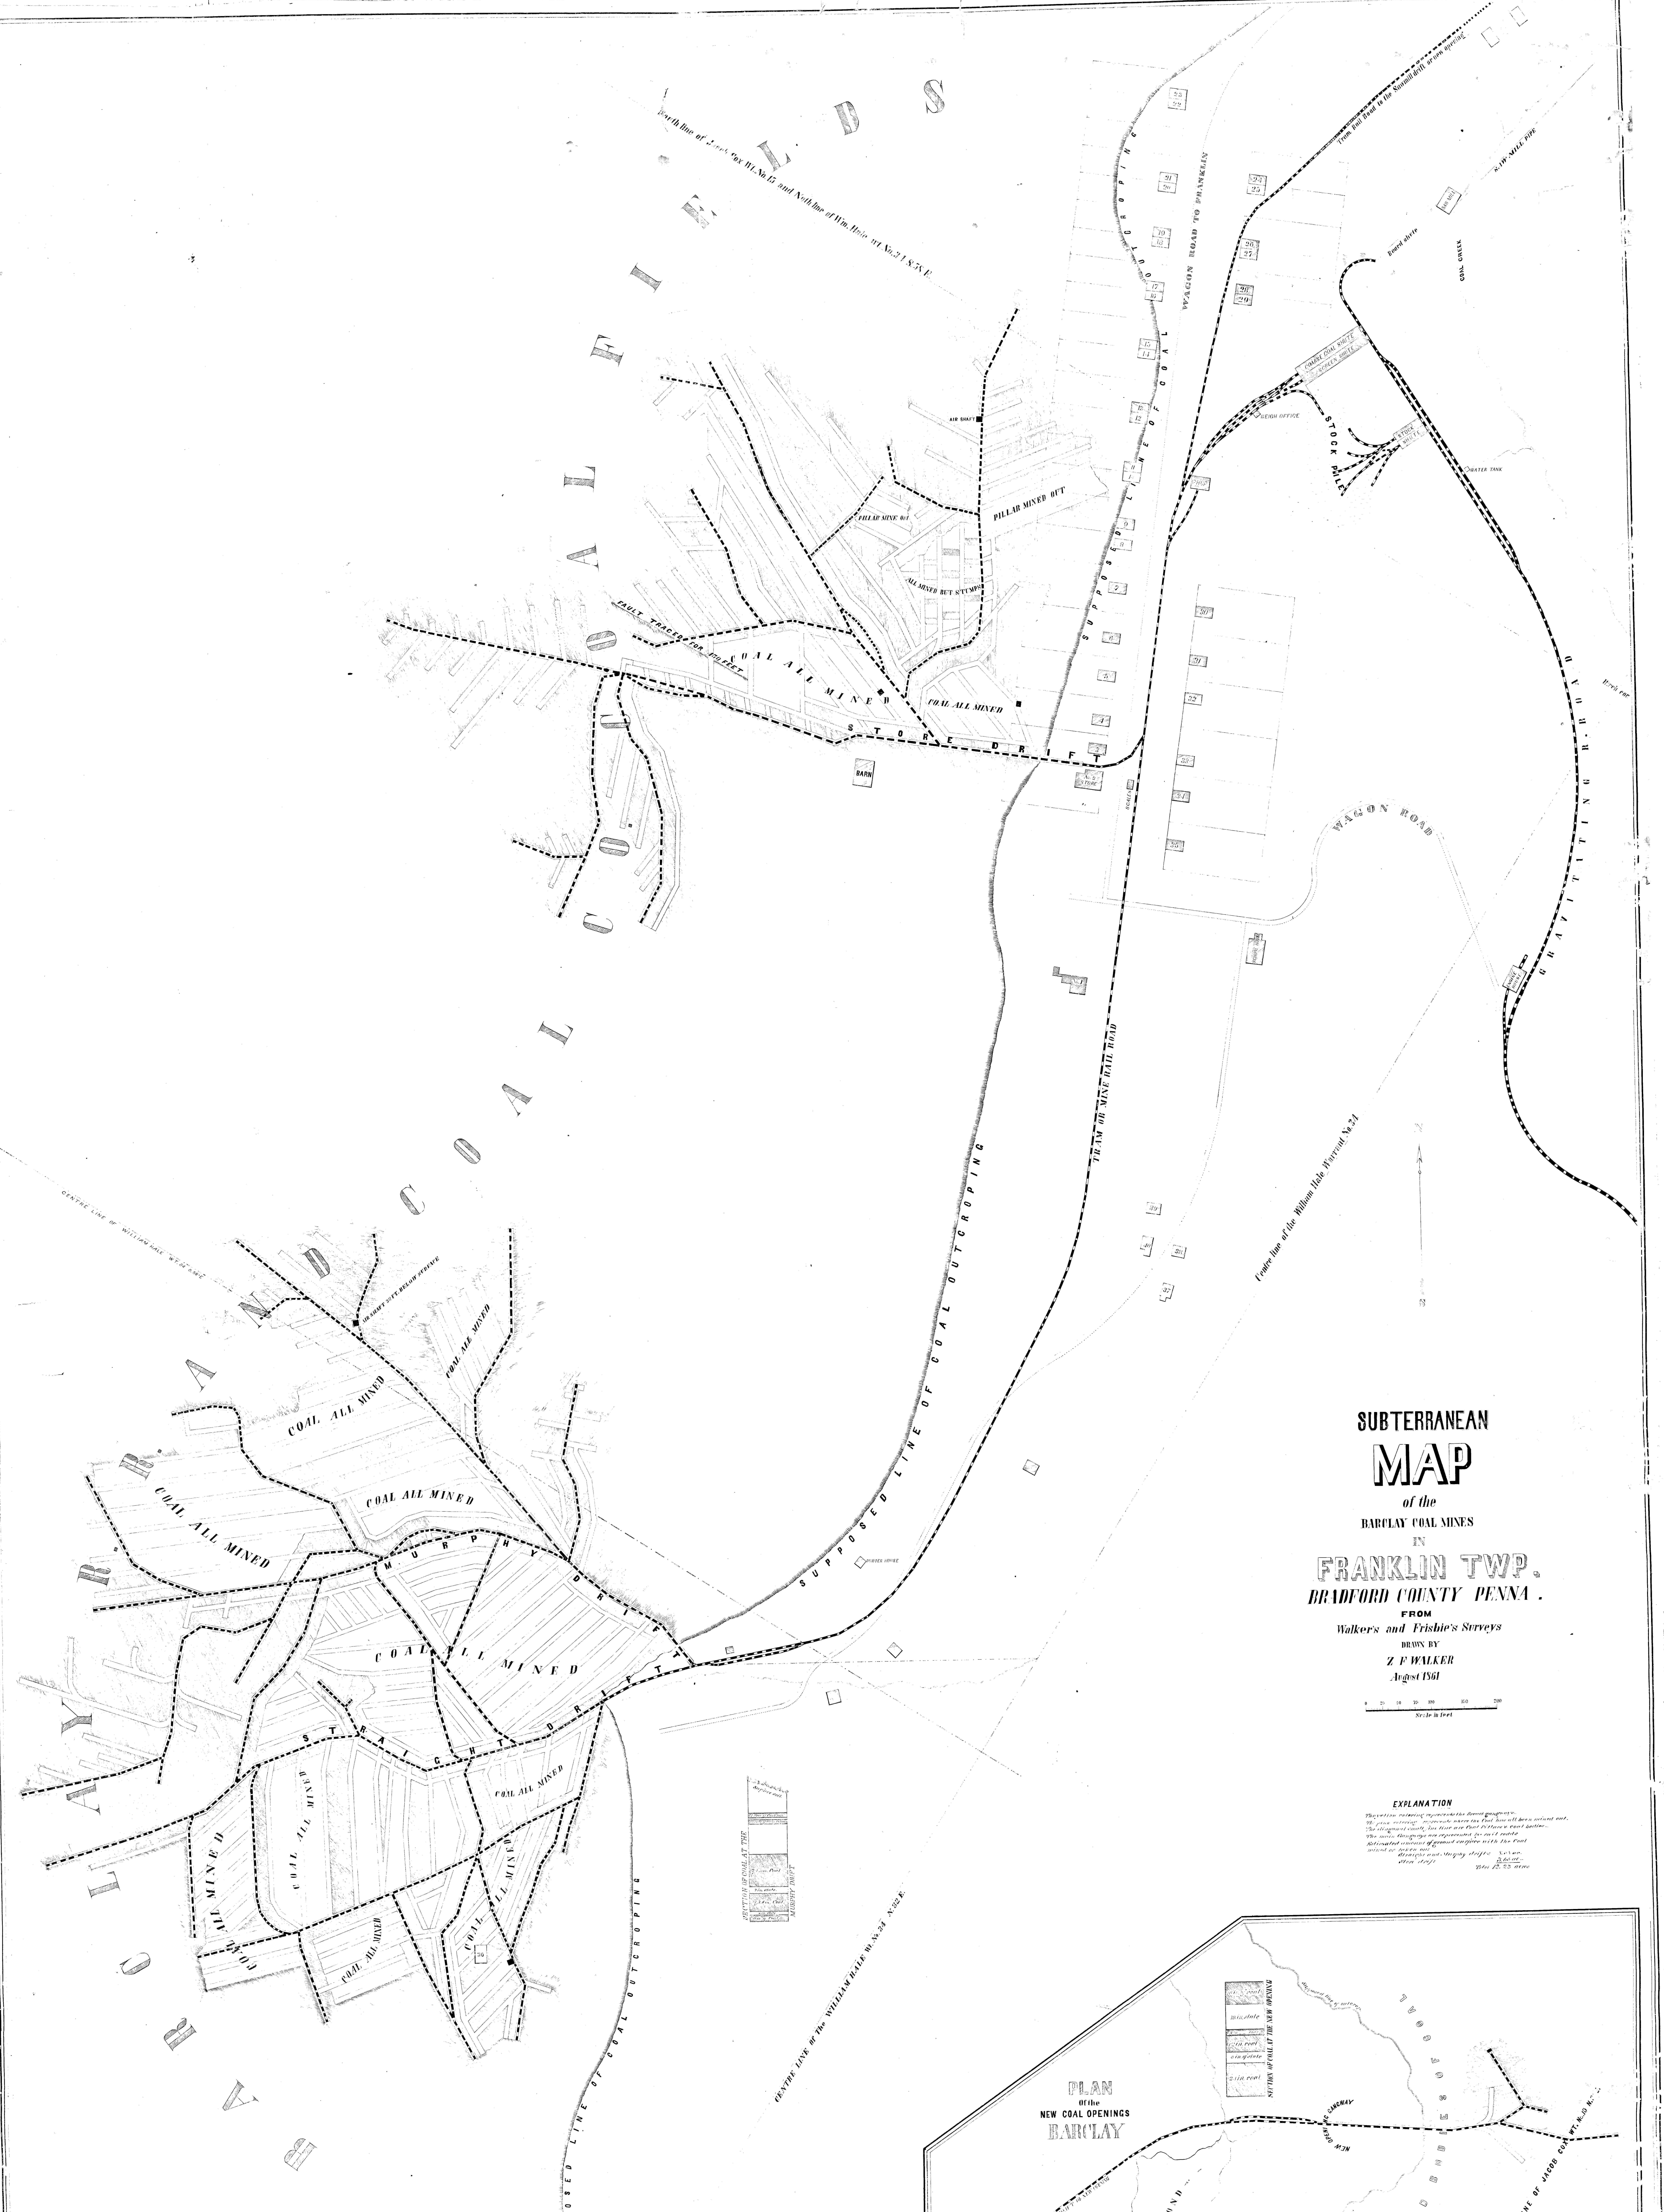


SUBTERRANEAN
MAP
of the
BARCLAY COAL MINES
IN
FRANKLIN TWP.
BRADFORD COUNTY PENNA.

FROM
Walkers and Frisbie's Surveys
DRAWN BY
Z. F. WALKER
August 1881

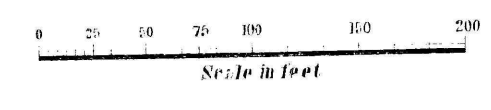

EXPLANATION


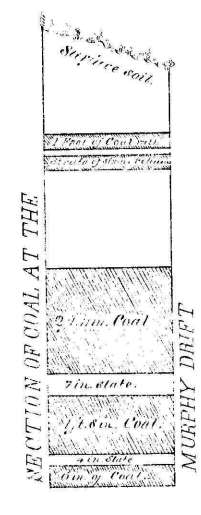

PLAN
of the
NEW COAL OPENINGS
BARCLAY

