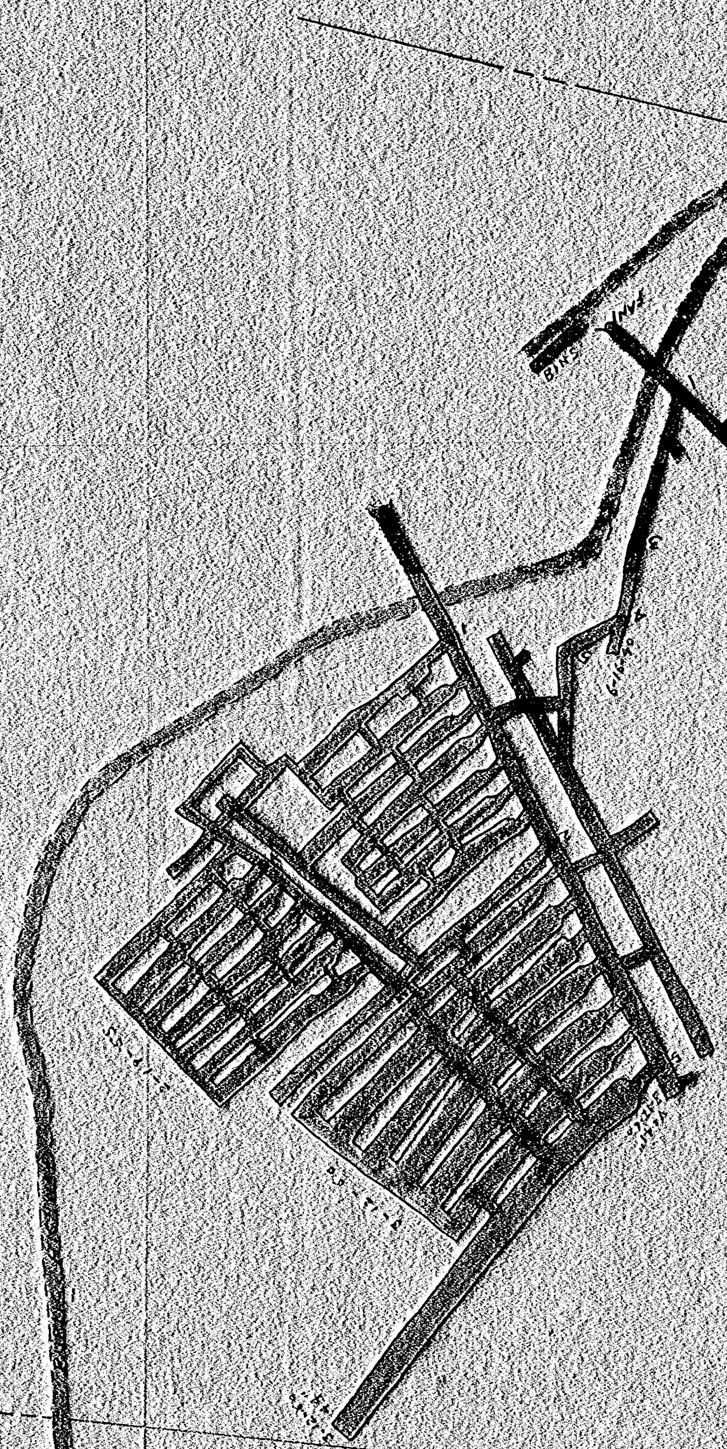

JOHN ROSENBERGER HEIRS

LOUIS SMITH

HELVETIA MINING CO.

Post

N

MAP OF
C. D. McCANNA MINE ON "COOK ESTATE"
KITTANNING TWP. ARMSTRONG CO. PENNA.
SCALE: 1" = 100'
3-12-69