


McClarren Colliery Co
Gen. Refractories Co
Decatur Twp CPG Co

Hotry date Quad.

GENERAL REFRACTORIES COMPANY
MAP OF
McCLARREN COLLIERY N° 1
SITUATED IN
DECATUR TWP, CLEARFIELD CO, PA.
SCALE 1" = 100'
WEST DECATUR CO
JANUARY 2, 1881
Drawn by G. W. Smeal

G W Smeal

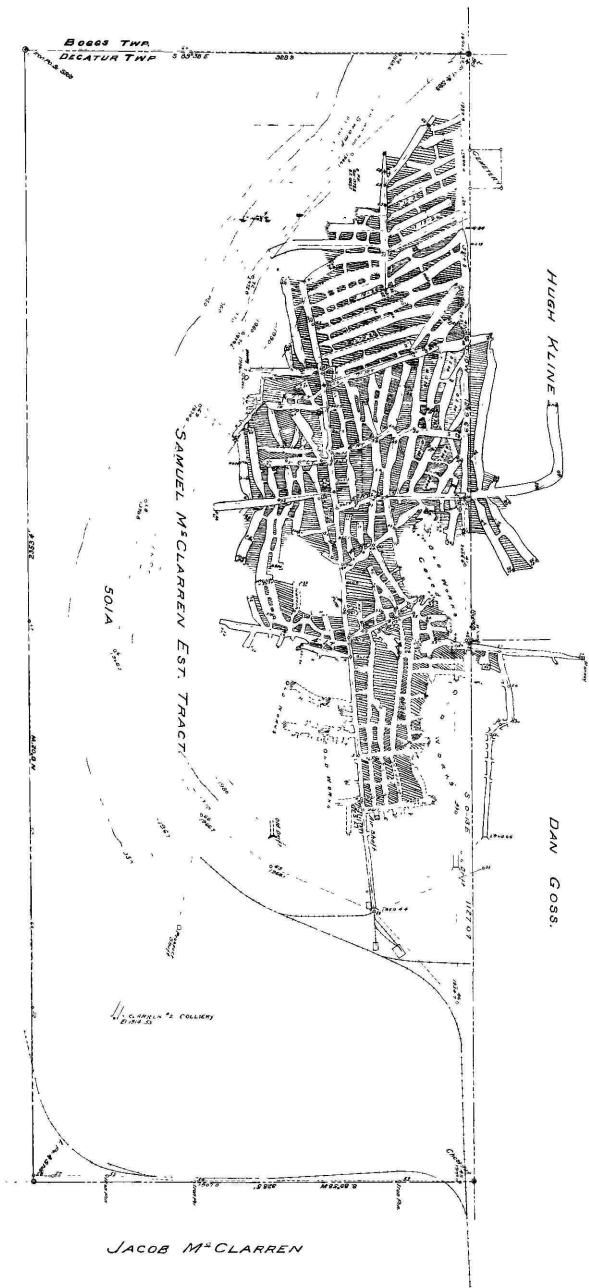

SAMUEL M° CLARREN EST.

