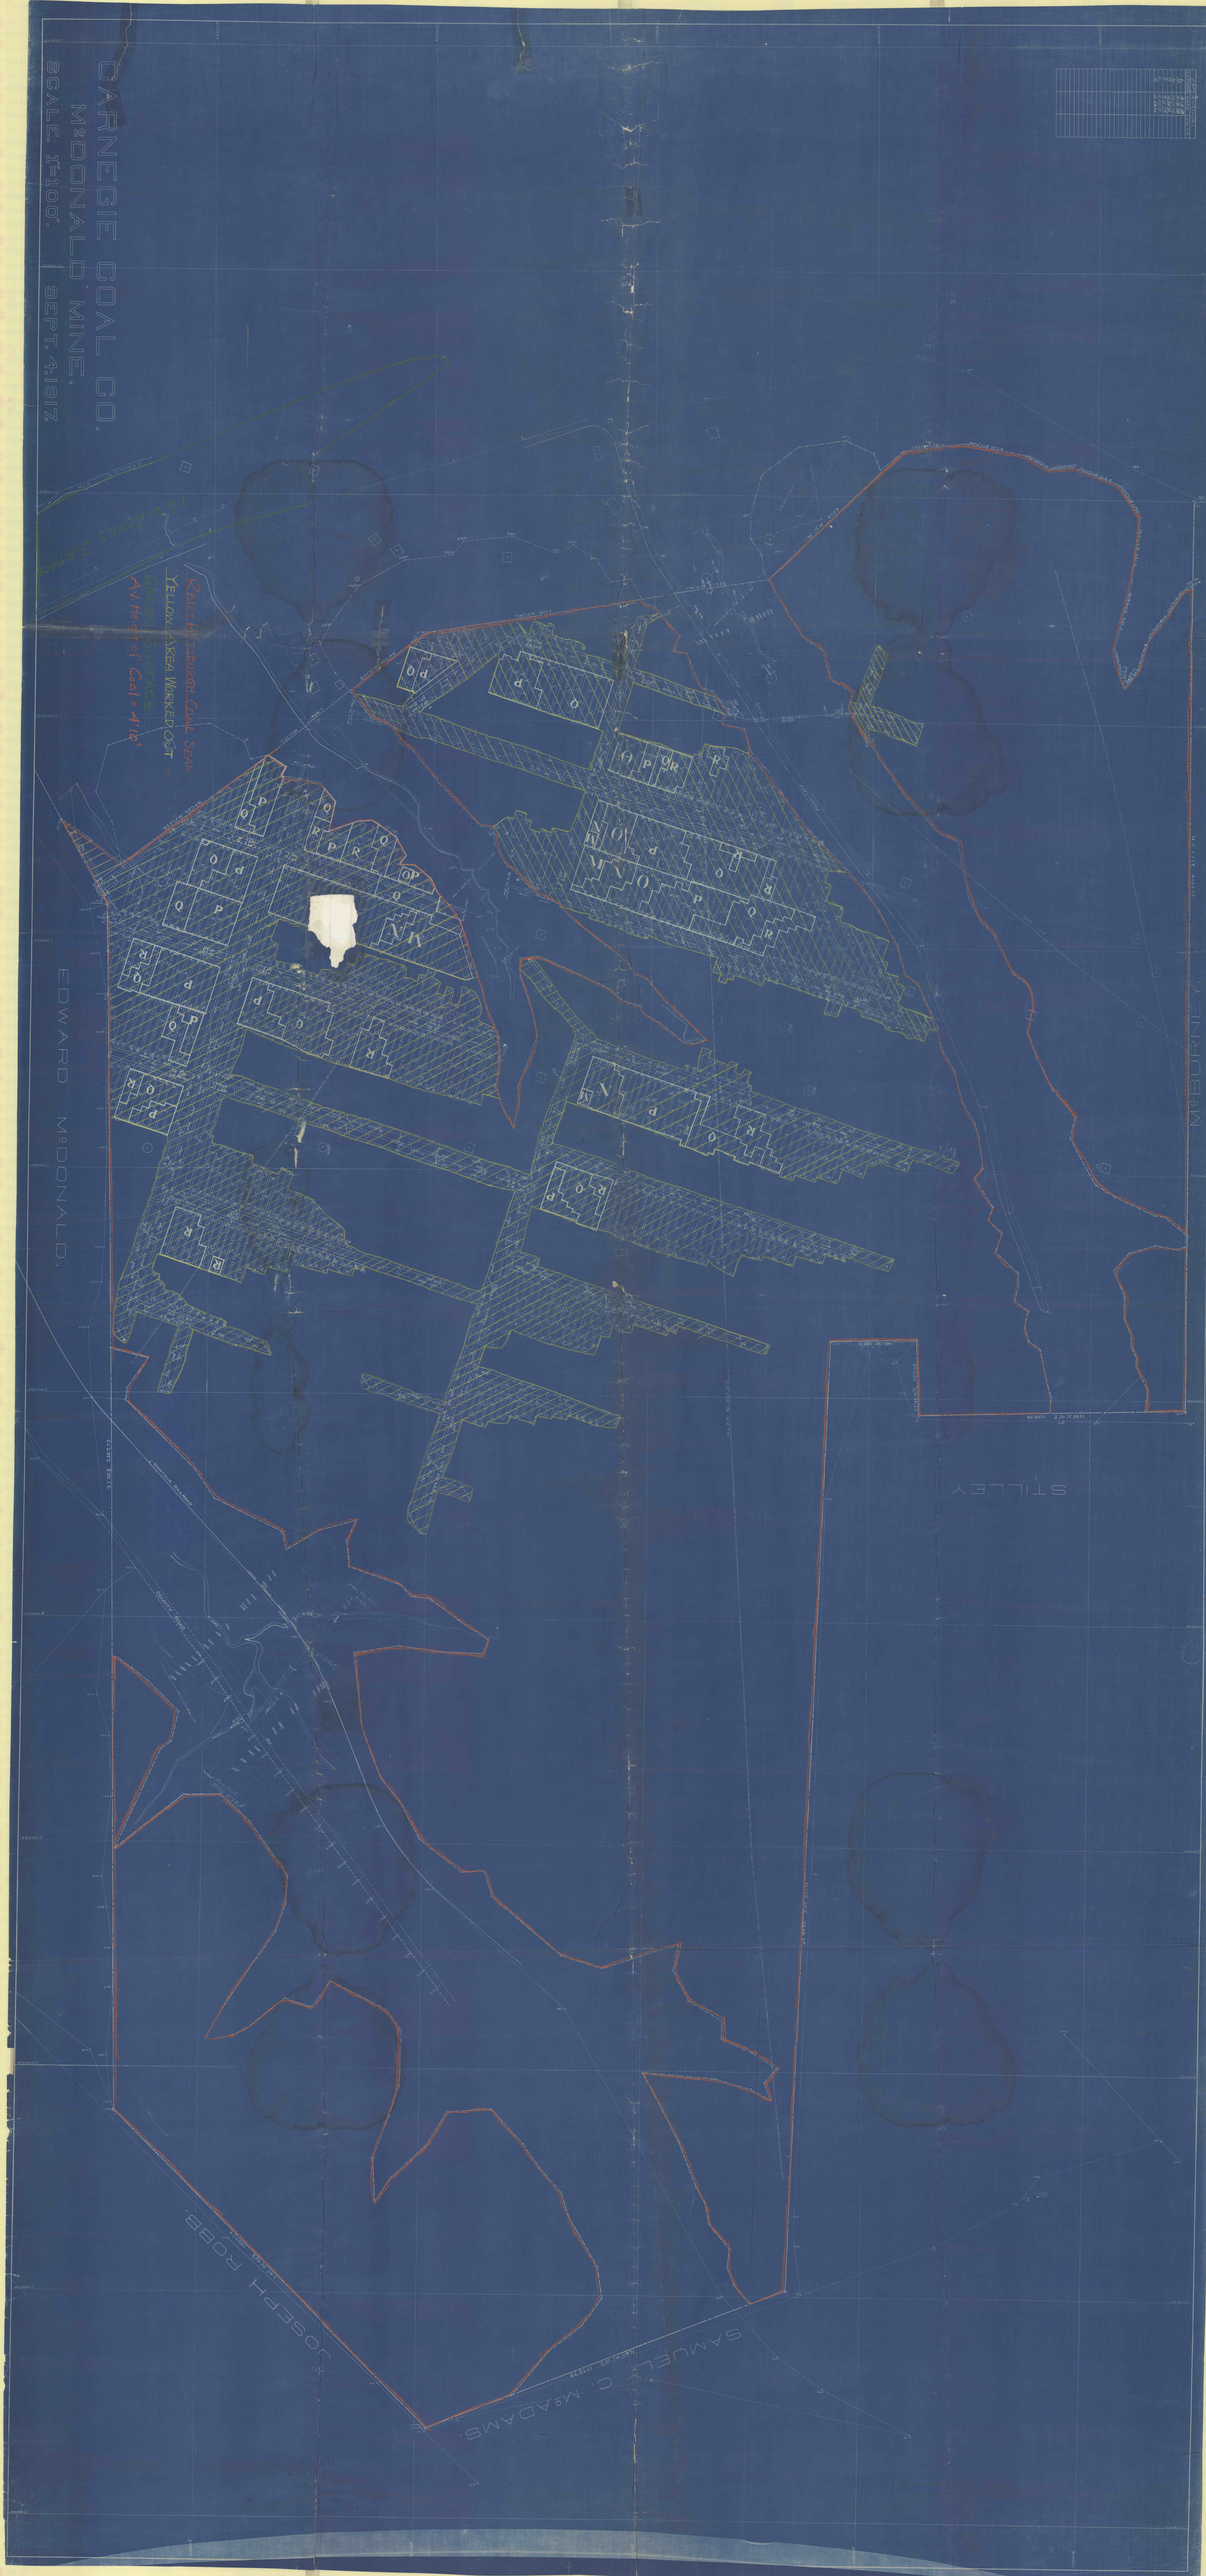
CARNEGIE COAL CO.
McDONALD MINE.
SCALE. 1"=100'.
SEPT. 4, 1917.
RED. Pittsburgh Coal Seam
YELLOW. Area Worked Out
Average Thickness
Av. Height of Coal = 4'0"
EDWARD McDONALD.
McBURNEY
STILLEY
SAMUEL C. McADAMS