


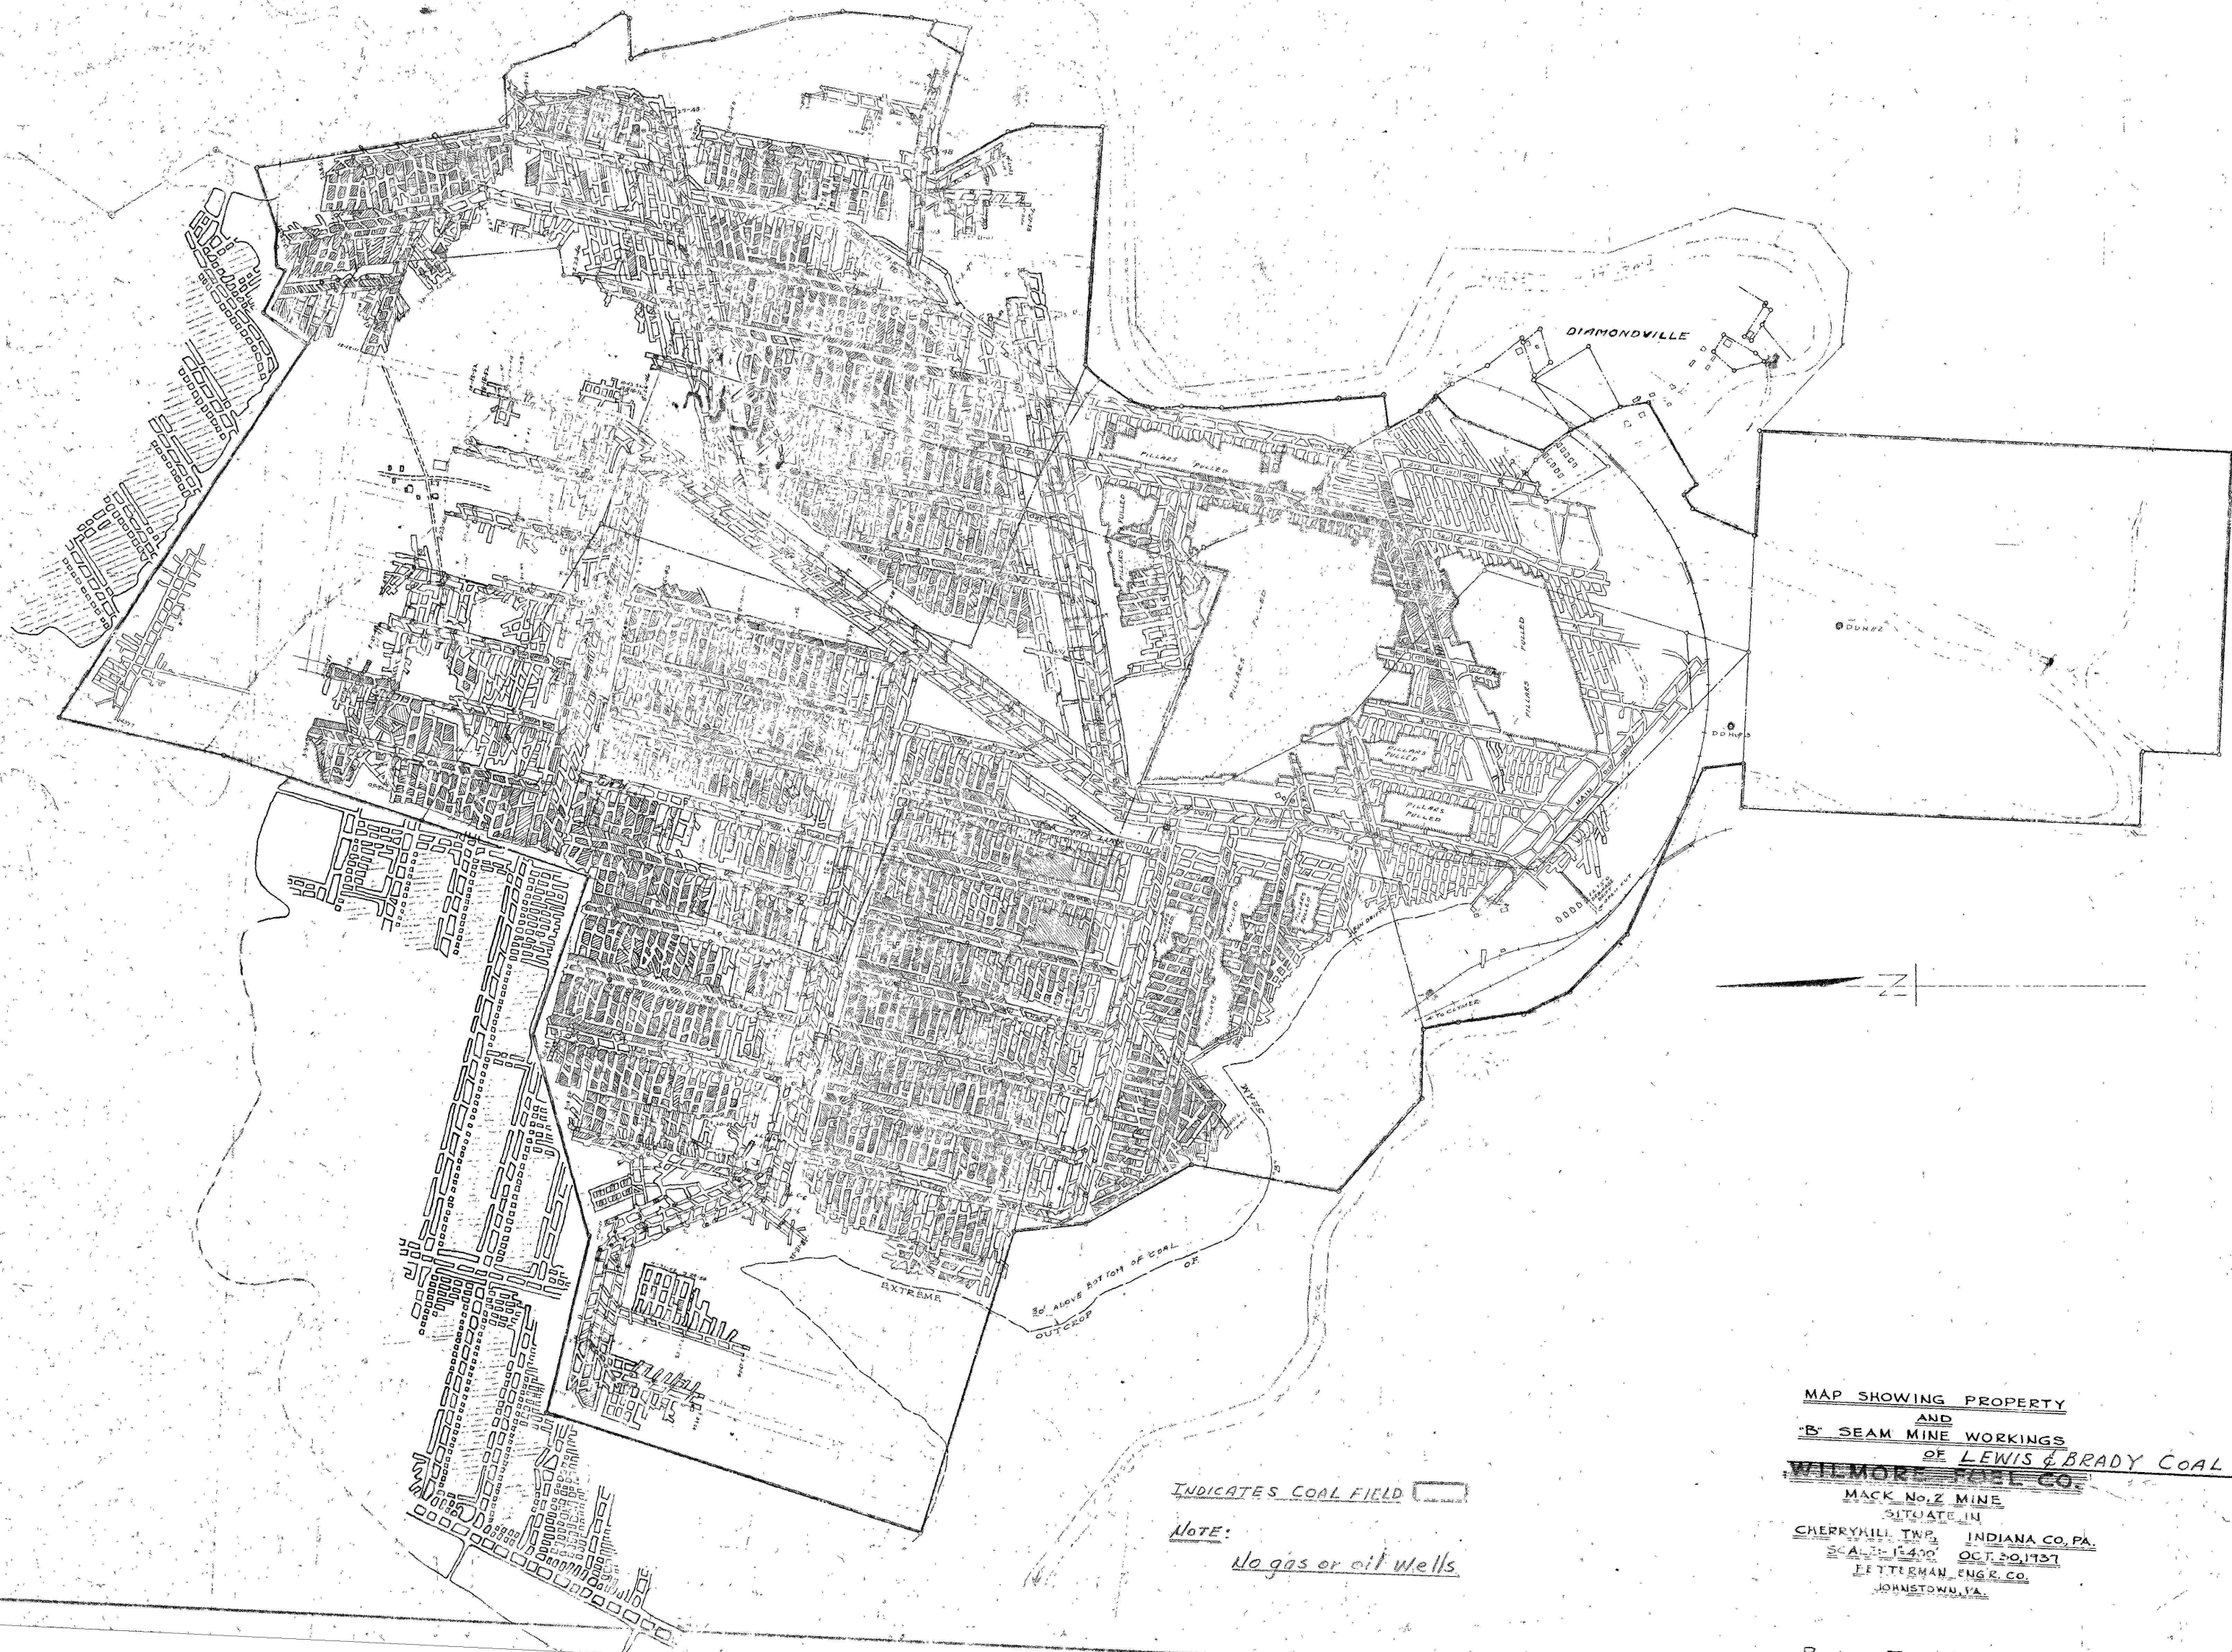

INDICATES COAL FIELD

NOTE:

No gas or oil wells

MAP SHOWING PROPERTY
AND
"B" SEAM MINE WORKINGS
OF LEWIS & BRADY COAL CO.
WILMORE COAL CO.
MACK No. 2 MINE
SITUATE IN
CHERRYHILL TWP. INDIANA CO. PA.
SCALE 1:24,000 OCT. 20, 1937
LETTERMAN ENGR. CO.
JOHNSTOWN, PA.

POSTED TO MAPS 1-1955

Formerly Egypt Coal Co.