


MACK COAL CO.
 N^o 4 MINE
 BRUSH VALLEY TWP
 INDIANA CO. PENNA.
 SCALE 1"=100'
 12-2-44

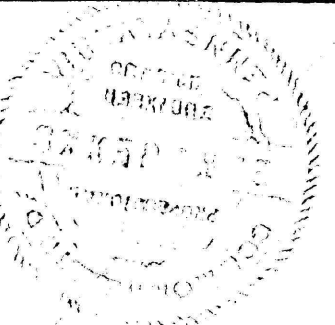


M. STEWART.

E. STEWART.

V. BROWN.

L. R. KEPPLE.

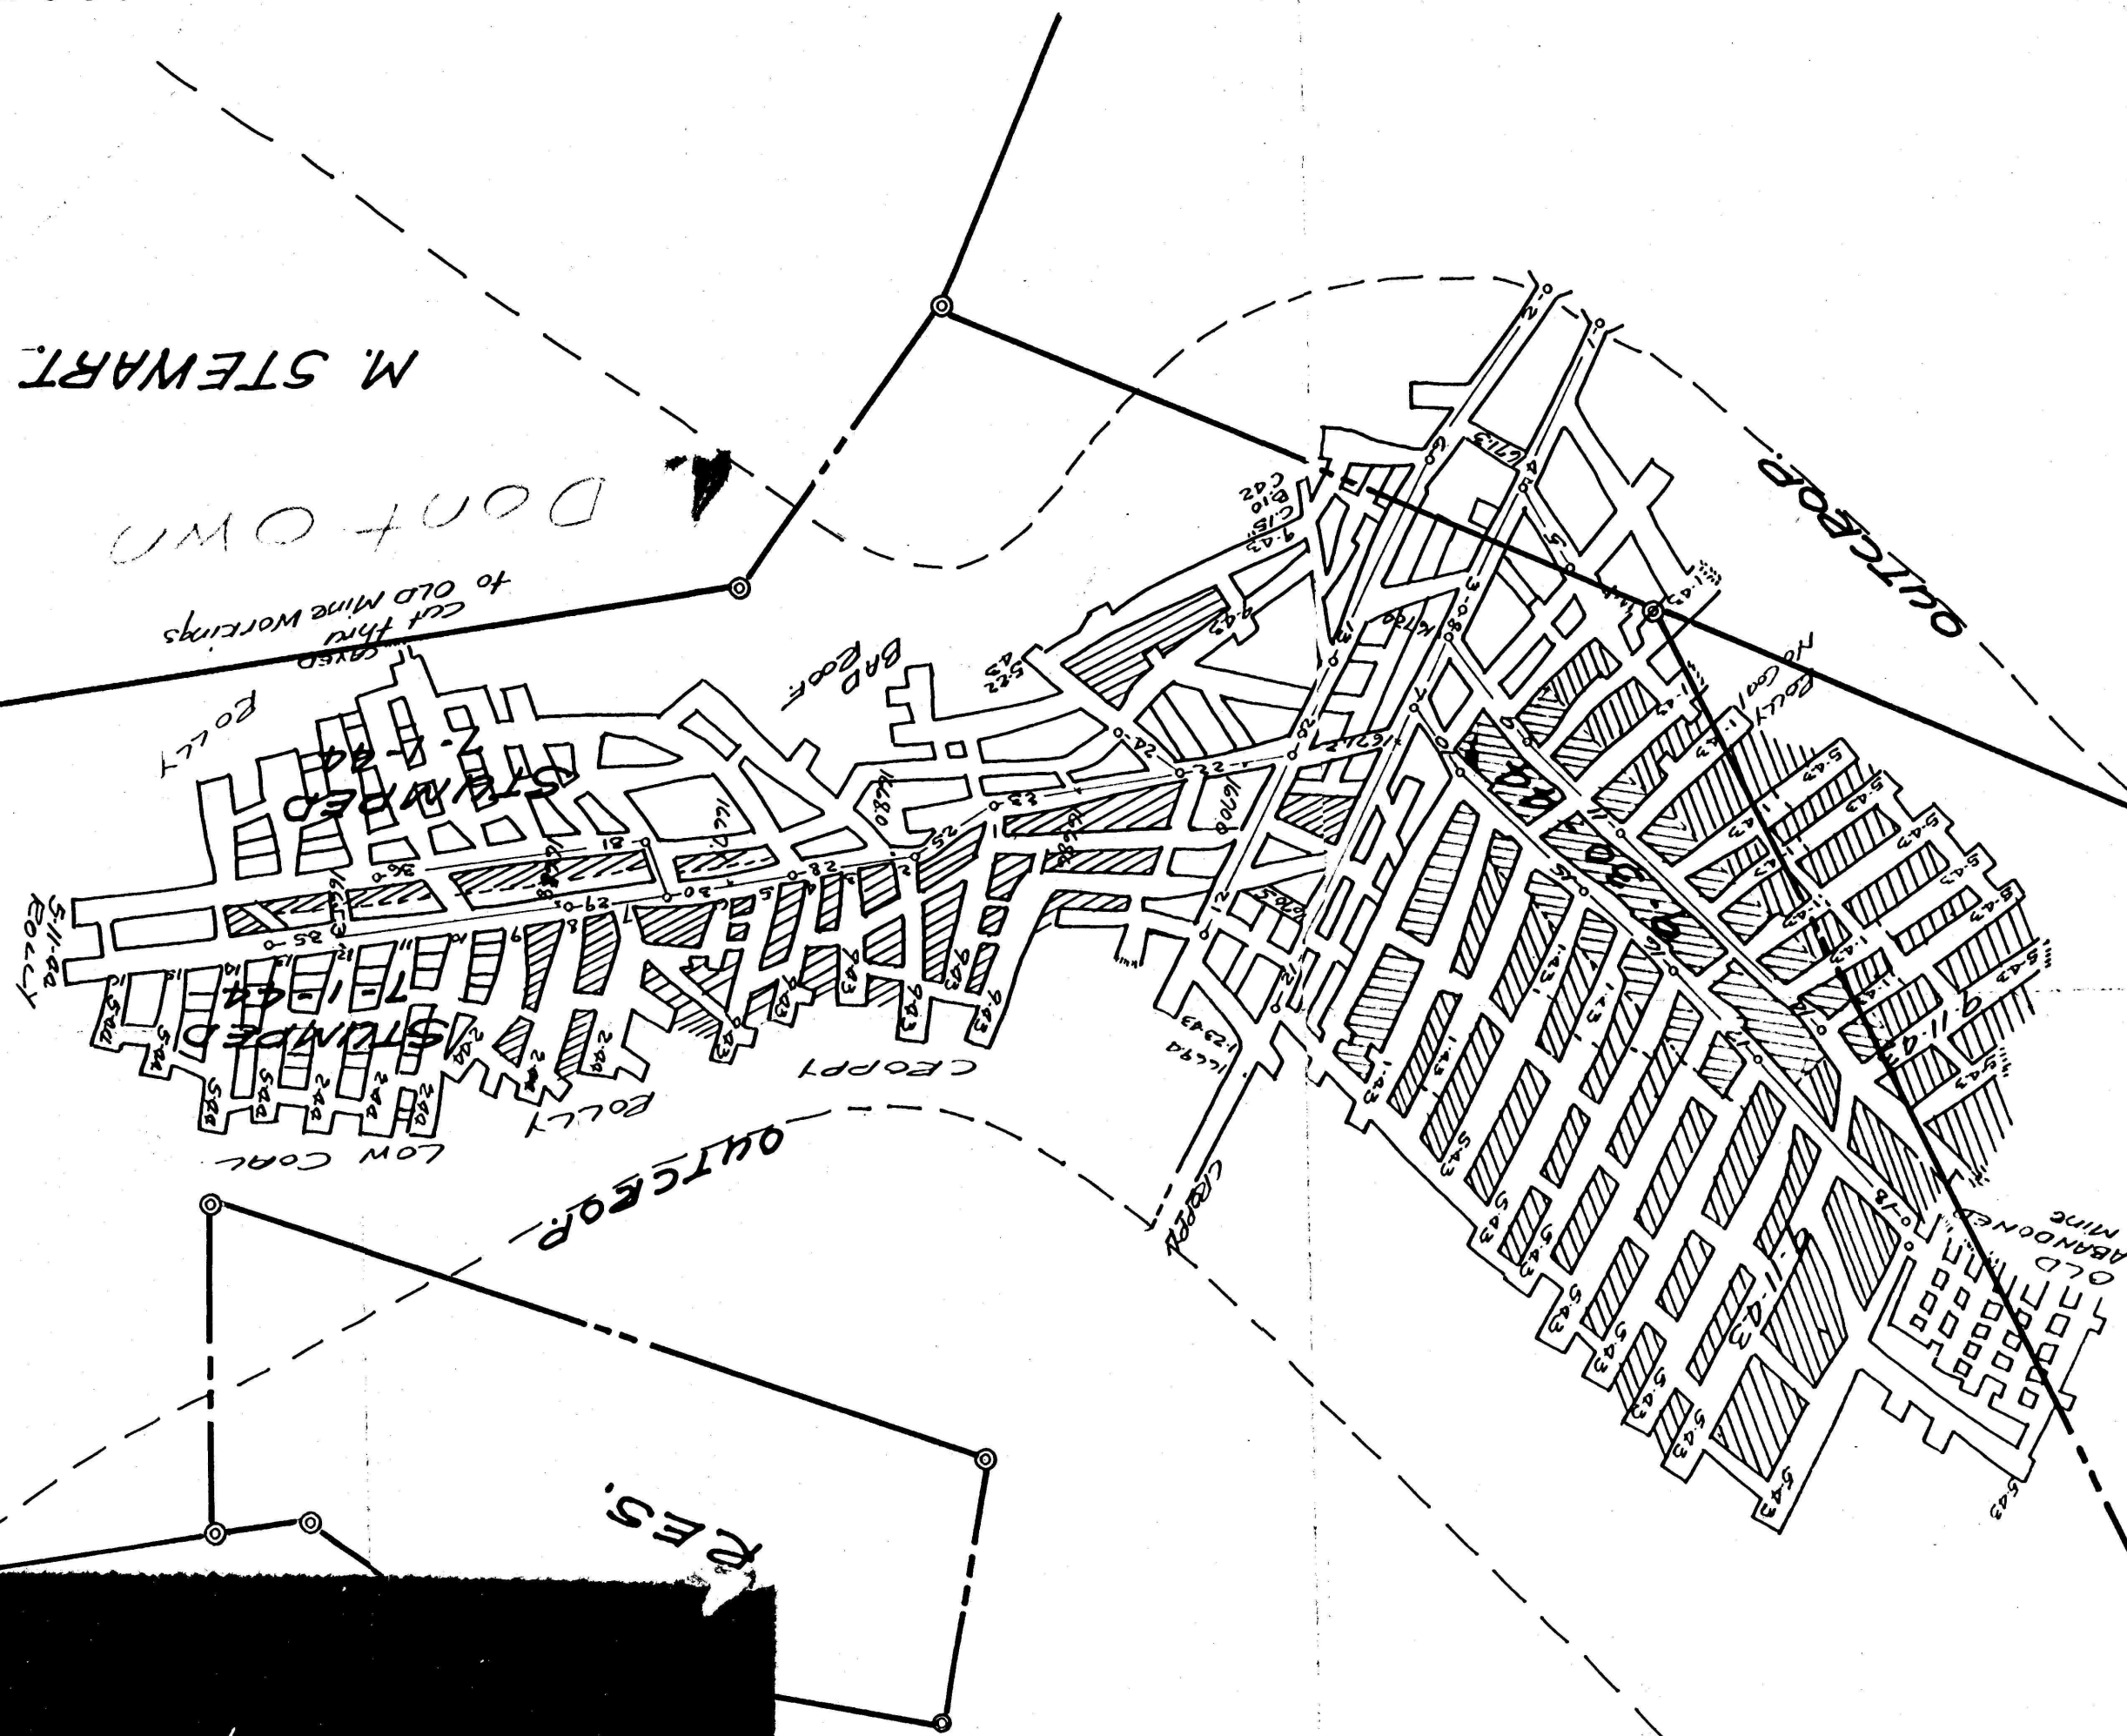

MAP OF ABANDONED MACK # 4 MINE
 MACK COAL COMPANY, HOMER CITY, PENNSYLVANIA.
 This is to certify that this map is a true and correct
 copy of the original map of the Mack # 4 mine, and that
 all the openings, excavations and other markings shown
 are true and correct.
 Signed *L. R. Kepple* Title *Asst. Engineer*
E. R. Kepple