


CHERRY TREE

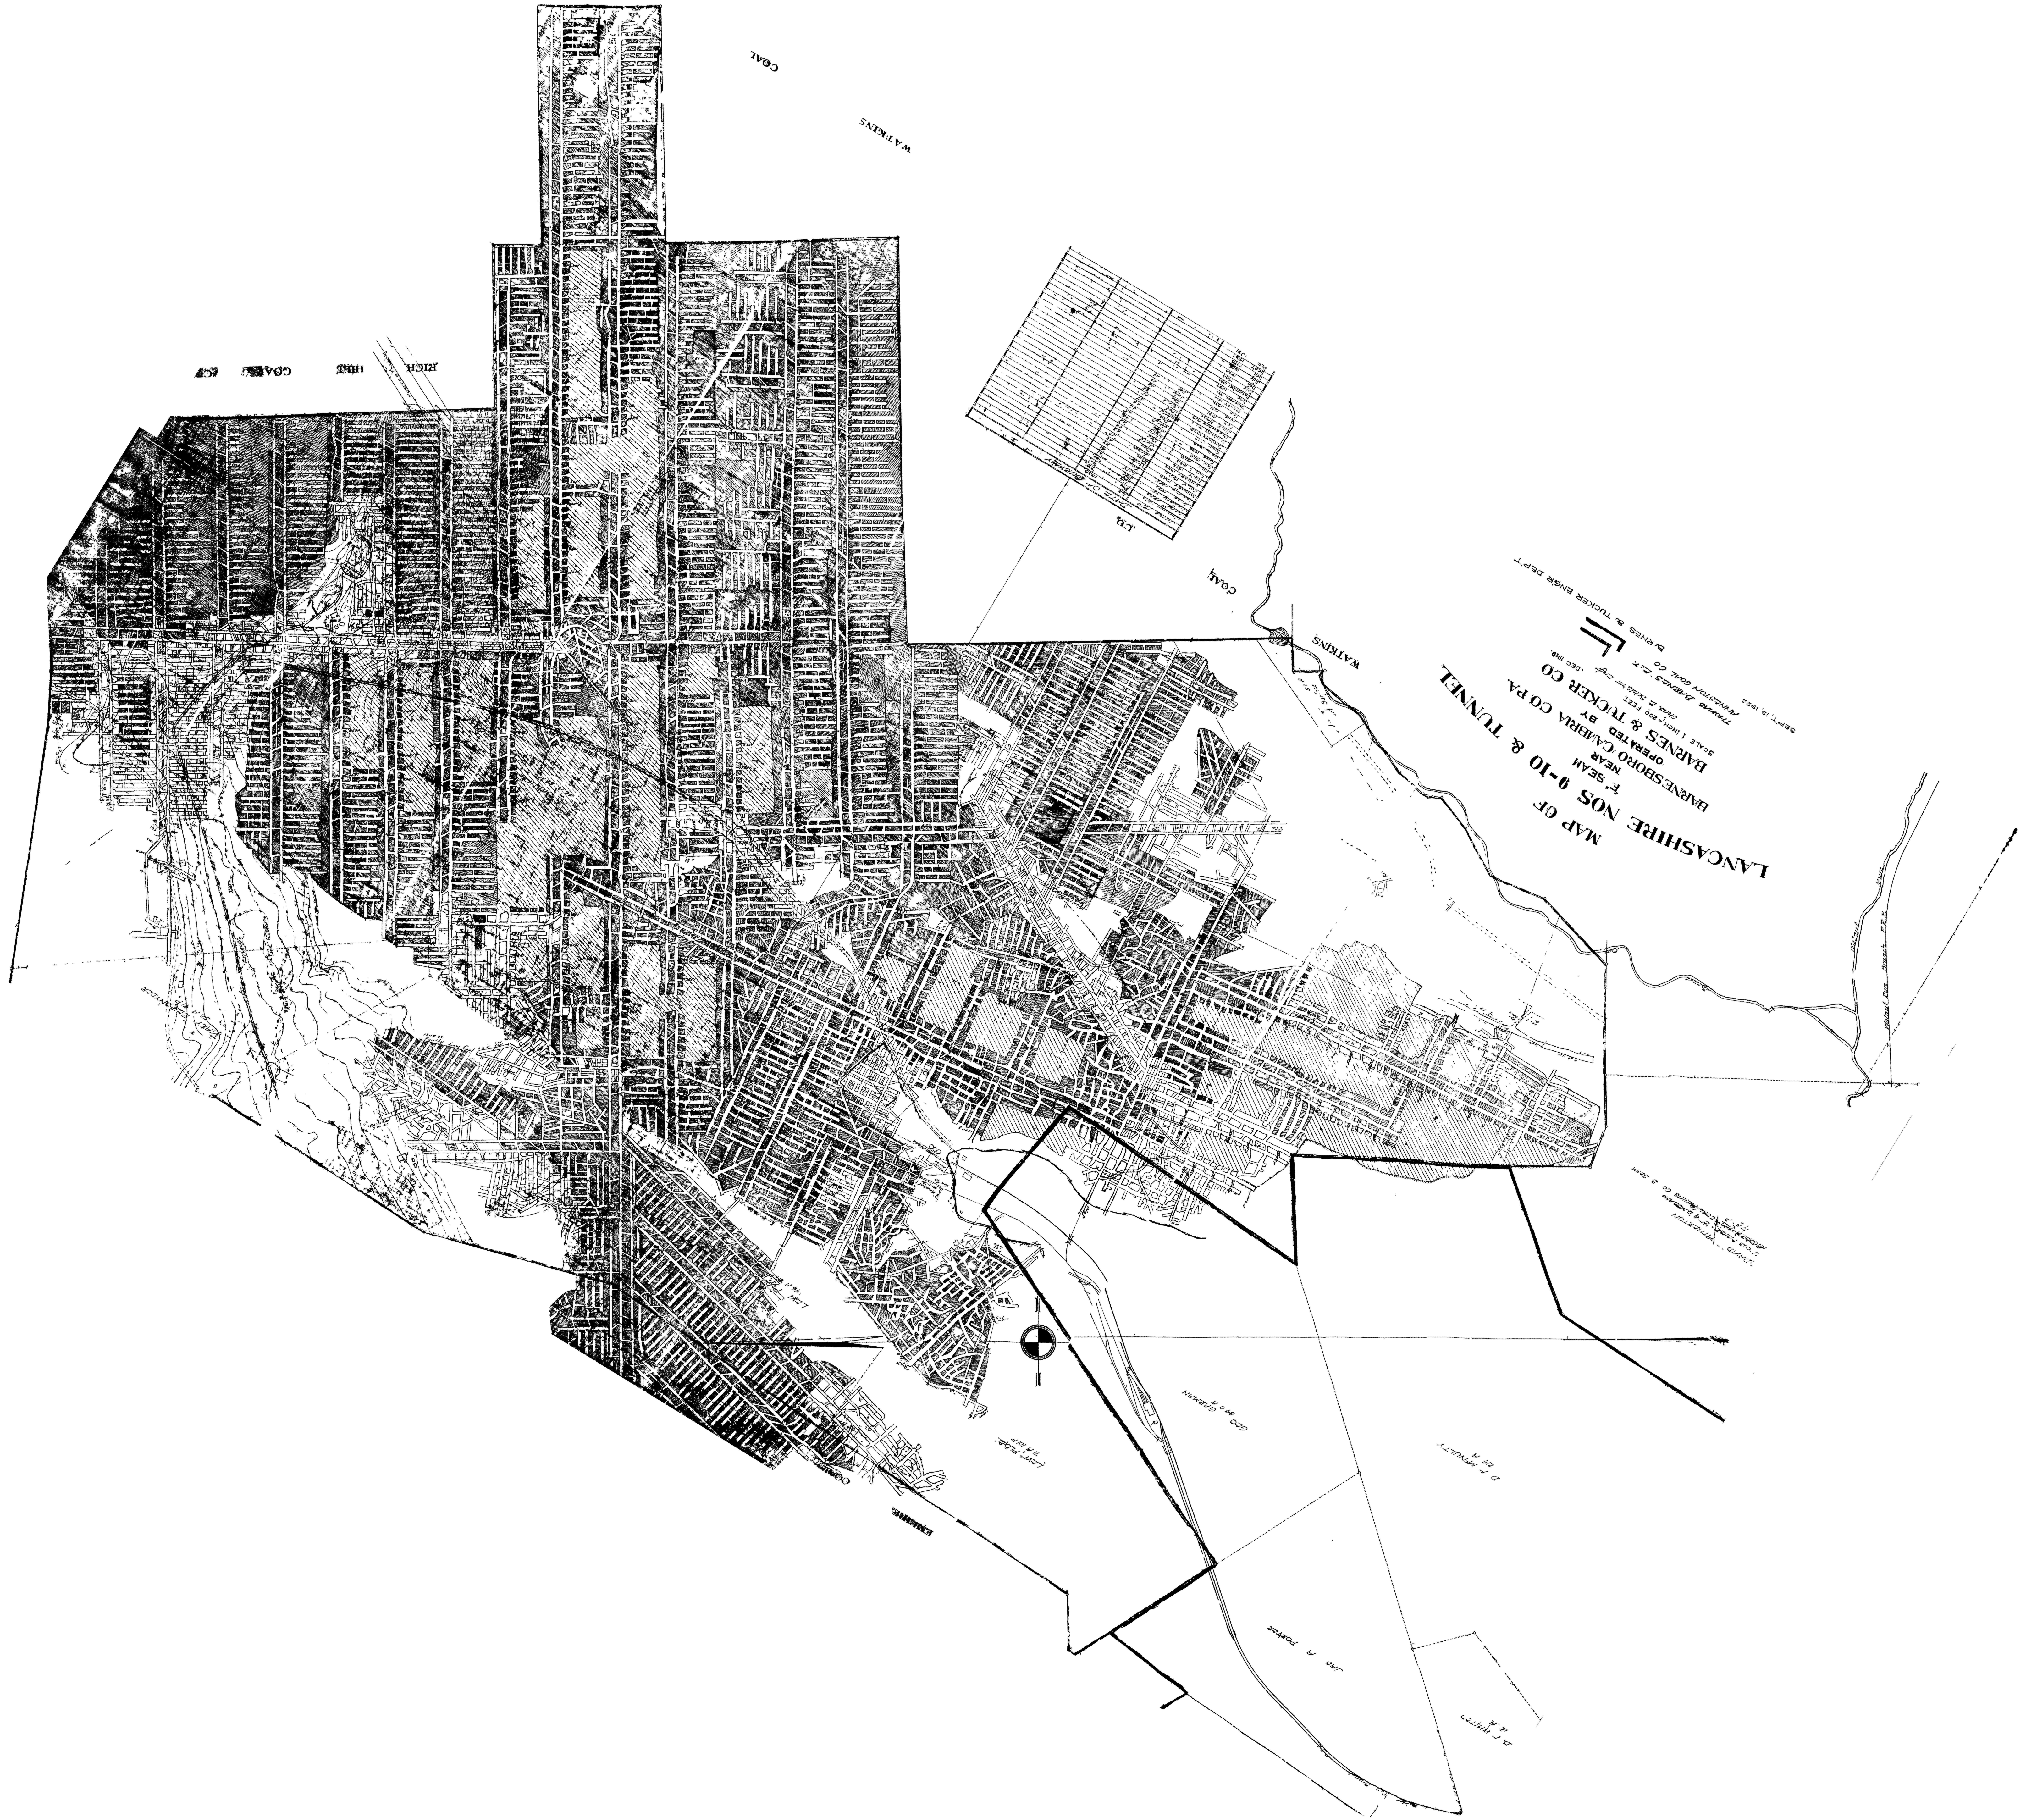

COAL

WATKINS

COAL

COAL

COAL

WATKINS

LANCASHIRE NOS 9-10 & TUNNEL
MAP OF
OPERATED BY
BARNES & TUCKER CO
SCALE 1 inch = 200 feet
BARNES & TUCKER ENGINE DEPT







