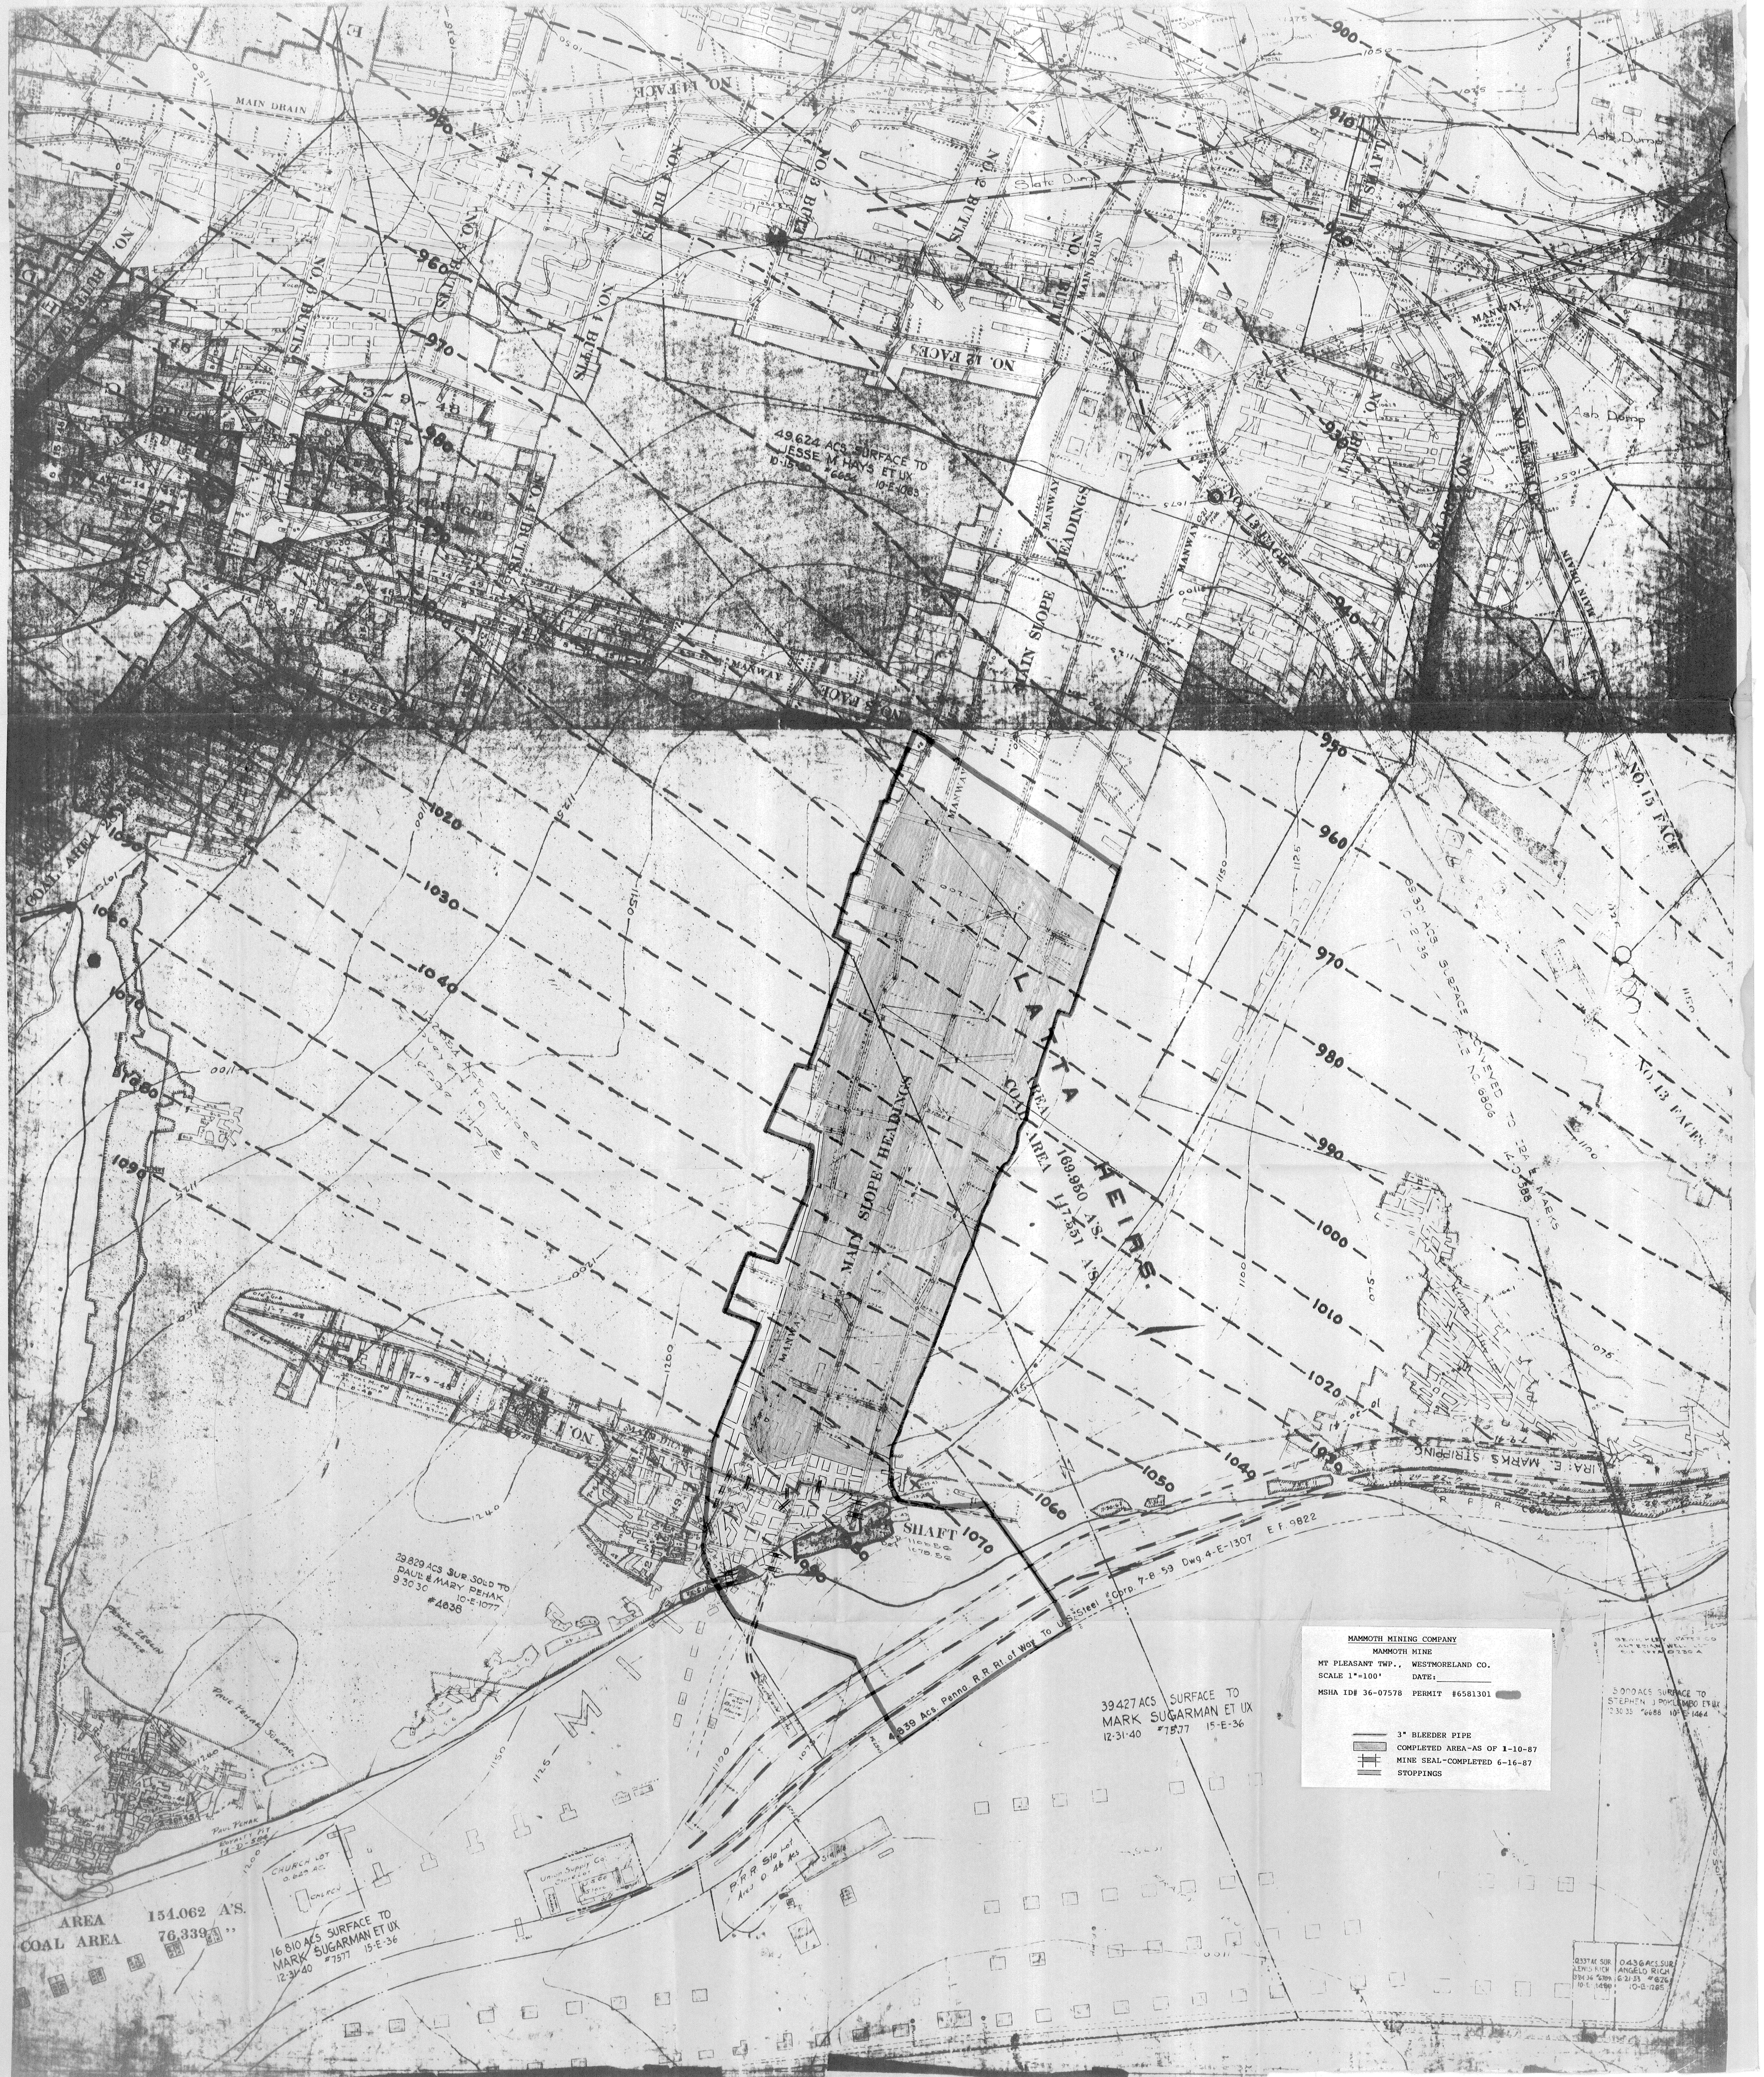
MAIN DRAIN
NO. 14 FACE
NO. 6 BUTTS
NO. 5 BUTTS
NO. 4 BUTTS
NO. 3 BUTT
NO. 2 BUTTS
NO. 1 BUTTS
NO. 12 FACE
NO. 13 FACE
NO. 15 FACE
NO. 5 FACE
SHAFT
Slate Dump
Ash Dump
Ash Dump
MANWAY
MAIN DRAIN
MAIN SLOPE HEADINGS
MAIN SLOPE HEADINGS
MANWAY
3-9-48
7-8-48
1-7-49
49.624 ACS SURFACE TO JESSE M HAYS ET UX 10-15-30 #6654 10-E-1083
LATTA HEIRS
AREA 169.950 A'S.
COAL AREA 117.551 A'S.
89.301 ACS SURFACE CONVEYED TO IRA E. MARKS 10-2-36 FILE NO. 6806 14-C-388
IRA E. MARKS STRIPPING
P. R. R. CO.
SHAFT 1106.56 1075.56
4.839 Acs. Penna. R.R. Rt. of Way To U.S. Steel Corp. 7-8-59 Dwg. 4-E-1307 E.F. 9822
39.427 ACS SURFACE TO MARK SUGARMAN ET UX 12-31-40 #7577 15-E-36
29.629 ACS SUR. SOLD TO PAUL & MARY PEHAK 9.30.30 10-E-1077 #4638
Pehak Zeglin Surface
Paul Pehak Surface
Paul Pehak Royalty Pit 14-D-584
CHURCH LOT 0.649 AC.
CHURCH
Union Supply Co. Store Lot
U.S.Co. Store
P.R.R. Sta Lot Area 0.46 Acs
Engine and Boiler House
16.810 ACS SURFACE TO MARK SUGARMAN ET UX 12-31-40 #7577 15-E-36
AREA 154.062 A'S.
COAL AREA 76.339 "
SEWICKLEY WATER CO ARTESIAN WELL LOT SUR AREA 0.230 A
5.000 ACS SURFACE TO STEPHEN J POKLEMBO ET UX 12.30.35 #6688 10-E-1464
0.337 AC SUR LEWIS RICH 3.24.36 #6709 10-E-1480
0.436 ACS. SUR. ANGELO RICH 6.21.33 #676 10-E-1265
900
910
920
930
940
950
960
970
980
990
1000
1010
1020
1030
1040
1049
1050
1060
1070
1080
1090
1100
1125
1150
1200
1240

MAMMOTH MINING COMPANY

MAMMOTH MINE

MT PLEASANT TWP., WESTMORELAND CO.
SCALE 1"=100' DATE:____________
MSHA ID# 36-07578 PERMIT #6581301 [redacted]

— 3" BLEEDER PIPE
▨ COMPLETED AREA-AS OF 1-10-87
‡ MINE SEAL-COMPLETED 6-16-87
═ STOPPINGS