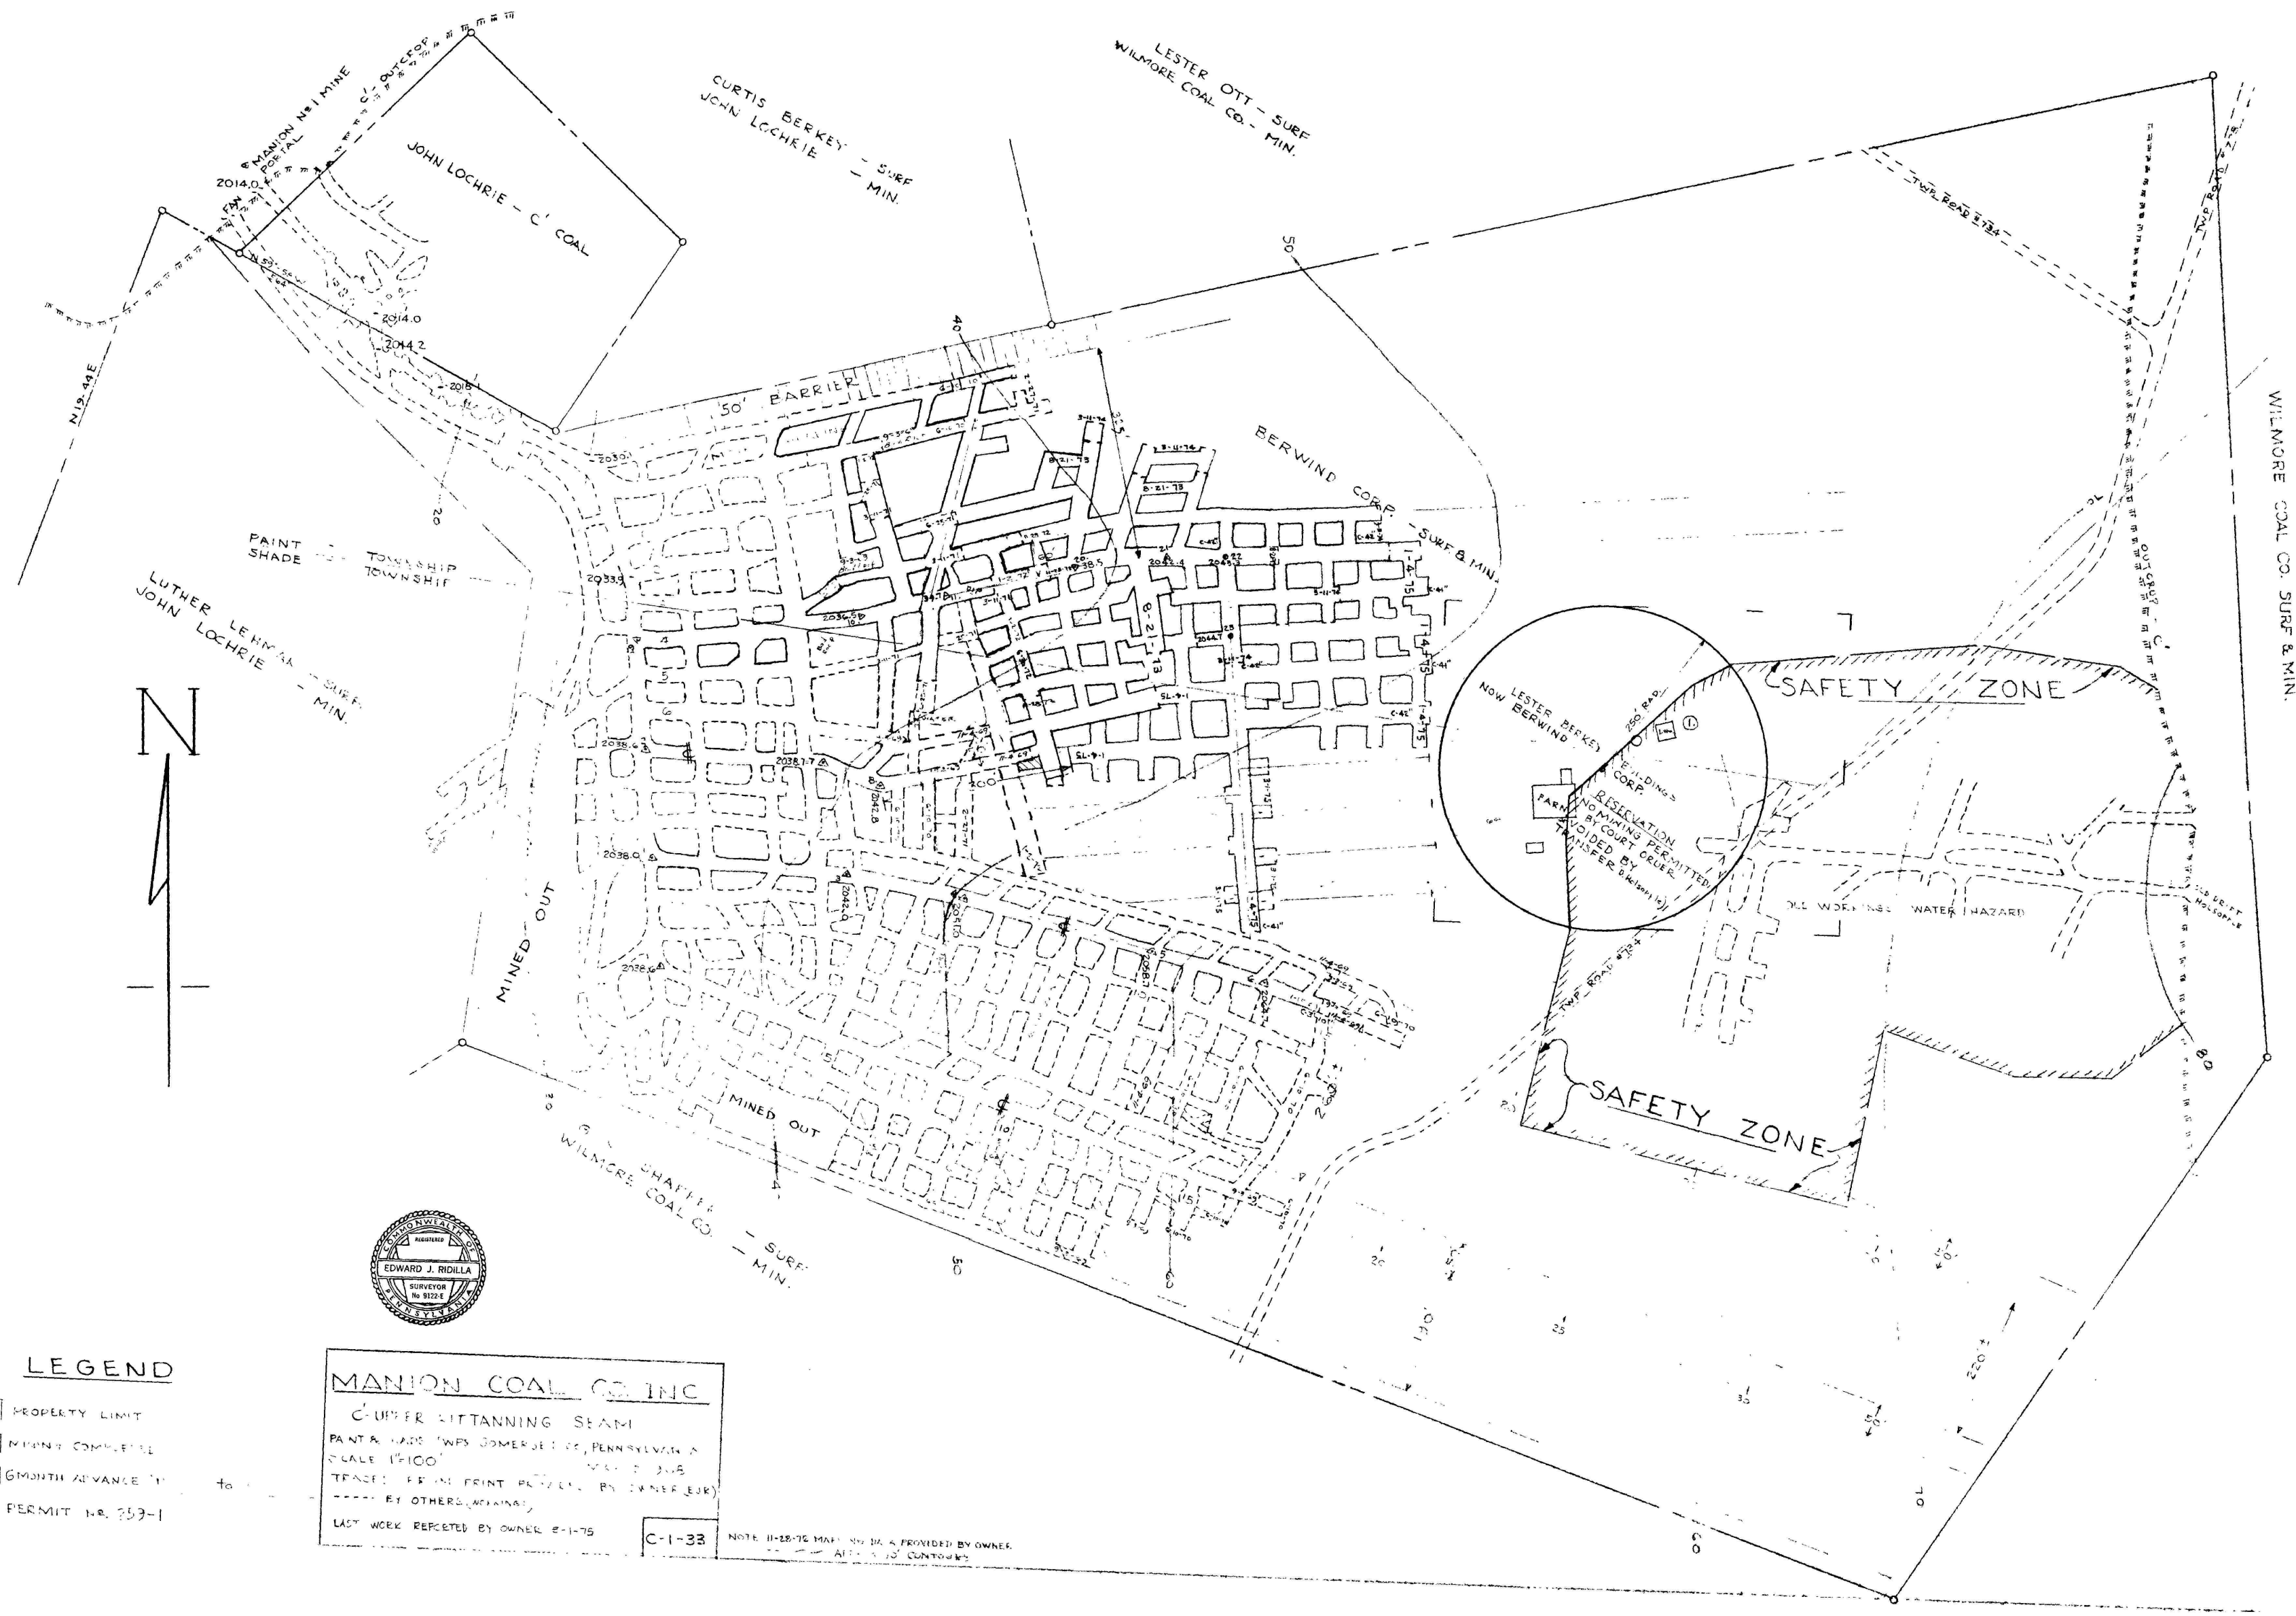


LEGEND

- PROPERTY LIMIT
 - MINING COMPLETE
 - 6 MONTH ADVANCE
- PERMIT NO. 259-1

MANION COAL CO. INC.
SCALE 1"=100'
TRADED FROM PRINT PLATES BY OWNER (EJK)
BY OTHERS (MINING)
LAST WORK REPORTED BY OWNER 2-1-75

C-1-33
NOTE: 11-28-76 MAP NO. 1A PROVIDED BY OWNER.
ALL 1/2" & 1/4" CONTOURS