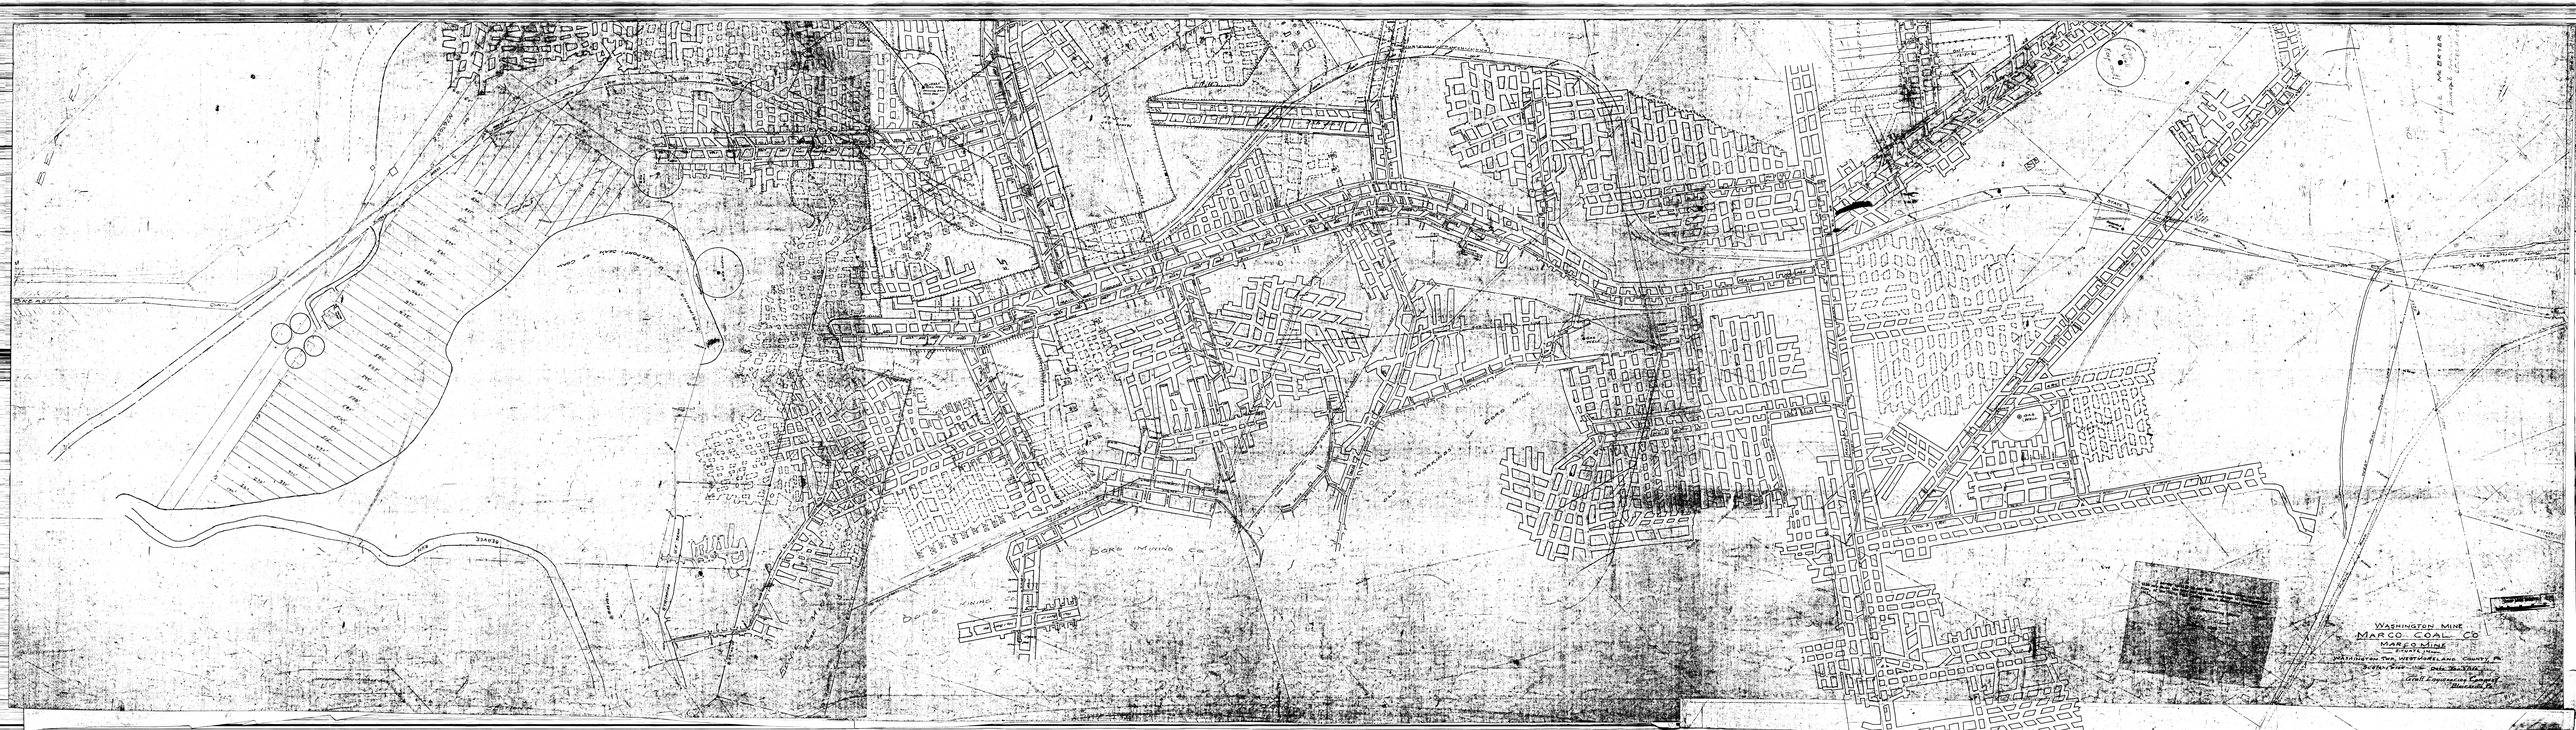
WASHINGTON MINE
MARCO COAL CO
MARCO MINE
WASHINGTON TWP. WESTMORELAND COUNTY, PA.
SCALE 1" = 200'
DATE
Bore Mining Co