


MATCH TO SHEET 5

VENTILATION LEGEND

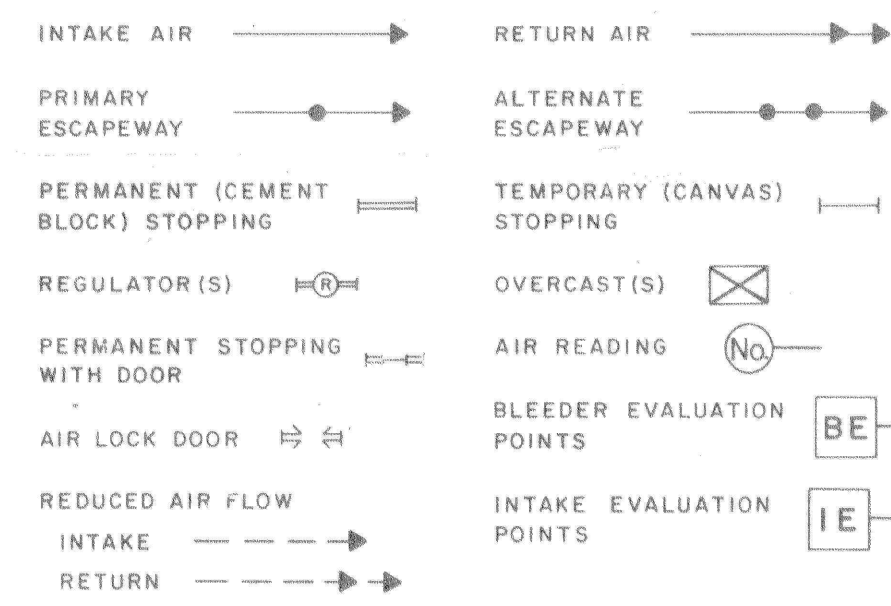


—AIR READINGS—

1. 50,460 C.F.M. Methane 0.00 %

2. 49,500 C.F.M.

SUBSIDENCE LEGEND

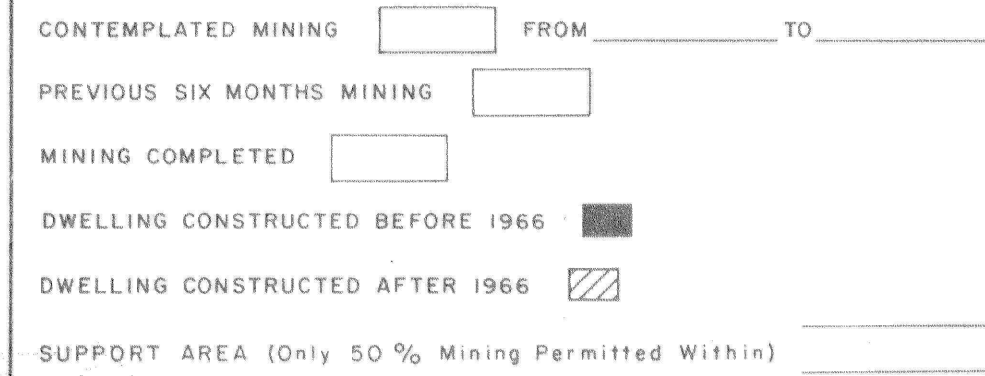

APPROVAL LEGEND

Valley Coal Company
COMPANY

Mardis Run No. 2 Mine
NAME OF MINE

Mine Seal Design and Location
SUBJECT OF APPROVAL

David Dehove 12/17/84
DATE
COMPANY REPRESENTATIVE

John E. Butcher 12/18/84
DATE
ENGINEER

Walter J. Umell 1-9-85
DATE
COMMISSIONER, OFFICE OF DEEP MINE SAFETY
DEPARTMENT OF ENVIRONMENTAL RESOURCES

Richard M. Smith 1-9-85
DATE
DIRECTOR, BITUMINOUS DEEP MINE SAFETY
DEPARTMENT OF ENVIRONMENTAL RESOURCES

John A. Swack 1-4-1985
DATE
DISTRICT MINE INSPECTOR
DEPARTMENT OF ENVIRONMENTAL RESOURCES

SURFACE:
EDWIN M. CLARK, JR. and
ALAN HOLSINGER
MINERAL:
MANOR REAL ESTATE & COAL CO.

NOTE: PIT TO BE COMPACTED WITH IMPERVIOUS CLAY, BACK-FILLED AND PLANTED AFTER SEALS HAVE BEEN INSTALLED. FAN, HOUSING AND CANOPIES TO BE REMOVED BEFORE BACKFILLING.

Main (Primary) Fan
Sta. 14
Proposed Mine Seal Locations
Sta. 15
Bench Mark Elev.: 1821.77

SURFACE
La CARTE ENTERPRISES, INC.
MINERAL:
MANOR REAL ESTATE & COAL CO.

SURFACE:
HARRY C. and MAUDE M. GRAHAM
MINERAL:
MANOR REAL ESTATE & COAL CO.

SURFACE:
EMILY JOHNSON
MINERAL:
PENN CENTRAL CORP.

SURFACE:
La CARTE ENTERPRISES, INC.
MINERAL:
PENN CENTRAL CORP.

—FINAL MAP—
EXHIBIT "B"

PREPARED FOR
VALLEY COAL COMPANY

MARDIS RUN NO. 2 MINE
LOWER FREEPORT COAL SEAM

SITUATE
BUFFINGTON TWP., INDIANA CO.,
PENNSYLVANIA

SCALE: 1" = 100'

DECEMBER 6, 1984

PREPARED BY
PENN-BRITANNICA CONSULTANTS
BOX "E", ARMAGH, PA. 15920

SHEET 3 OF 8

#1713
12-14-84
C.C.

MATCH TO SHEET 1

MATCH TO SHEET 4