



MATCH TO SHEET 5

VENTILATION LEGEND

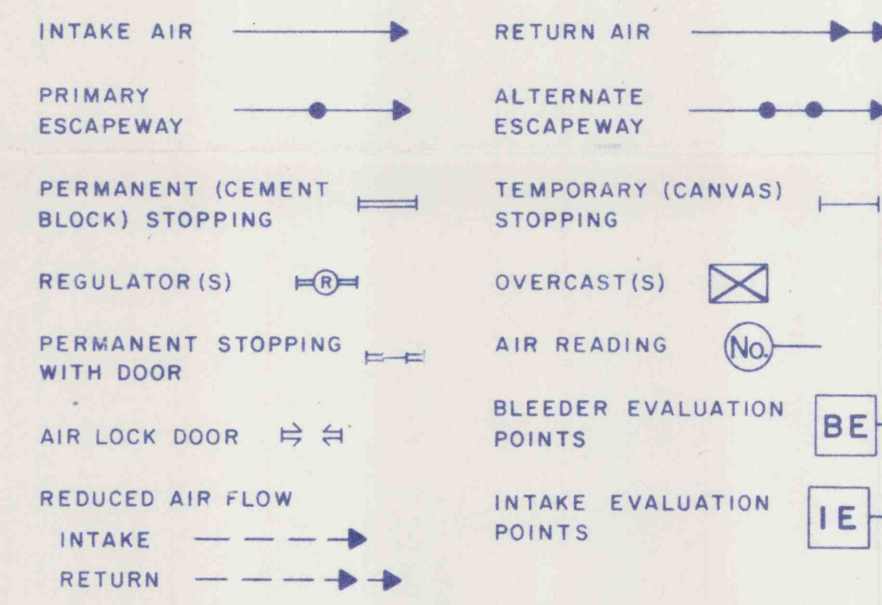

AIR READINGS—
1. 50,460 C.F.M. Methane 0.00 %
2. 49,500 C.F.M.

SUBSIDENCE LEGEND

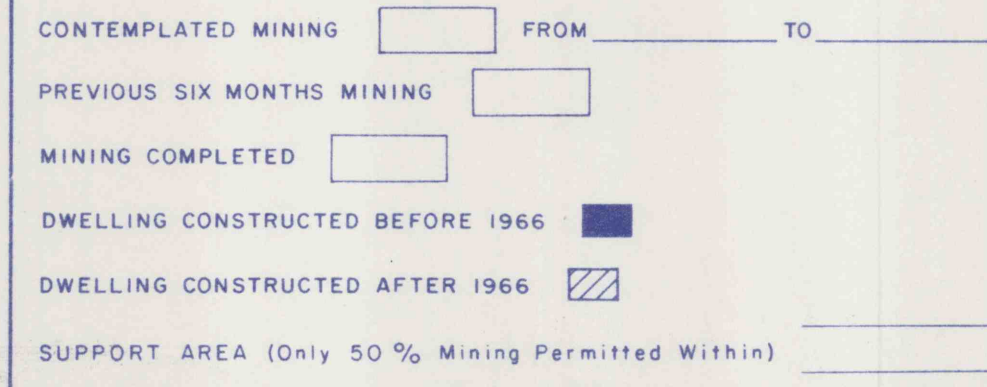

APPROVAL LEGEND

Valley Coal Company
COMPANY

Mardis Run No. 2 Mine
NAME OF MINE

Mine Seal Design and Location
SUBJECT OF APPROVAL

David Dehovic 12/17/84
COMPANY REPRESENTATIVE DATE

John E. Butcher 12/18/84
ENGINEER DATE


Walter J. Donnell 1-9-85
COMMISSIONER, OFFICE OF DEEP MINE SAFETY
DEPARTMENT OF ENVIRONMENTAL RESOURCES DATE

Richard Murphy 1-9-85
DIRECTOR, BITUMINOUS DEEP MINE SAFETY
DEPARTMENT OF ENVIRONMENTAL RESOURCES DATE

John A. Swack 1-4-1985
DISTRICT MINE INSPECTOR
DEPARTMENT OF ENVIRONMENTAL RESOURCES DATE

7	8
5	6
3	4
1	2

SHEET INDEX

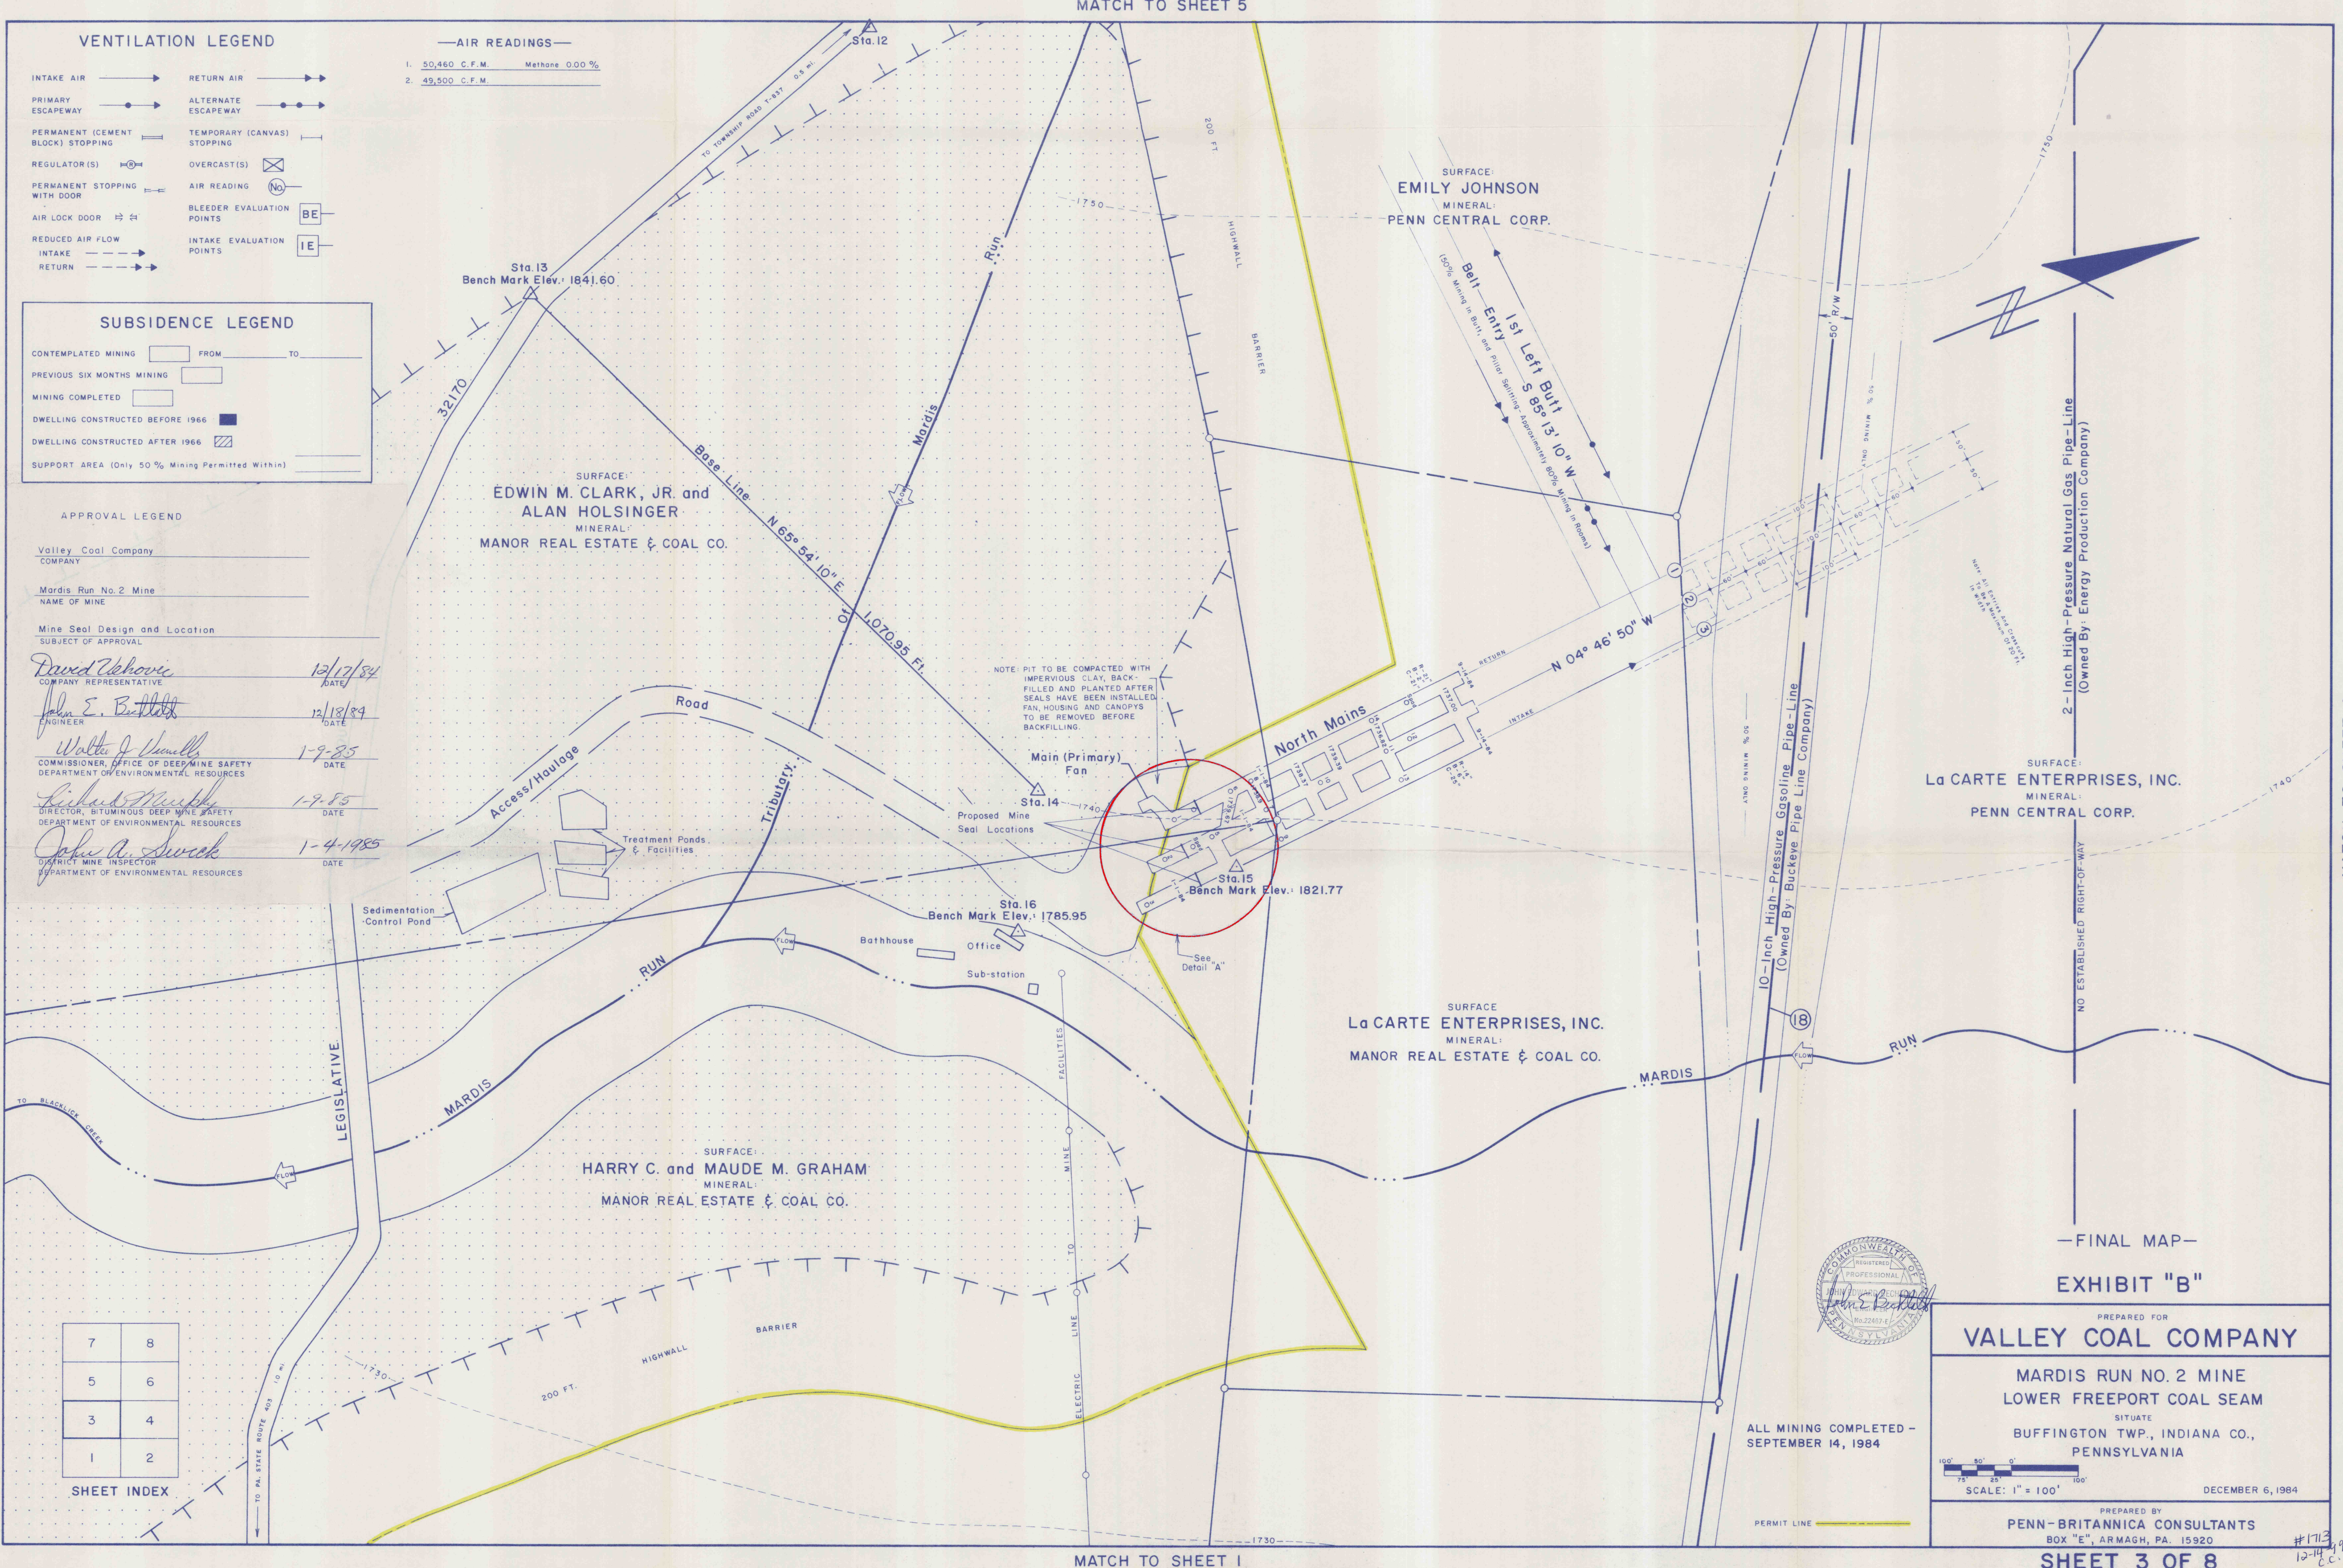

—FINAL MAP—
EXHIBIT "B"

PREPARED FOR
VALLEY COAL COMPANY

MARDIS RUN NO. 2 MINE
LOWER FREEPORT COAL SEAM

SITUATE
BUFFINGTON TWP., INDIANA CO.,
PENNSYLVANIA

ALL MINING COMPLETED -
SEPTEMBER 14, 1984

SCALE: 1" = 100'

DECEMBER 6, 1984

PREPARED BY
PENN-BRITANNICA CONSULTANTS
BOX "E", ARMAGH, PA. 15920

SHEET 3 OF 8

MATCH TO SHEET 1

MATCH TO SHEET 4