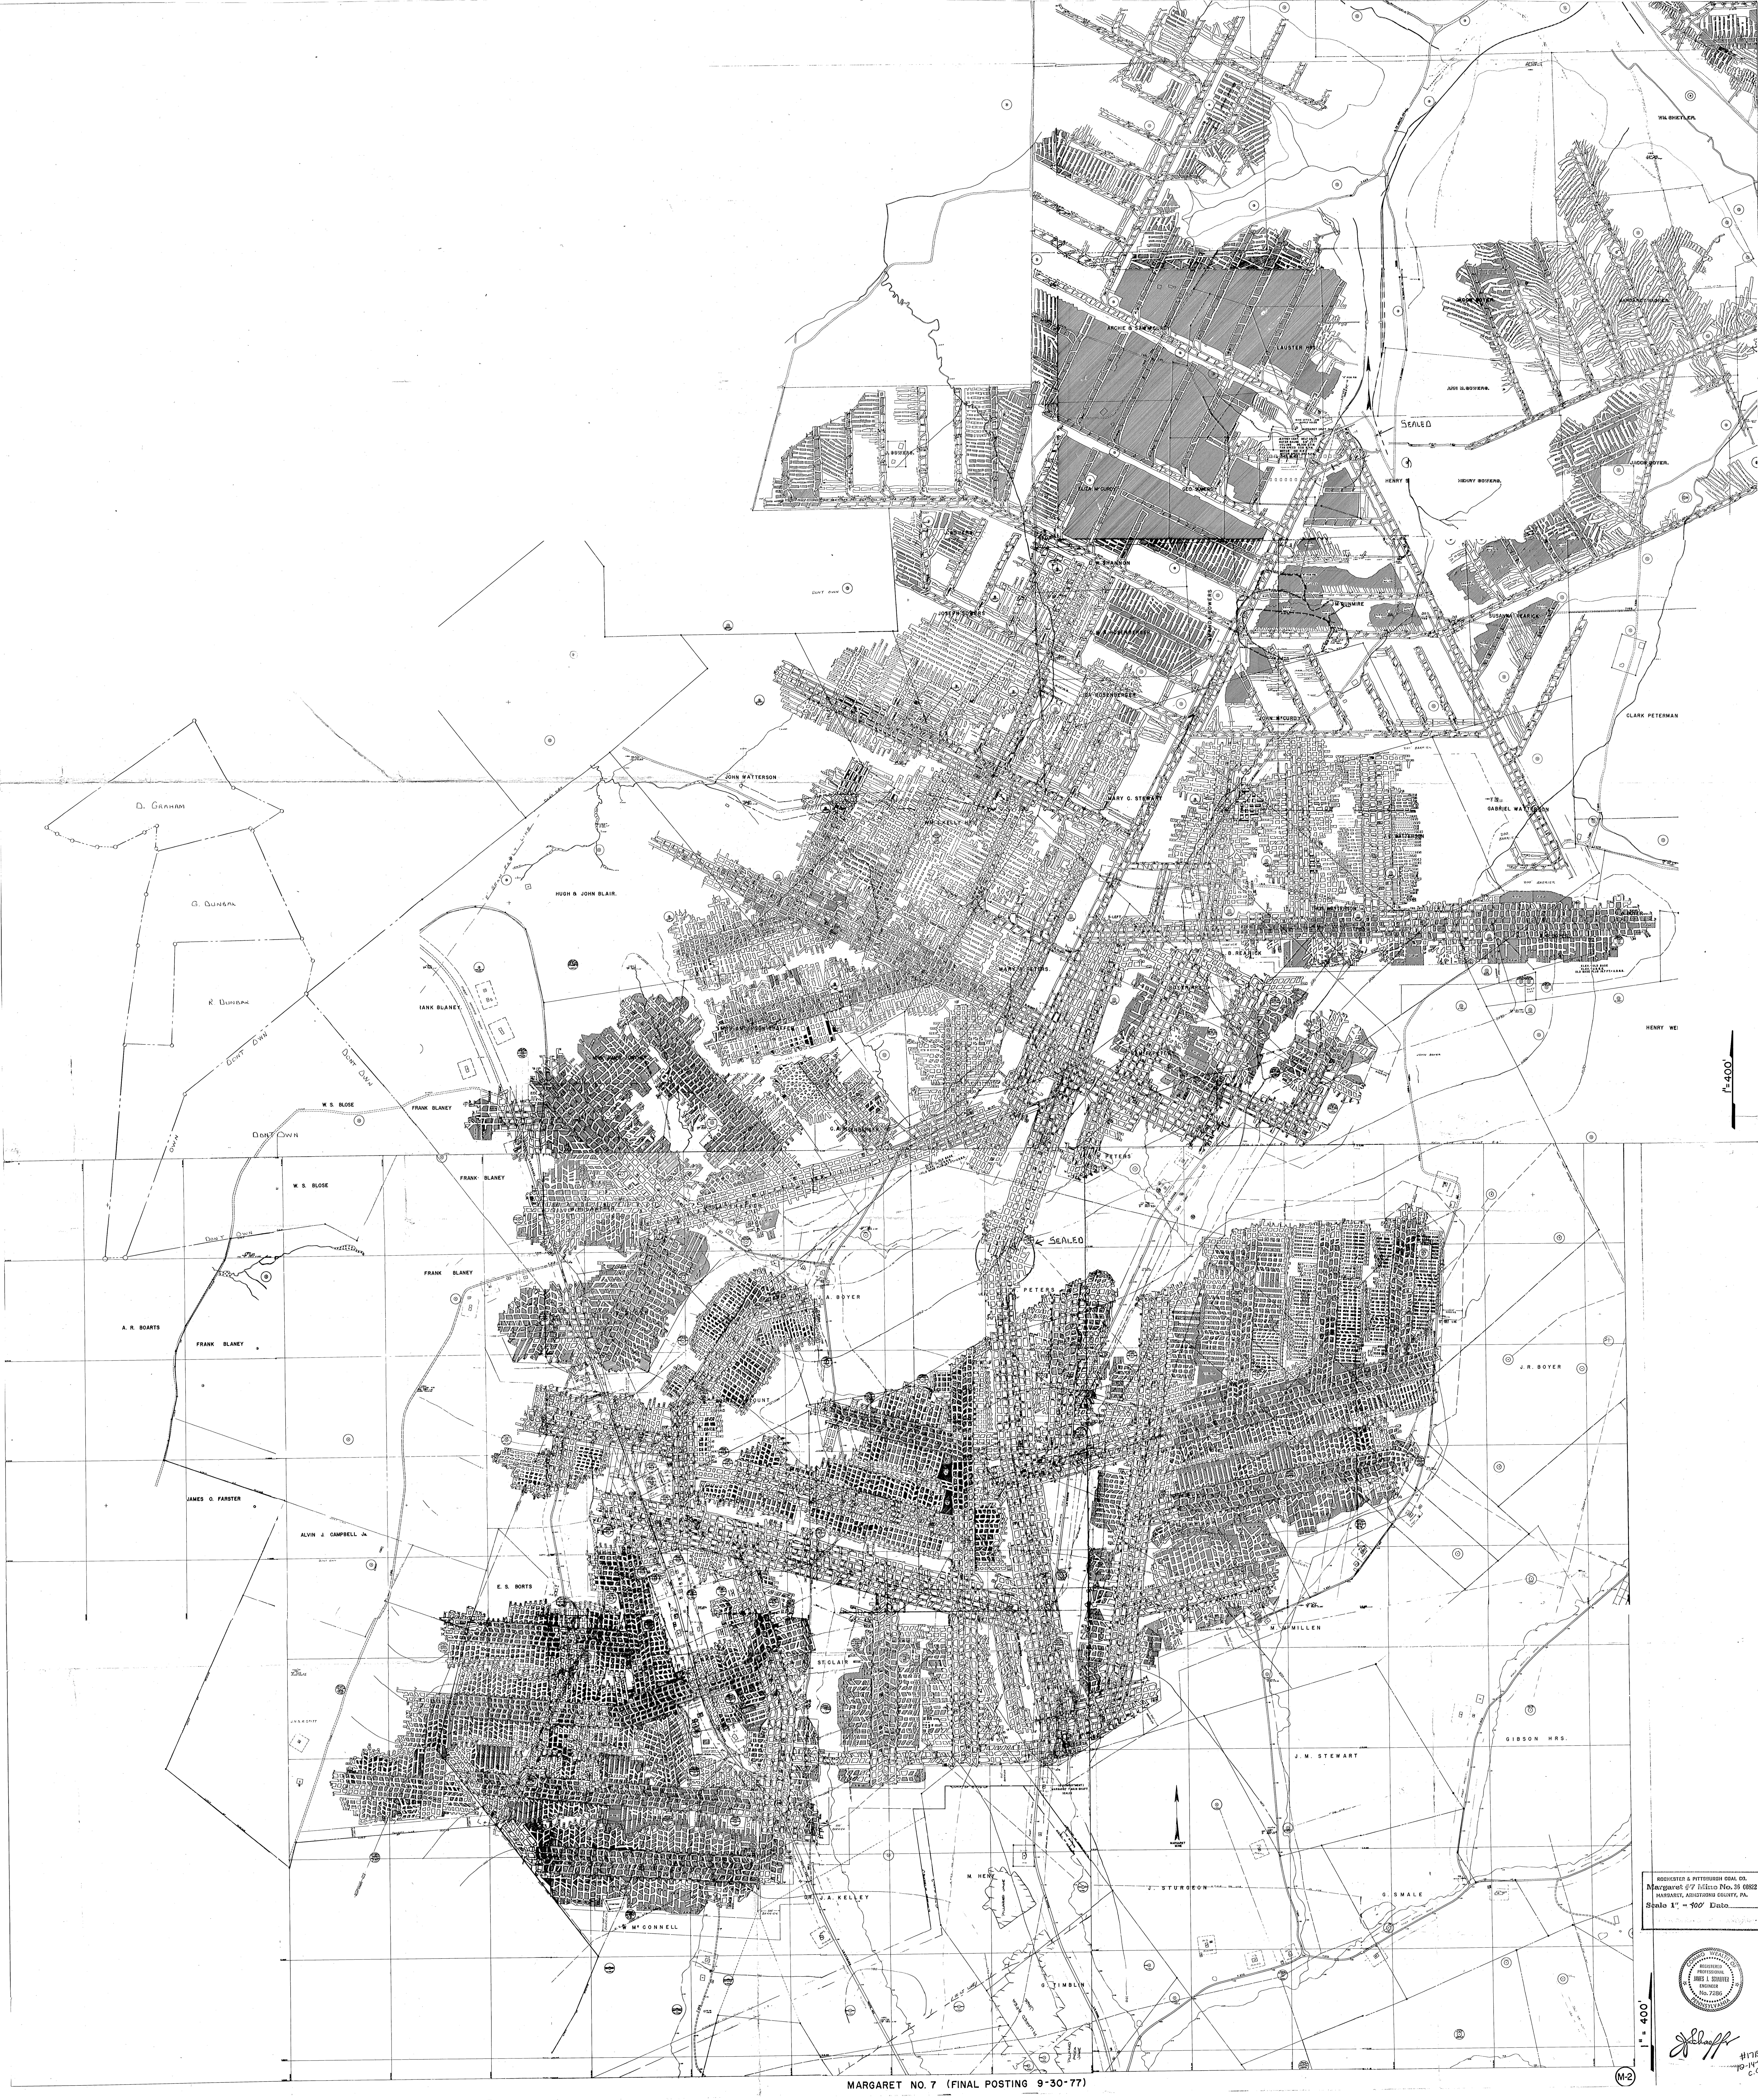
WM. SHETLER
JACOB BOYER
MARGARET HOOKER
ANN M. BOWERS
JACOB BOYER
HENRY S
HENRY BOWERS
SEALED
ARCHIE & SAM McCURDY
LAUSTER HRS.
MINE OFFICE AND SUPPLY HOUSE
MARGARET DRIFT FAN
JEFFREY CENT. BELT DRIVE
ELIZA McCURDY
GEO. SOWERS
J. SOWERS
J. SOWERS
U. W. SHANNON
JOSEPH SOWERS
C. & A. ROSENBERGER
AMANDA SOWERS
J. M. DUNMIRE
SUSANNA REARICK
IDA ROSENBERGER
JOHN McCURDY
CLARK PETERMAN
200' BARRIER
MARY C. STEWART
GABRIEL WATTERSON
WM. I. KELLY HRS.
E. WATTERSON
THOS. WATTERSON
B. REARICK
ELEV. OLD BASE
OLD BASE PLUS 16.7 FT. = U.S.G.S.
DONT OWN
JOHN WATTERSON
D. GRAHAM
G. DUNBAR
R. DUNBAR
HUGH & JOHN BLAIR.
E. SEAM FAULT LINE
MARY A. PETERS
BOYER HRS.
SAM'L PETERS
JOHN BOYER
HENRY WE
1" = 400'
FRANK BLANEY
DONT OWN
DONT OWN
W. S. BLOSE
DONT OWN
G. A. ROSENBERGER
FRANK BLANEY
W. S. BLOSE
DONT OWN
PETERS
SEALED
PETERS
FRANK BLANEY
A. BOYER
A. R. BOARTS
FRANK BLANEY
J. R. BOYER
JAMES O. FARSTER
ALVIN J. CAMPBELL Jr.
DONT OWN
E. S. BORTS
J. N. & R. STITT
ST. CLAIR
M. McMILLEN
GIBSON HRS.
J. M. STEWART
(2-COMPARTMENT) MARGARET 7 MAIN SHAFT SEALED
MARGARET MINE
M. HENY
PILLARED AREA
J. STURGEON
G. SMALE
DR. J. A. KELLEY
W. McCONNELL
G. TIMBLIN
FIRST MINING ONLY
FAULT LINE
1" = 400'
M-2

MARGARET NO. 7 (FINAL POSTING 9-30-77)

ROCHESTER & PITTSBURGH COAL CO.
Margaret #7 Mine No. 36 C0822
MARGARET, ARMSTRONG COUNTY, PA.
Scale 1" = 400' Date

JAMES J. SCHAEFFER
No. 7286

J Schaeffer

#171
10-14-
C.C