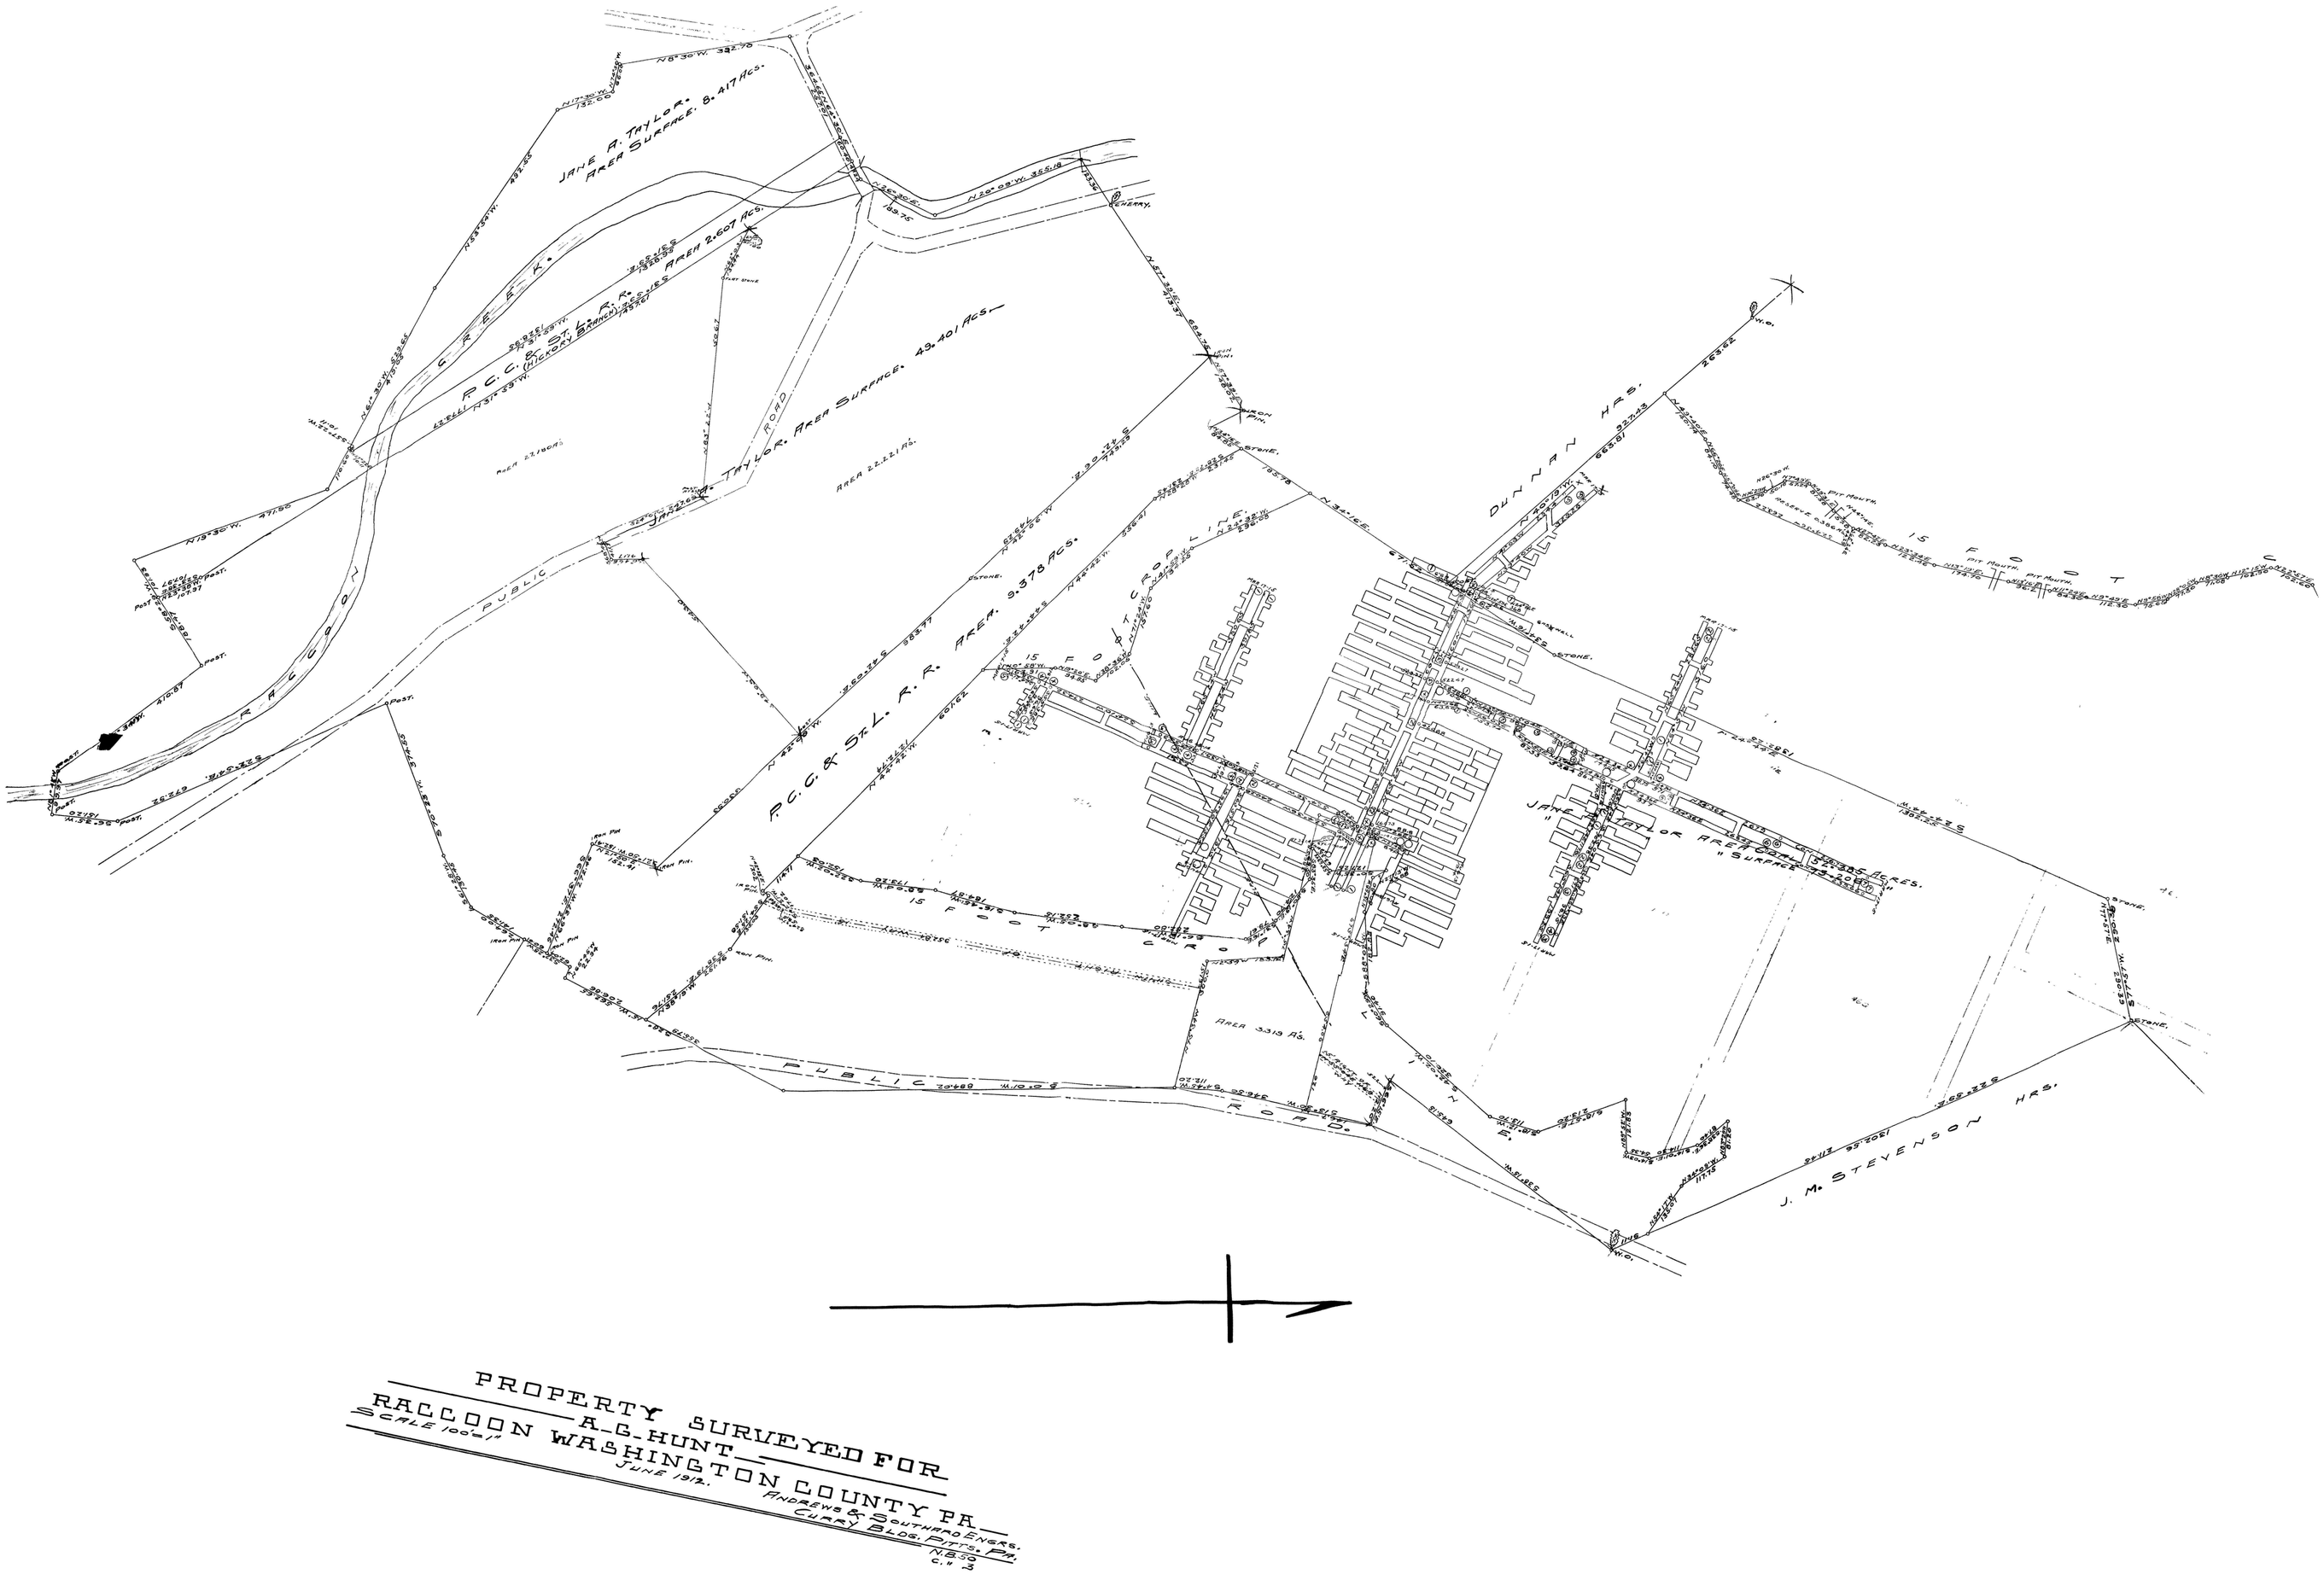


PROPERTY SURVEYED FOR
A. G. HUNT
RACCOON WASHINGTON COUNTY PA.
SCALE 100 = 1"
JUNE 1912.

ANDREWS & SOUTHWORTH ENGRS.
CURRY BLDG. PITTS. PA.
NB 52
C.H. 3