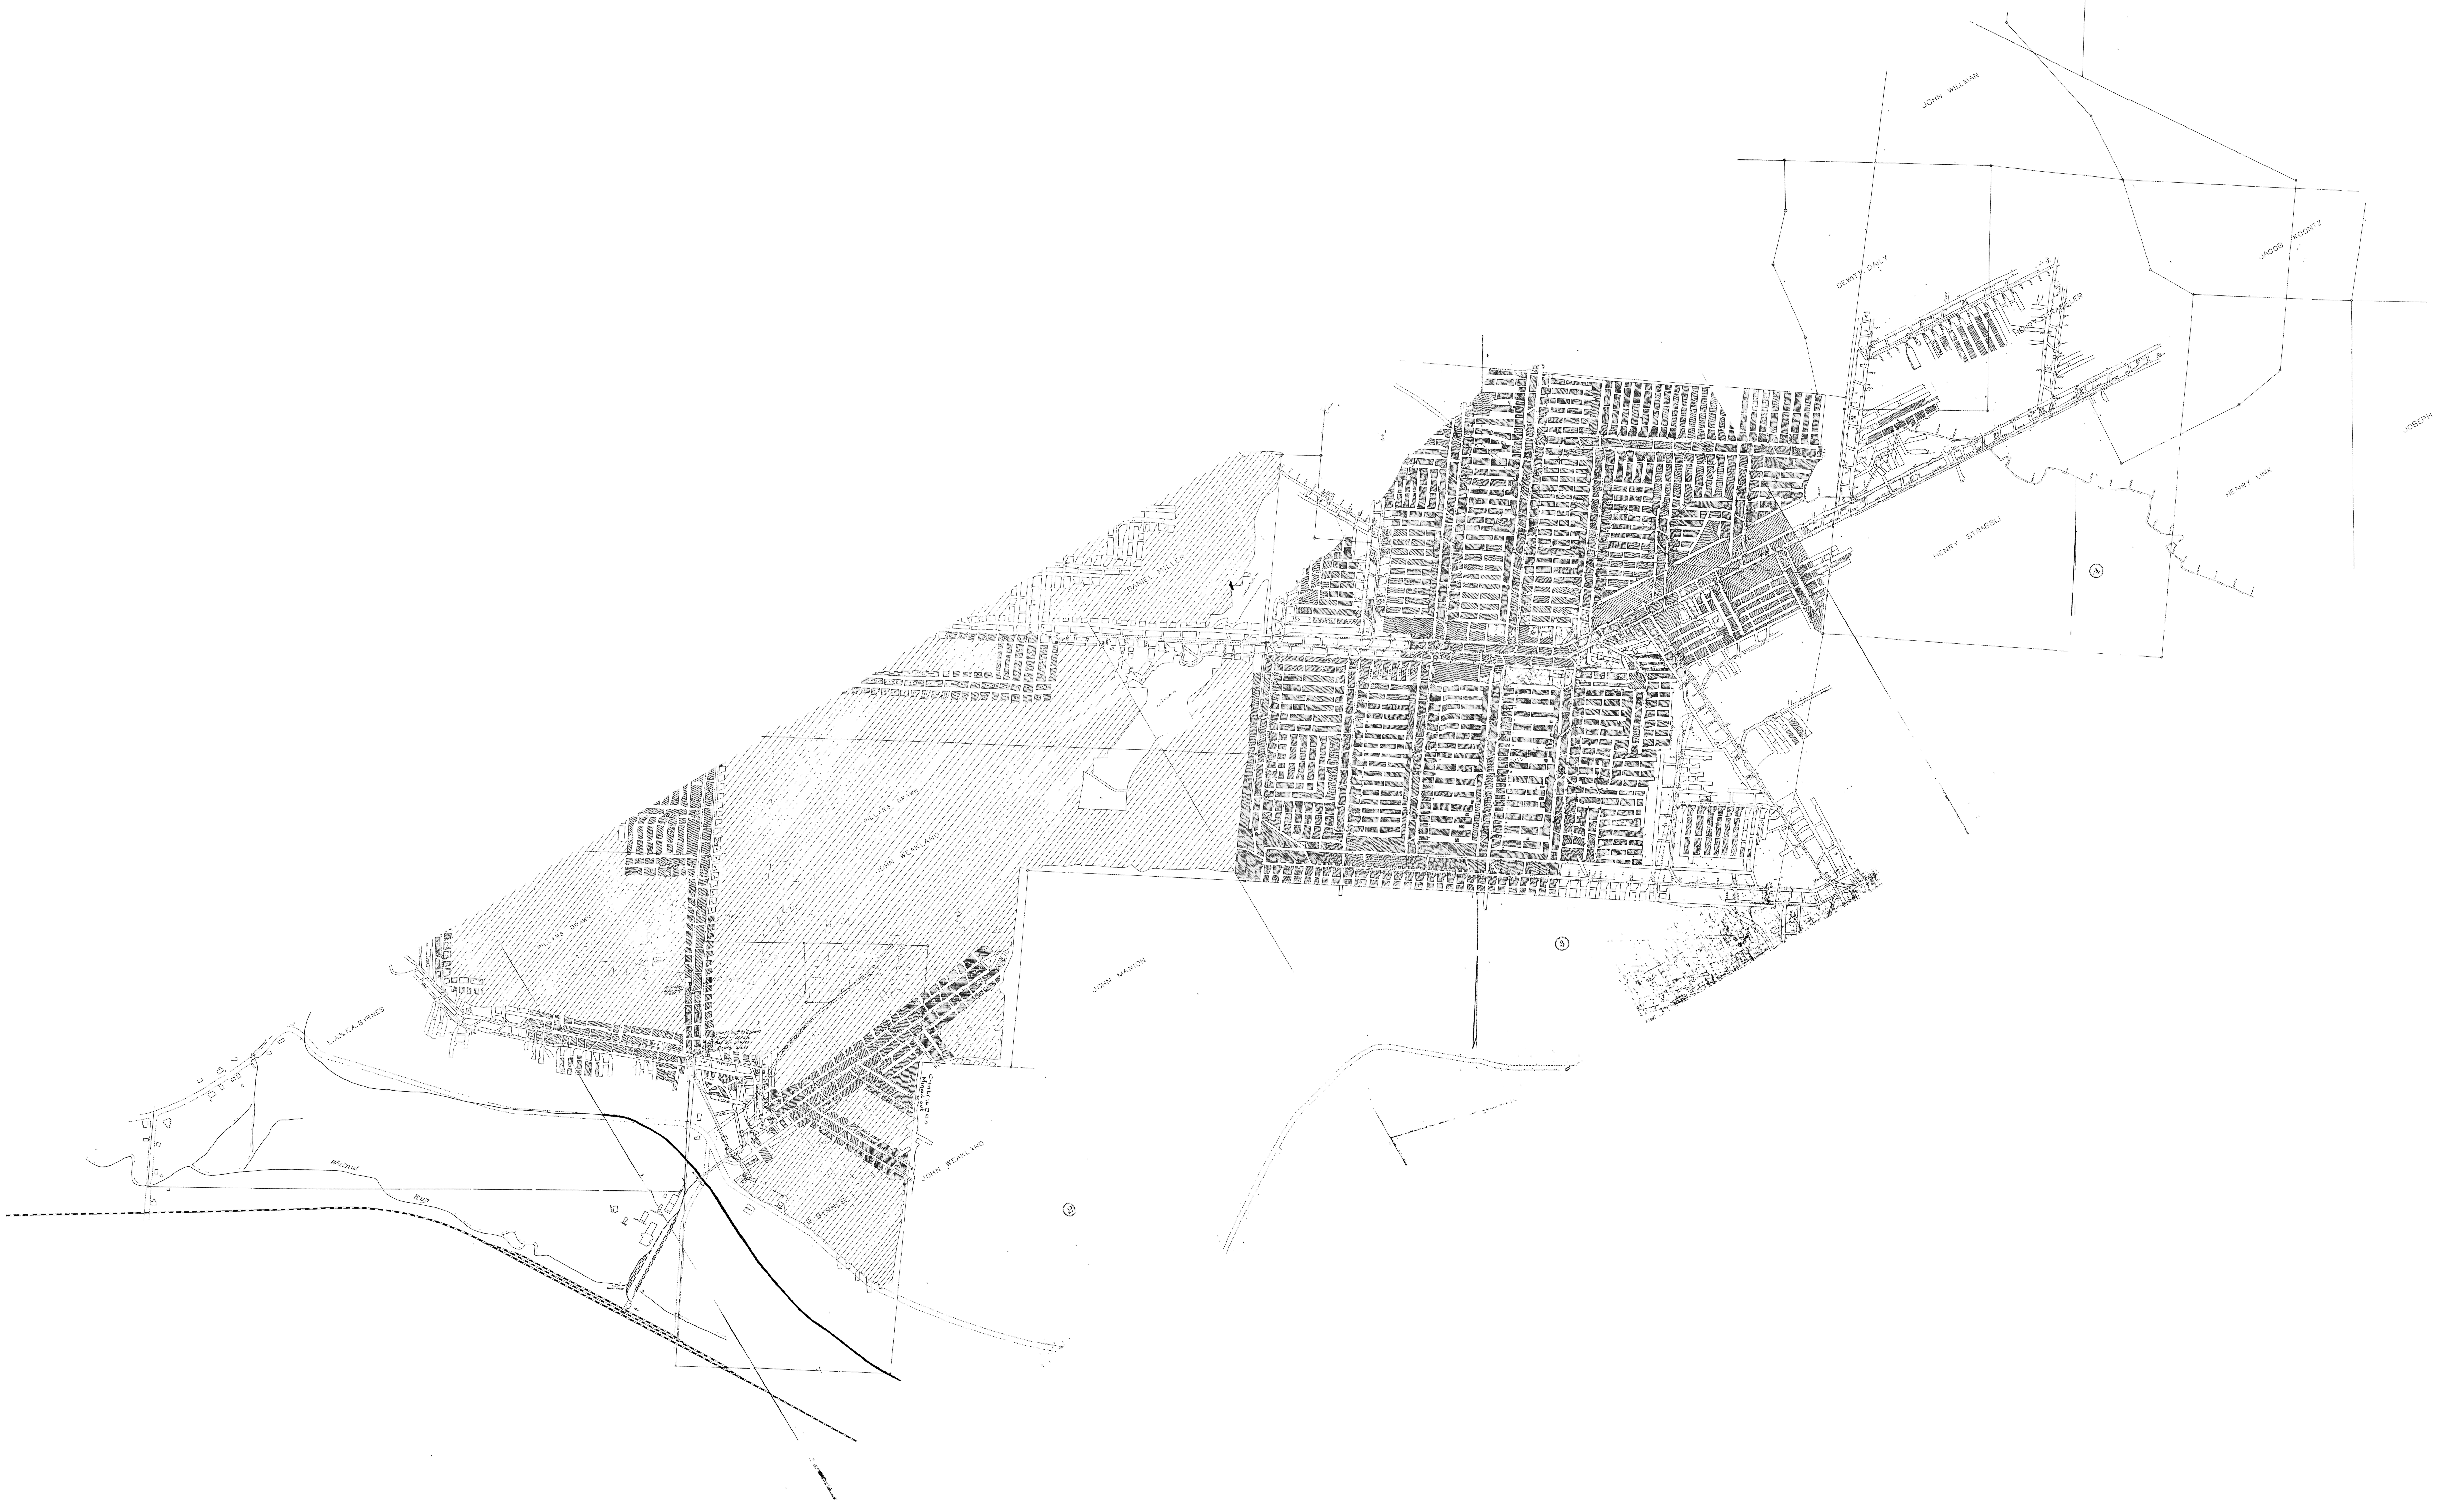
JOHN WILLMAN
DEWITT DAILY
HENRY SPANGLER
JACOB KOONTZ
JOSEPH
HENRY LINK
HENRY STASSU
DANIEL MILLER
PILLARS DRAWN
JOHN WEAKLAND
JOHN MANION
PILLARS DRAWN
W. & C. A. BYRNES
Walnut
Run
R. BYRNES
JOHN WEAKLAND
Cymbria Co
Mined out
Shaft Surf to E Seam
El Surf - 1596.70
El Bot E - 1569.80
Depth - 26.40
El Top Shaft 1566.9
El Bot Shaft 1525.0
"E" to "D"
1st DIP
ROAD TO CEMETERY
LUMBER SHED
SUPPLY ROOM
BARN
HOUSE
④
③
⑯
①

On this 11th day of January A. D. 1947, the undersigned mining engineer of Pennsylvania Coal and Coke Corporation, in compliance with Section 6 (as amended by Act of July 1, 1937, Section 2, P. L. 1937), Article II, of the Bituminous Mining Laws of Pennsylvania, approved June 9, 1911, hereby certifies that this print is a true and correct copy of the original mine map of Barnesboro No. 17-D Mine of Pennsylvania Coal and Coke Corporation. The undersigned further certifies that, to the best of his knowledge and from the information obtainable, he believes that the original map is a true, complete and correct map and survey of all of the excavations made in said permanently abandoned mine. In making this certificate, the undersigned states that the mine in question was operated by other mining organizations prior to the acquisition and operation thereof by Pennsylvania Coal and Coke Corporation and prior to the time when the mine workings and surveys thereof were under the direction of the undersigned, so that he has no direct means of information with respect to the earlier workings and excavations. This certificate, insofar as additions were made to said original map under his direction since the year 1924, is based upon the best of his knowledge and belief from information furnished to him by engineers and others working under his direction.

(While said mine above identified has been permanently abandoned, there remains in the property along the outcrop of the "D" seam of coal certain coal which may in the future be removed by stripping operations or by the entry of drifts through said outcrop.)

Mining Engineer
Pennsylvania Coal and Coke Corporation.

PENNSYLVANIA COAL AND COKE CORPORATION
BARNESBORO NO 17-D MINE
"D SEAM OF COAL
Scale 1"-100'