


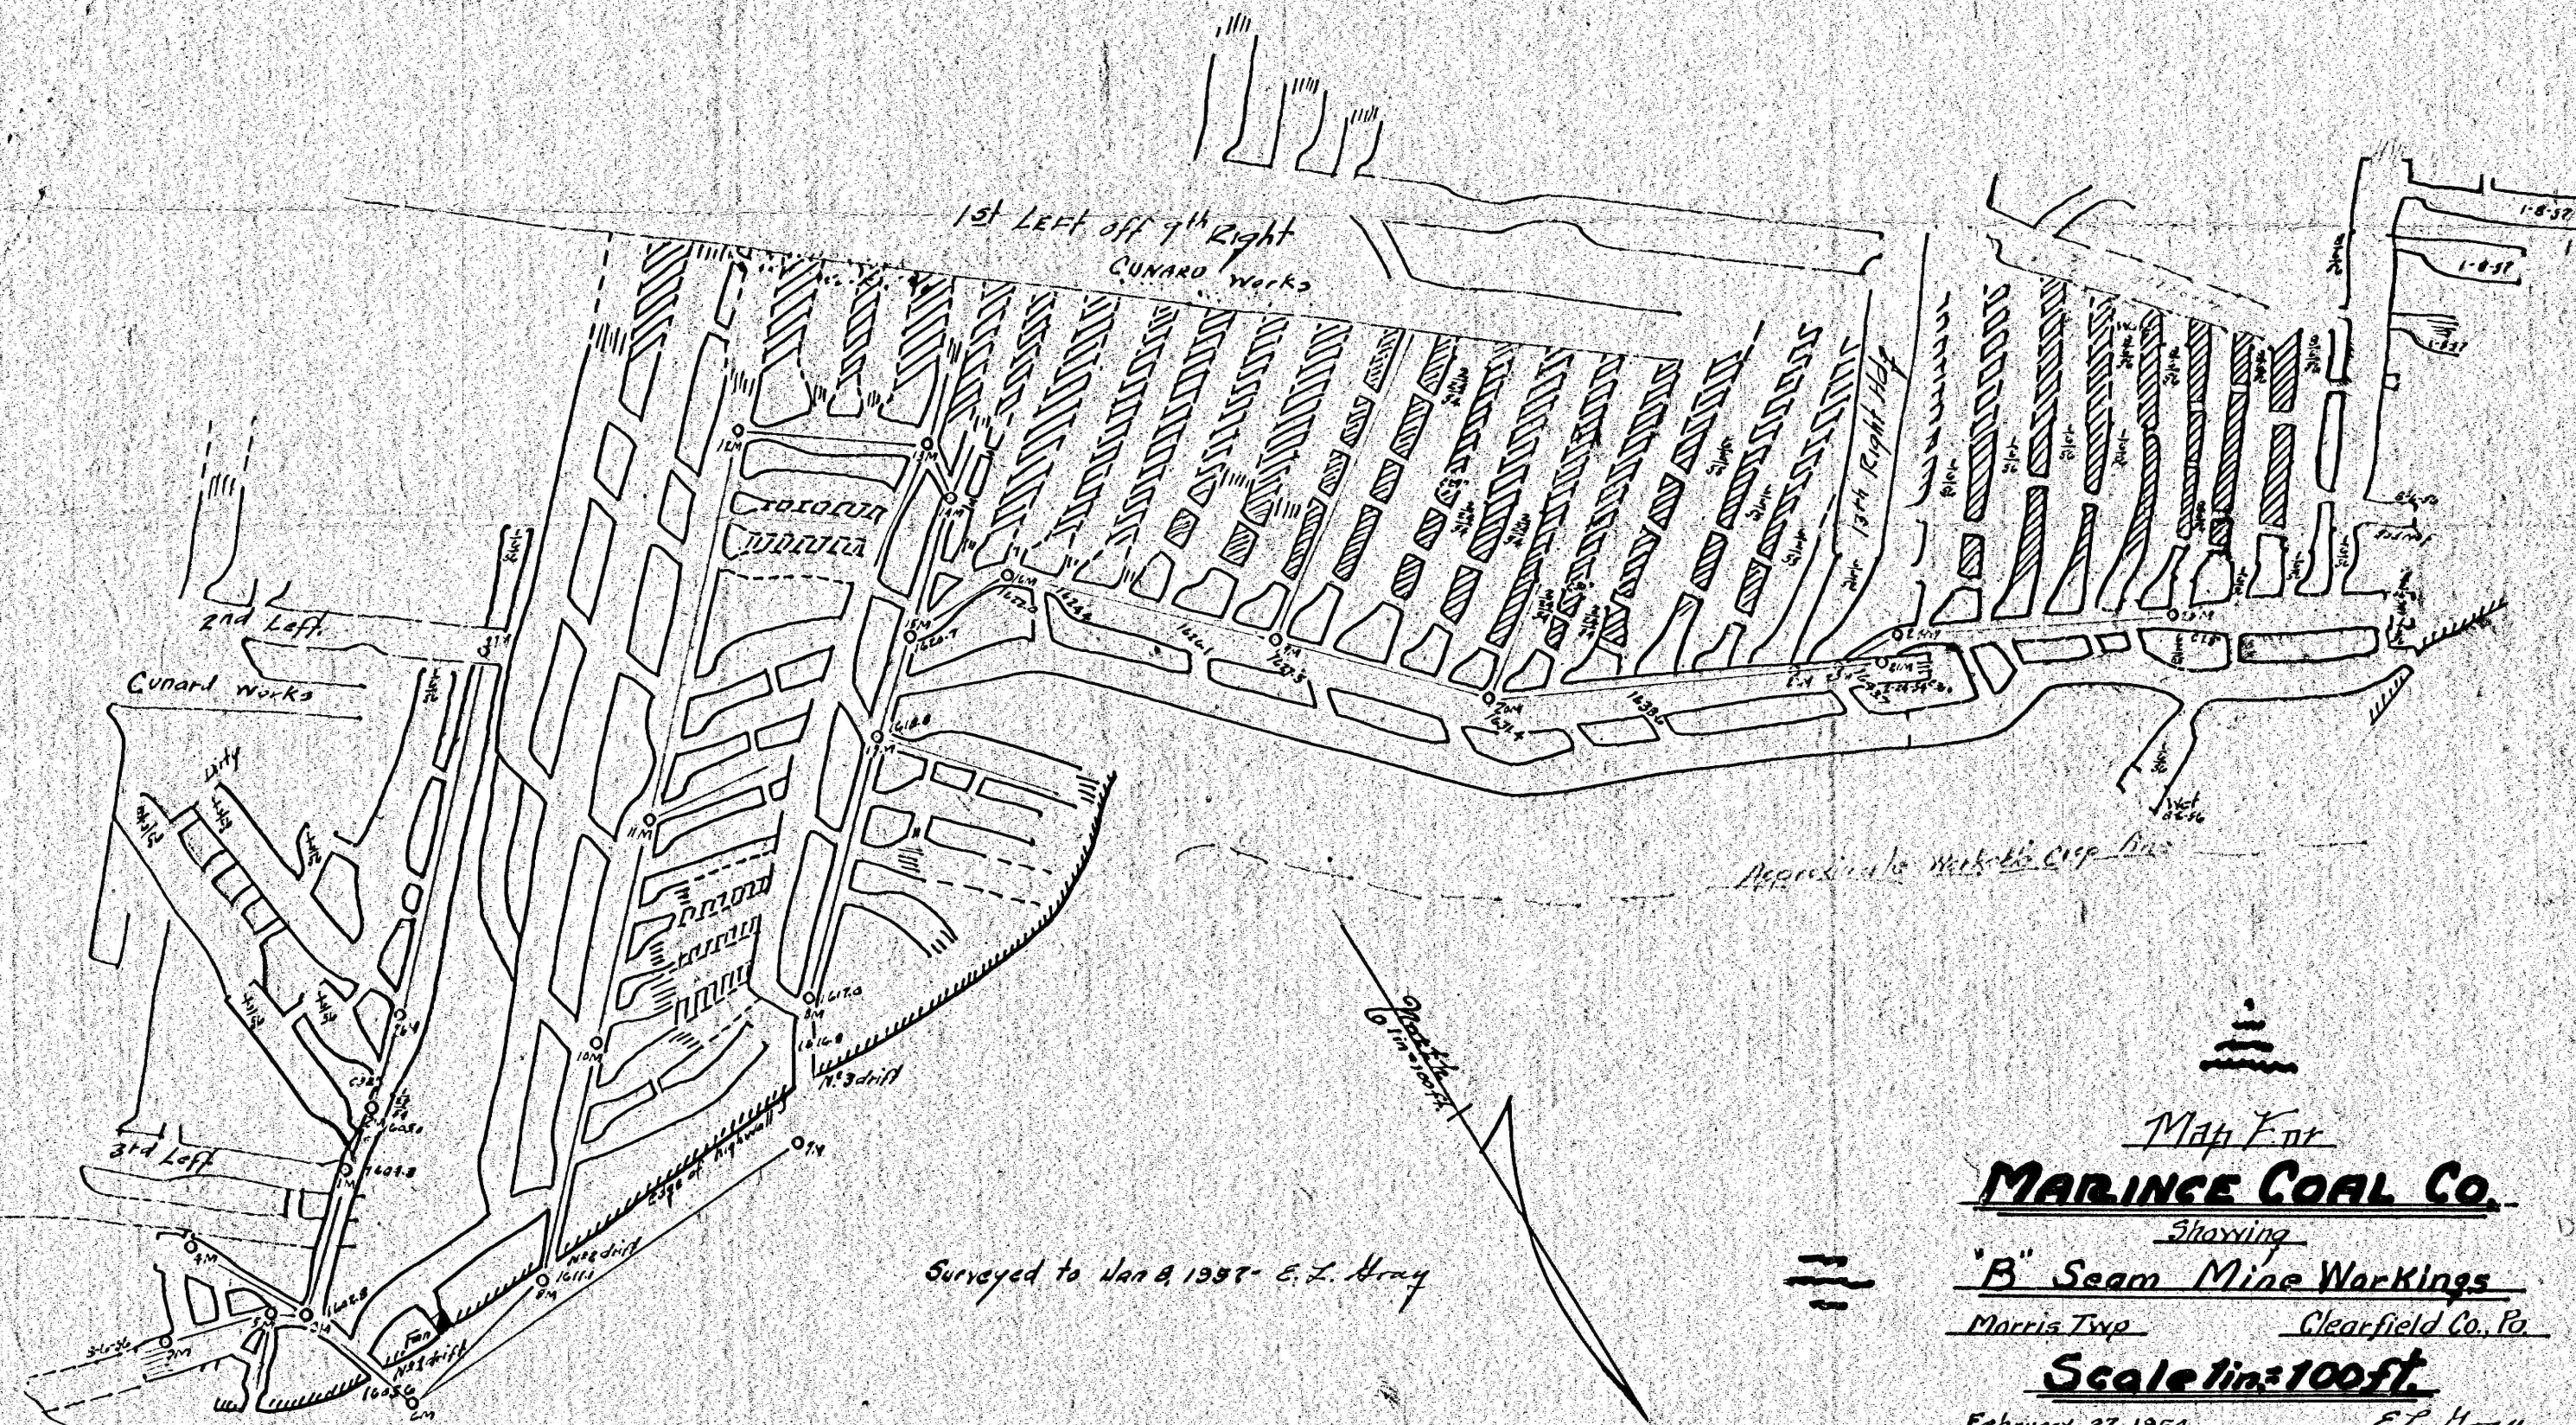

Surveyed to Jan 8 1938 - E. L. Gray

Map For
MARINE COAL CO.
 Showing
"B" Seam Mine Workings
 Morris Twp. Clearfield Co. Pa.
Scale 1 in = 100 ft.
 February 27 1934
 E. L. Gray
 MARINE COAL MINING CO.

FORWARDED ANDREW 1930

11721
 10-14-34