DAVID R MILLS
ENGINEER
26558 E
PENNSYLVANIA

I, David R. Mills, do hereby certify that this print is a true and correct copy of the original map for Mark Mining No. 2, Inc., Mark No. 1 Mine and that the original map is a true, complete, and correct map and survey of all excavations made through September 30, 1986.

David R Mills
David R. Mills, P.E.

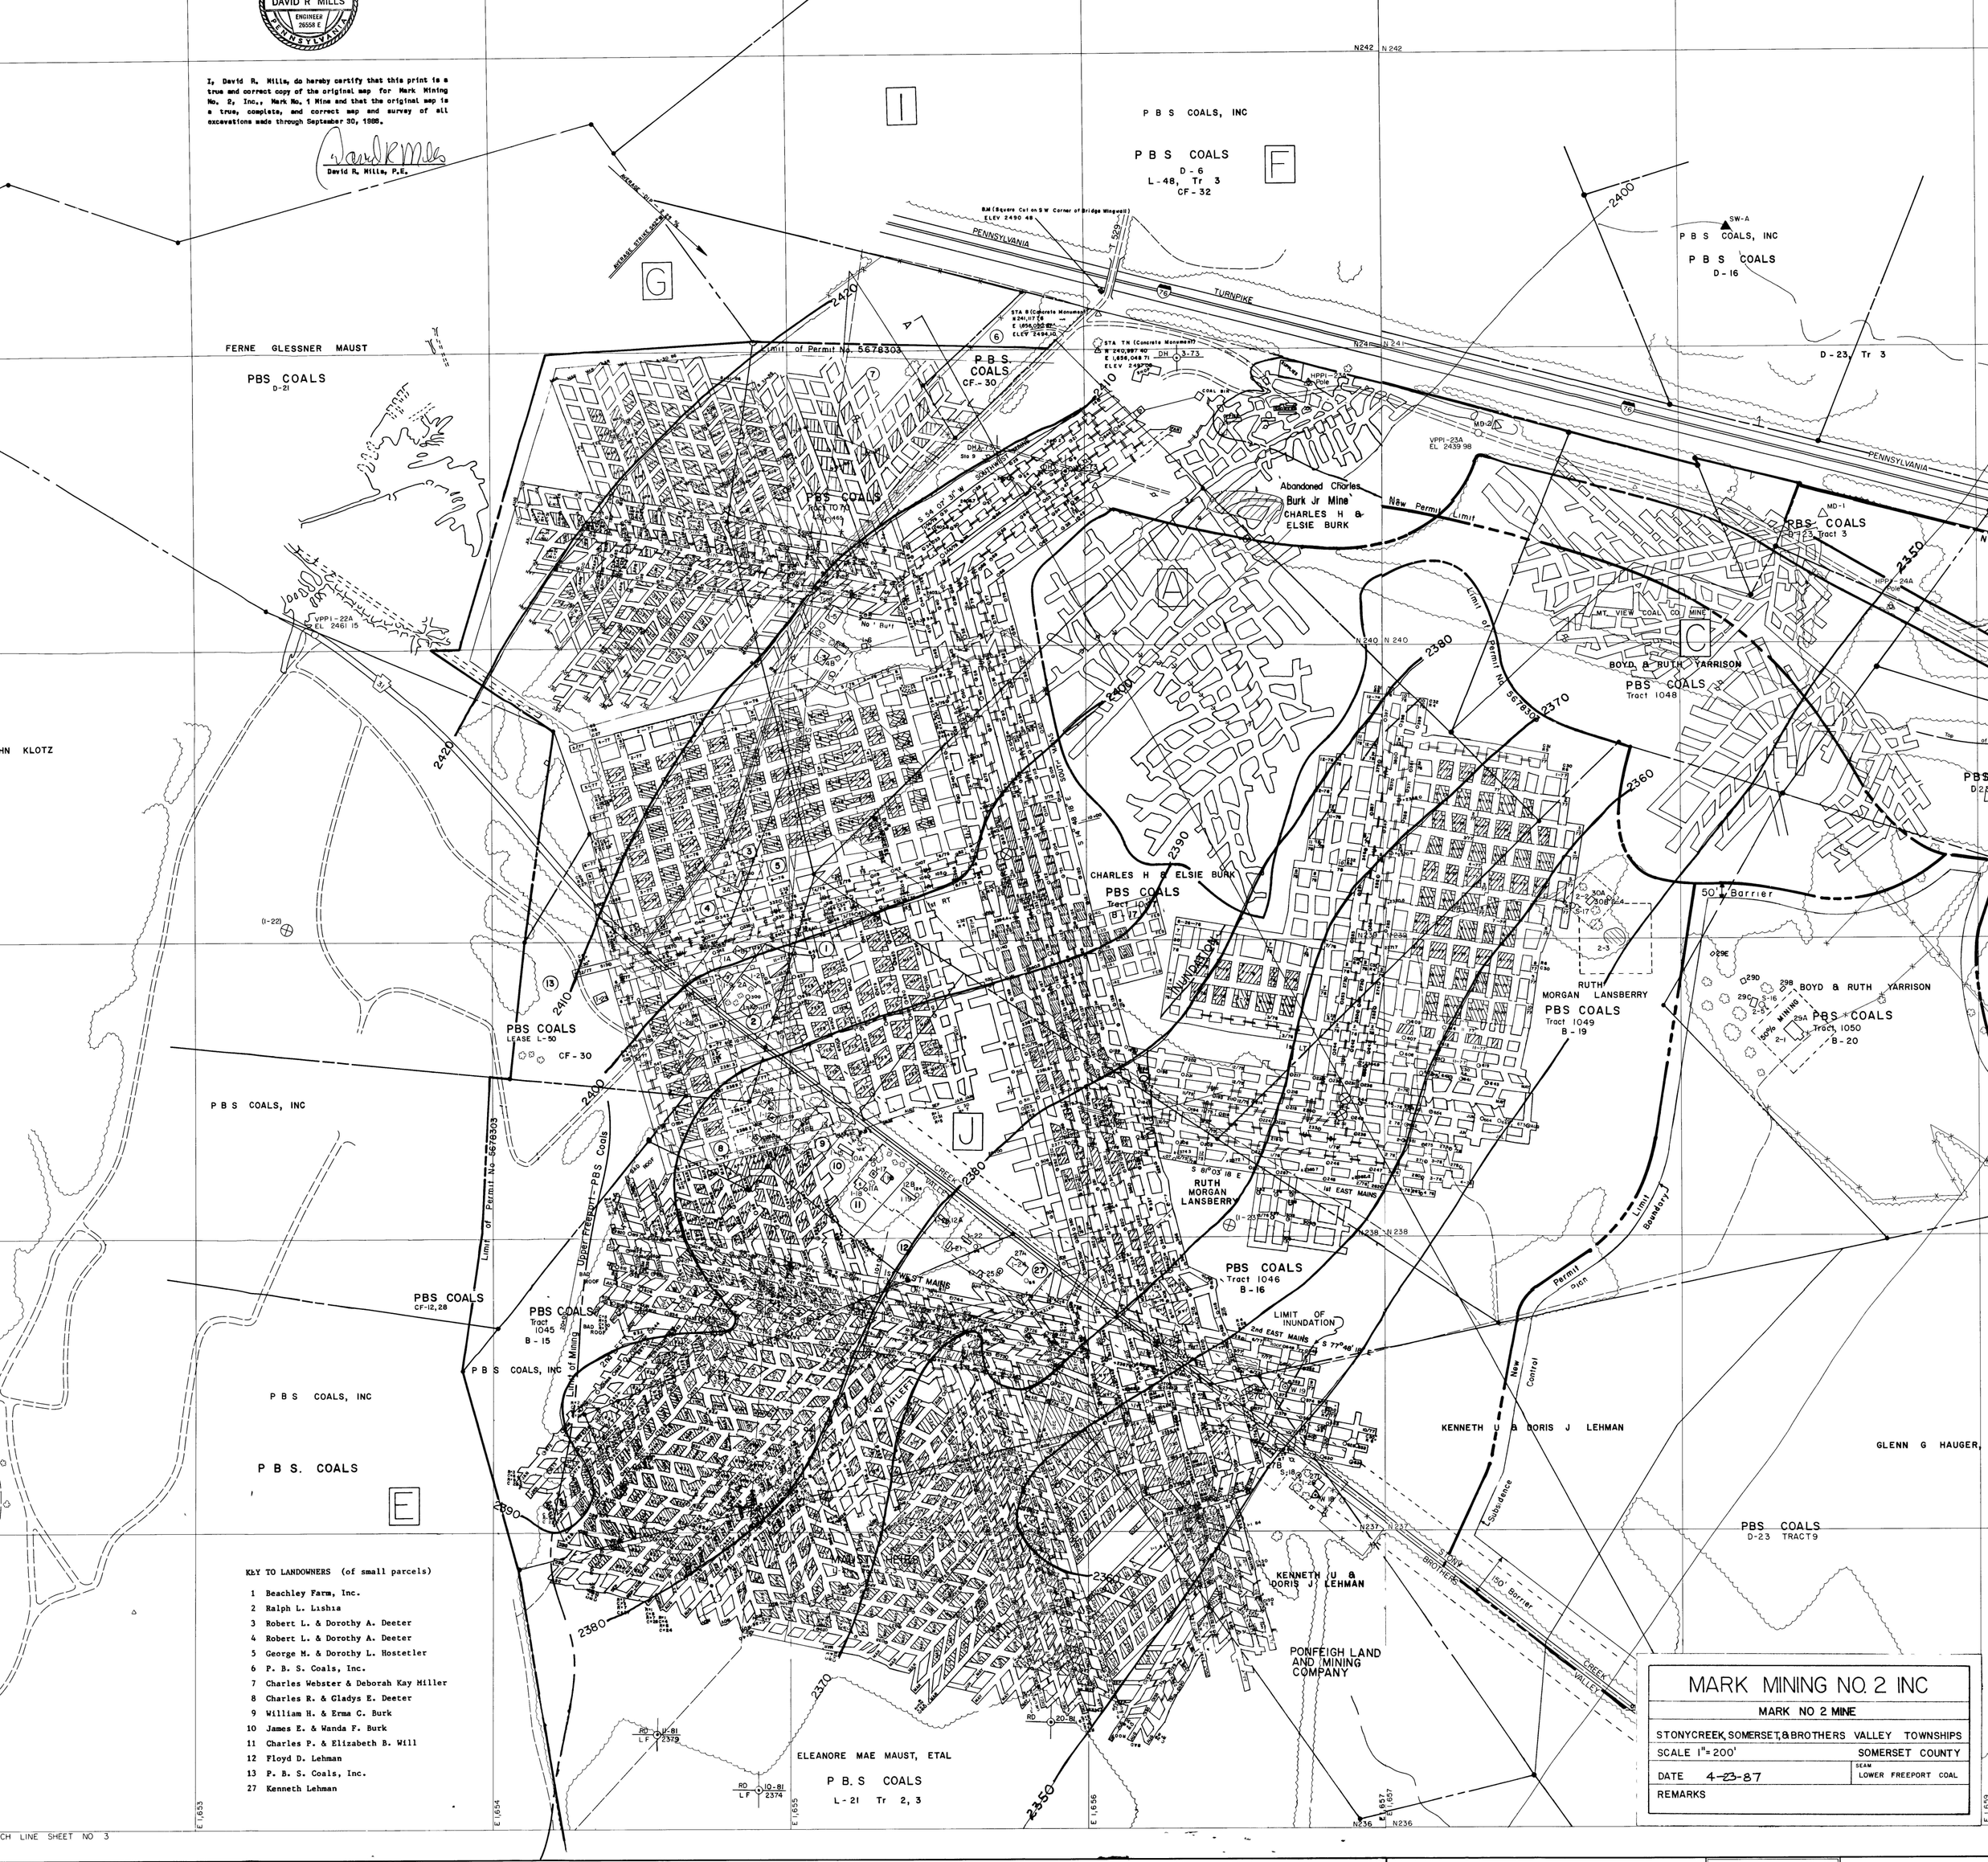

MARK MINING NO. 2 INC

MARK NO 2 MINE

STONYCREEK, SOMERSET, & BROTHERS VALLEY TOWNSHIPS

SCALE 1" = 200' — SOMERSET COUNTY

DATE 4-23-87 — SEAM LOWER FREEPORT COAL

REMARKS

LEGEND

- RAILROAD
- LAKE, POND
- FENCE
- SWAMP
- WOODS LINE
- BENCH MARK
- TRAVERSE STATION
- PHOTOGRAMMETRIC SPOT ELEVATION
- CONTOURS
- PHOTO CENTER

SCALE 1" = 200'

DATE OF PHOTOGRAPHY DECEMBER 5, 1976
CONTOUR INTERVAL. 5'

GRID VALUES IN THOUSANDS
GRID BASED ON PENNSYLVANIA STATE PLANE COORDINATE SYSTEM (SOUTH ZONE) 1927 N A DATUM
VERTICAL CONTROL BASED ON 1929 M.S.L. DATUM

NORTH

SHEET INDEX

PLANIMETRIC SERIES

SHEET NO. 1

Jeads
Engineering & Associated Design Services
Formerly Gwin Engineers, Inc.
1126 Eighth Ave Altoona, PA 16603

SEAL

DATE _____

BROTHERSVALLEY, S
& SOMERSET T
SOMERSET CO
PENNSYLVANI