


EAST WHEATFIELD TOWNSHIP
INDIANA COUNTY
PERMIT NUMBER - 204-3
B² OR LOWER KITTANNING SEAM

UNITED STATES
DEPARTMENT OF THE INTERIOR
GEOLOGICAL SURVEY

STATE OF PENNSYLVANIA
DEPARTMENT OF INTERNAL AFFAIRS
TOPOGRAPHIC AND GEOLOGIC SURVEY

APPLICANT: THE FLORENCE MINING CO.
MINE LOCATED ON MAP BY KENNETH L. WOOD
PENNSYLVANIA
NE/4 NEW FLORENCE 15' QUADRANGLE
7.5 MINUTE SERIES (TOPOGRAPHIC)

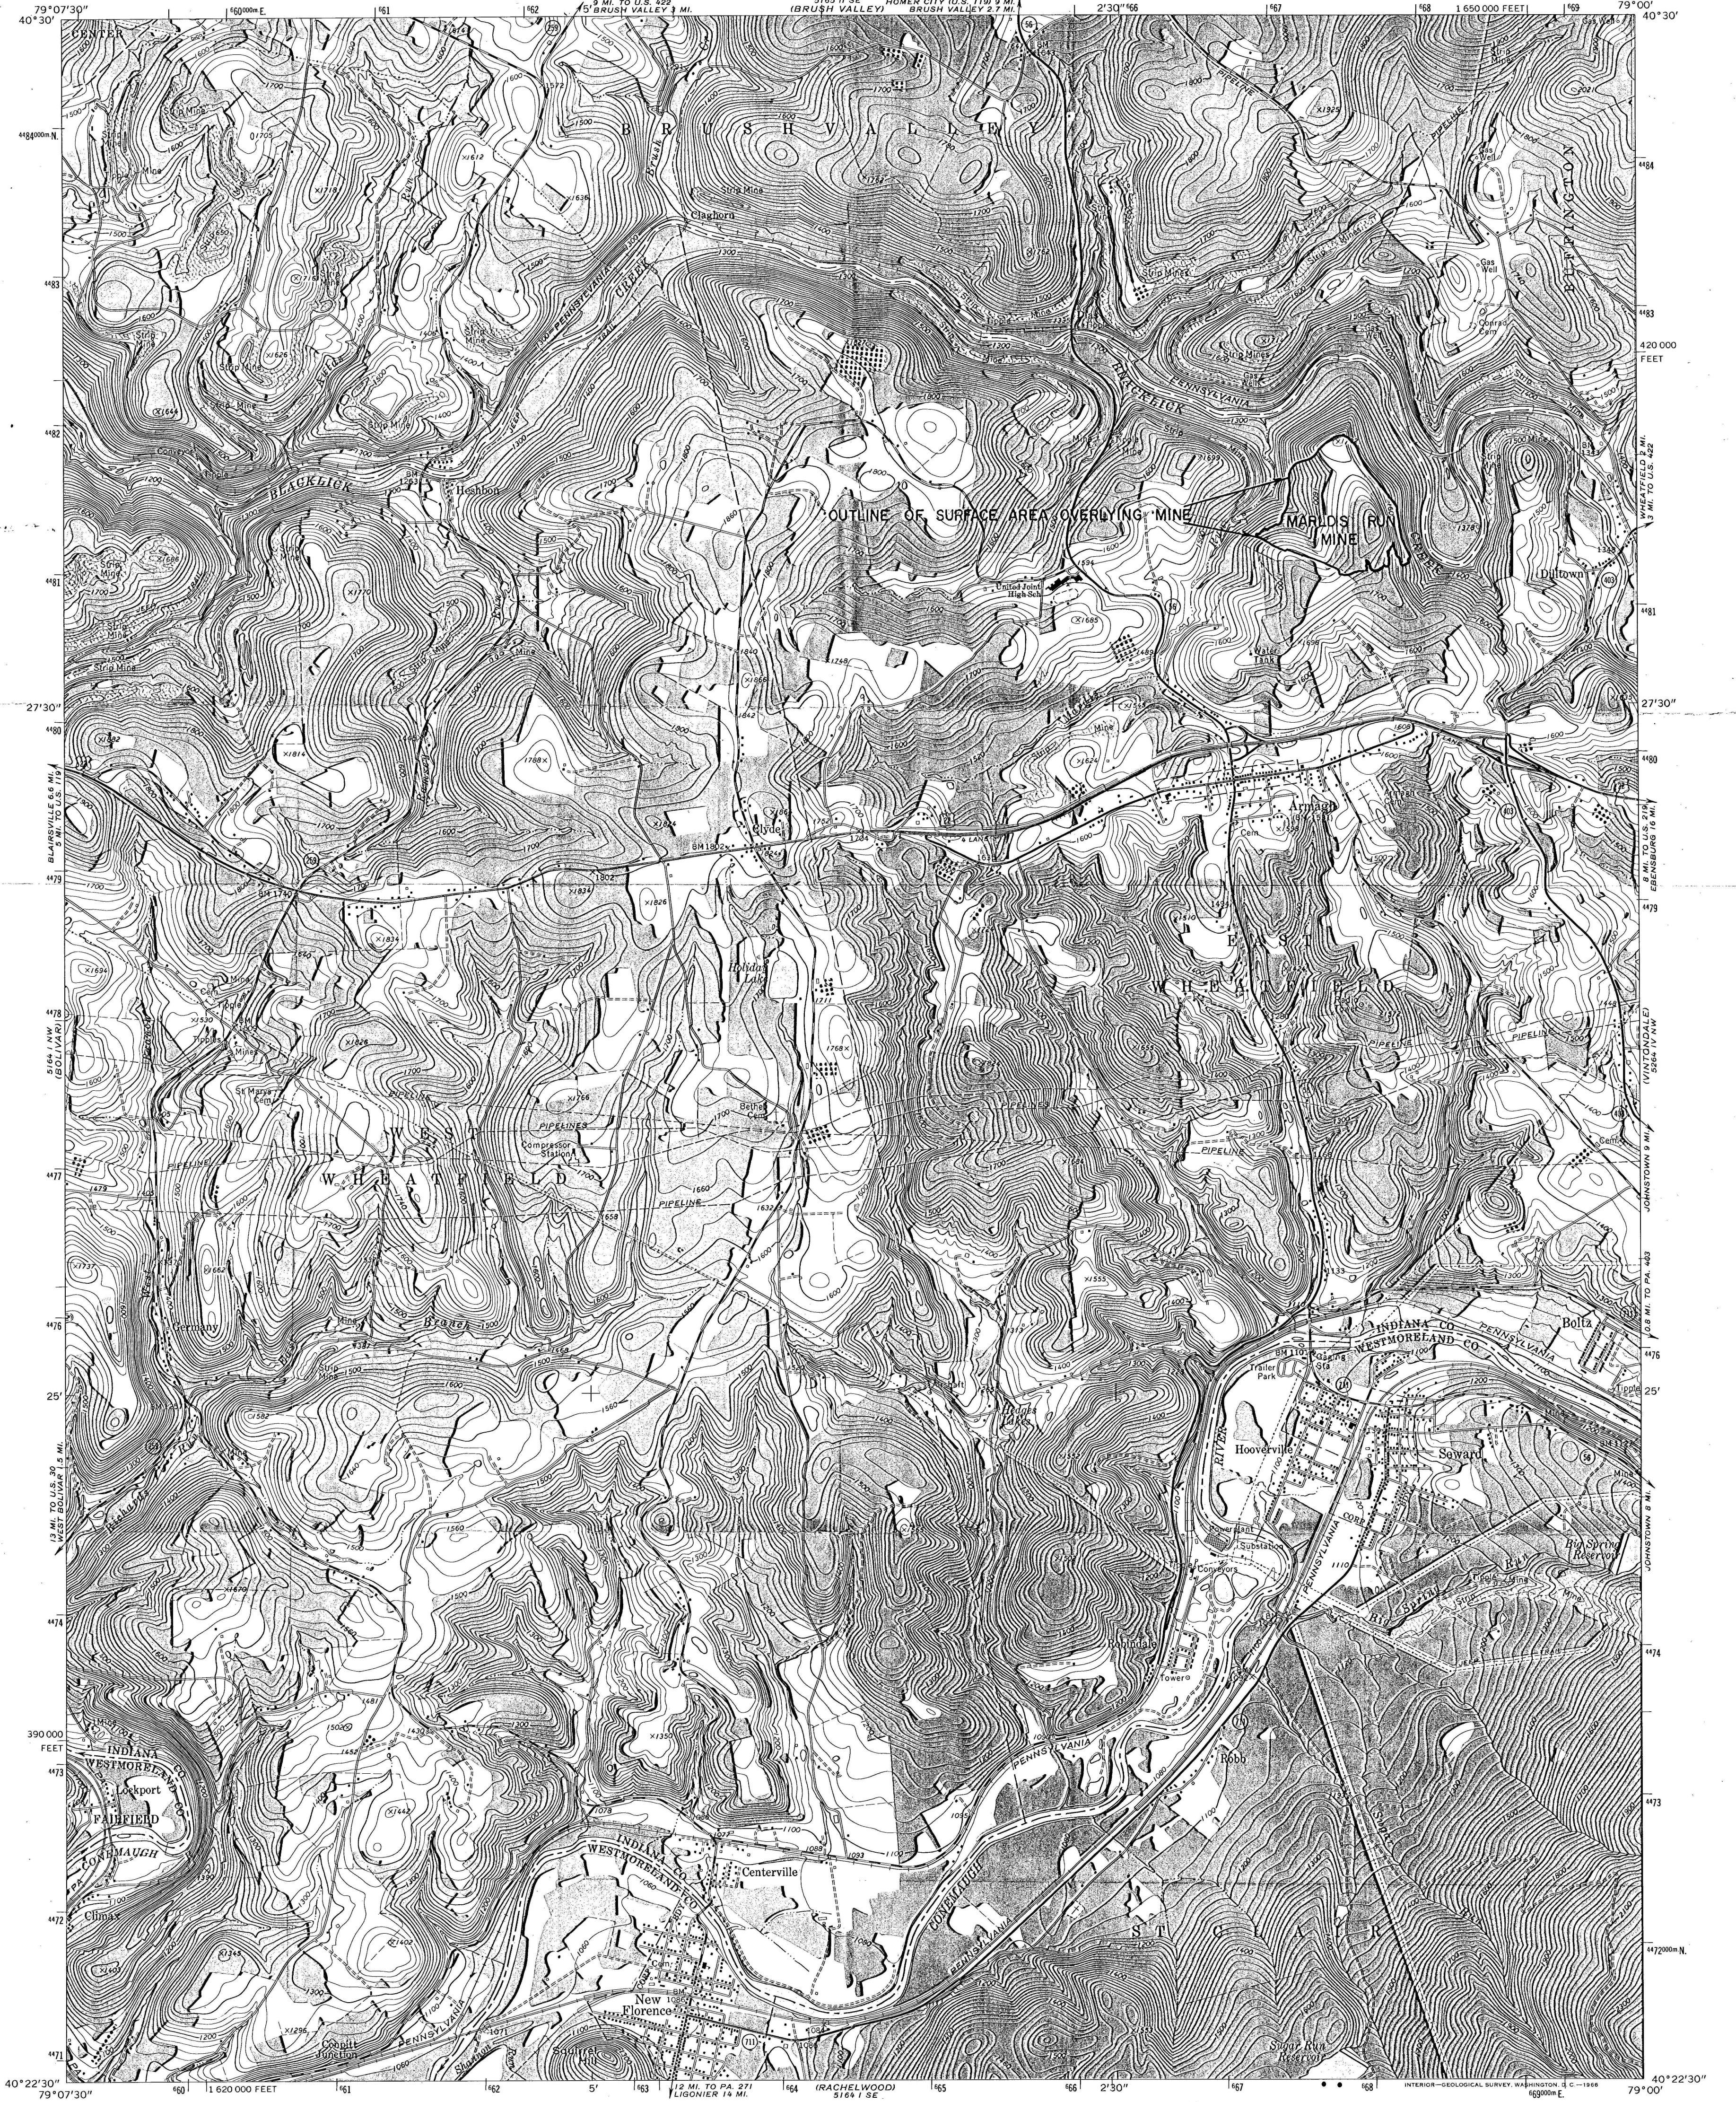

Maped, edited, and published by the Geological Survey
Control by USGS and USC&GS
Topography by photogrammetric methods from aerial photographs
taken 1962. Field checked 1964
Polyconic projection. 1927 North American datum
10,000-foot grid based on Pennsylvania coordinate system, south zone
1000-meter Universal Transverse Mercator grid ticks, zone 17,
shown in blue
Fine red dashed lines indicate selected fence and field lines where
generally visible on aerial photographs. This information is unchecked
UTM GRID AND 1964 MAGNETIC NORTH
DECLINATION AT CENTER OF SHEET
SCALE 1:24,000
1 MILE
1 KILOMETER
CONTOUR INTERVAL 20 FEET
DATUM IS MEAN SEA LEVEL
ROAD CLASSIFICATION
Heavy-duty Light-duty
Medium-duty Unimproved dirt
U.S. Route State Route
NEW FLORENCE, PA.
NE/4 NEW FLORENCE 15' QUADRANGLE
N4022.5-W7900/7.5
1964
AMS 5164 I NE-SERIES V831