


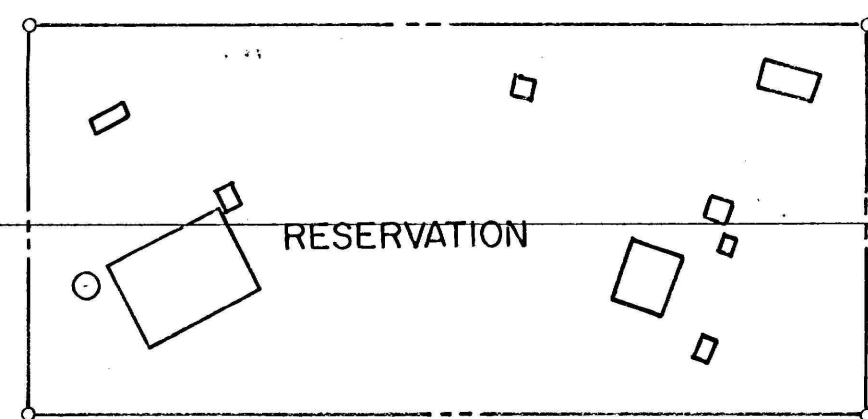

THE FLORENCE MINING COMPANY  
RICHARDS RUN MINE  
EAST & WEST WHEATFIELD TWP., INDIANA CO., PA.  
SCALE: 1" = 100' SURVEY DATE: 3-1-60

*Benjamin R. Galt*  
J. L. GALT

LEGEND

PROTECTED STRUCTURES  
MINING COMPLETED AREA

FINAL MAP

FEDERAL DEPT. OF MINES  
REC'D  
APR 1 1960  
BUREAU OF MINE SURVEYING

16

12-20-60

DATE OF LAST SURVEY


SUNNYCREEK COAL COMPANY  
RICHARDS RUN MINE  
UPPER FREEPORT  
WEST WHEATFIELD TWP.

DATE: 12-20-60

SCALE: 1" = 100'

113