


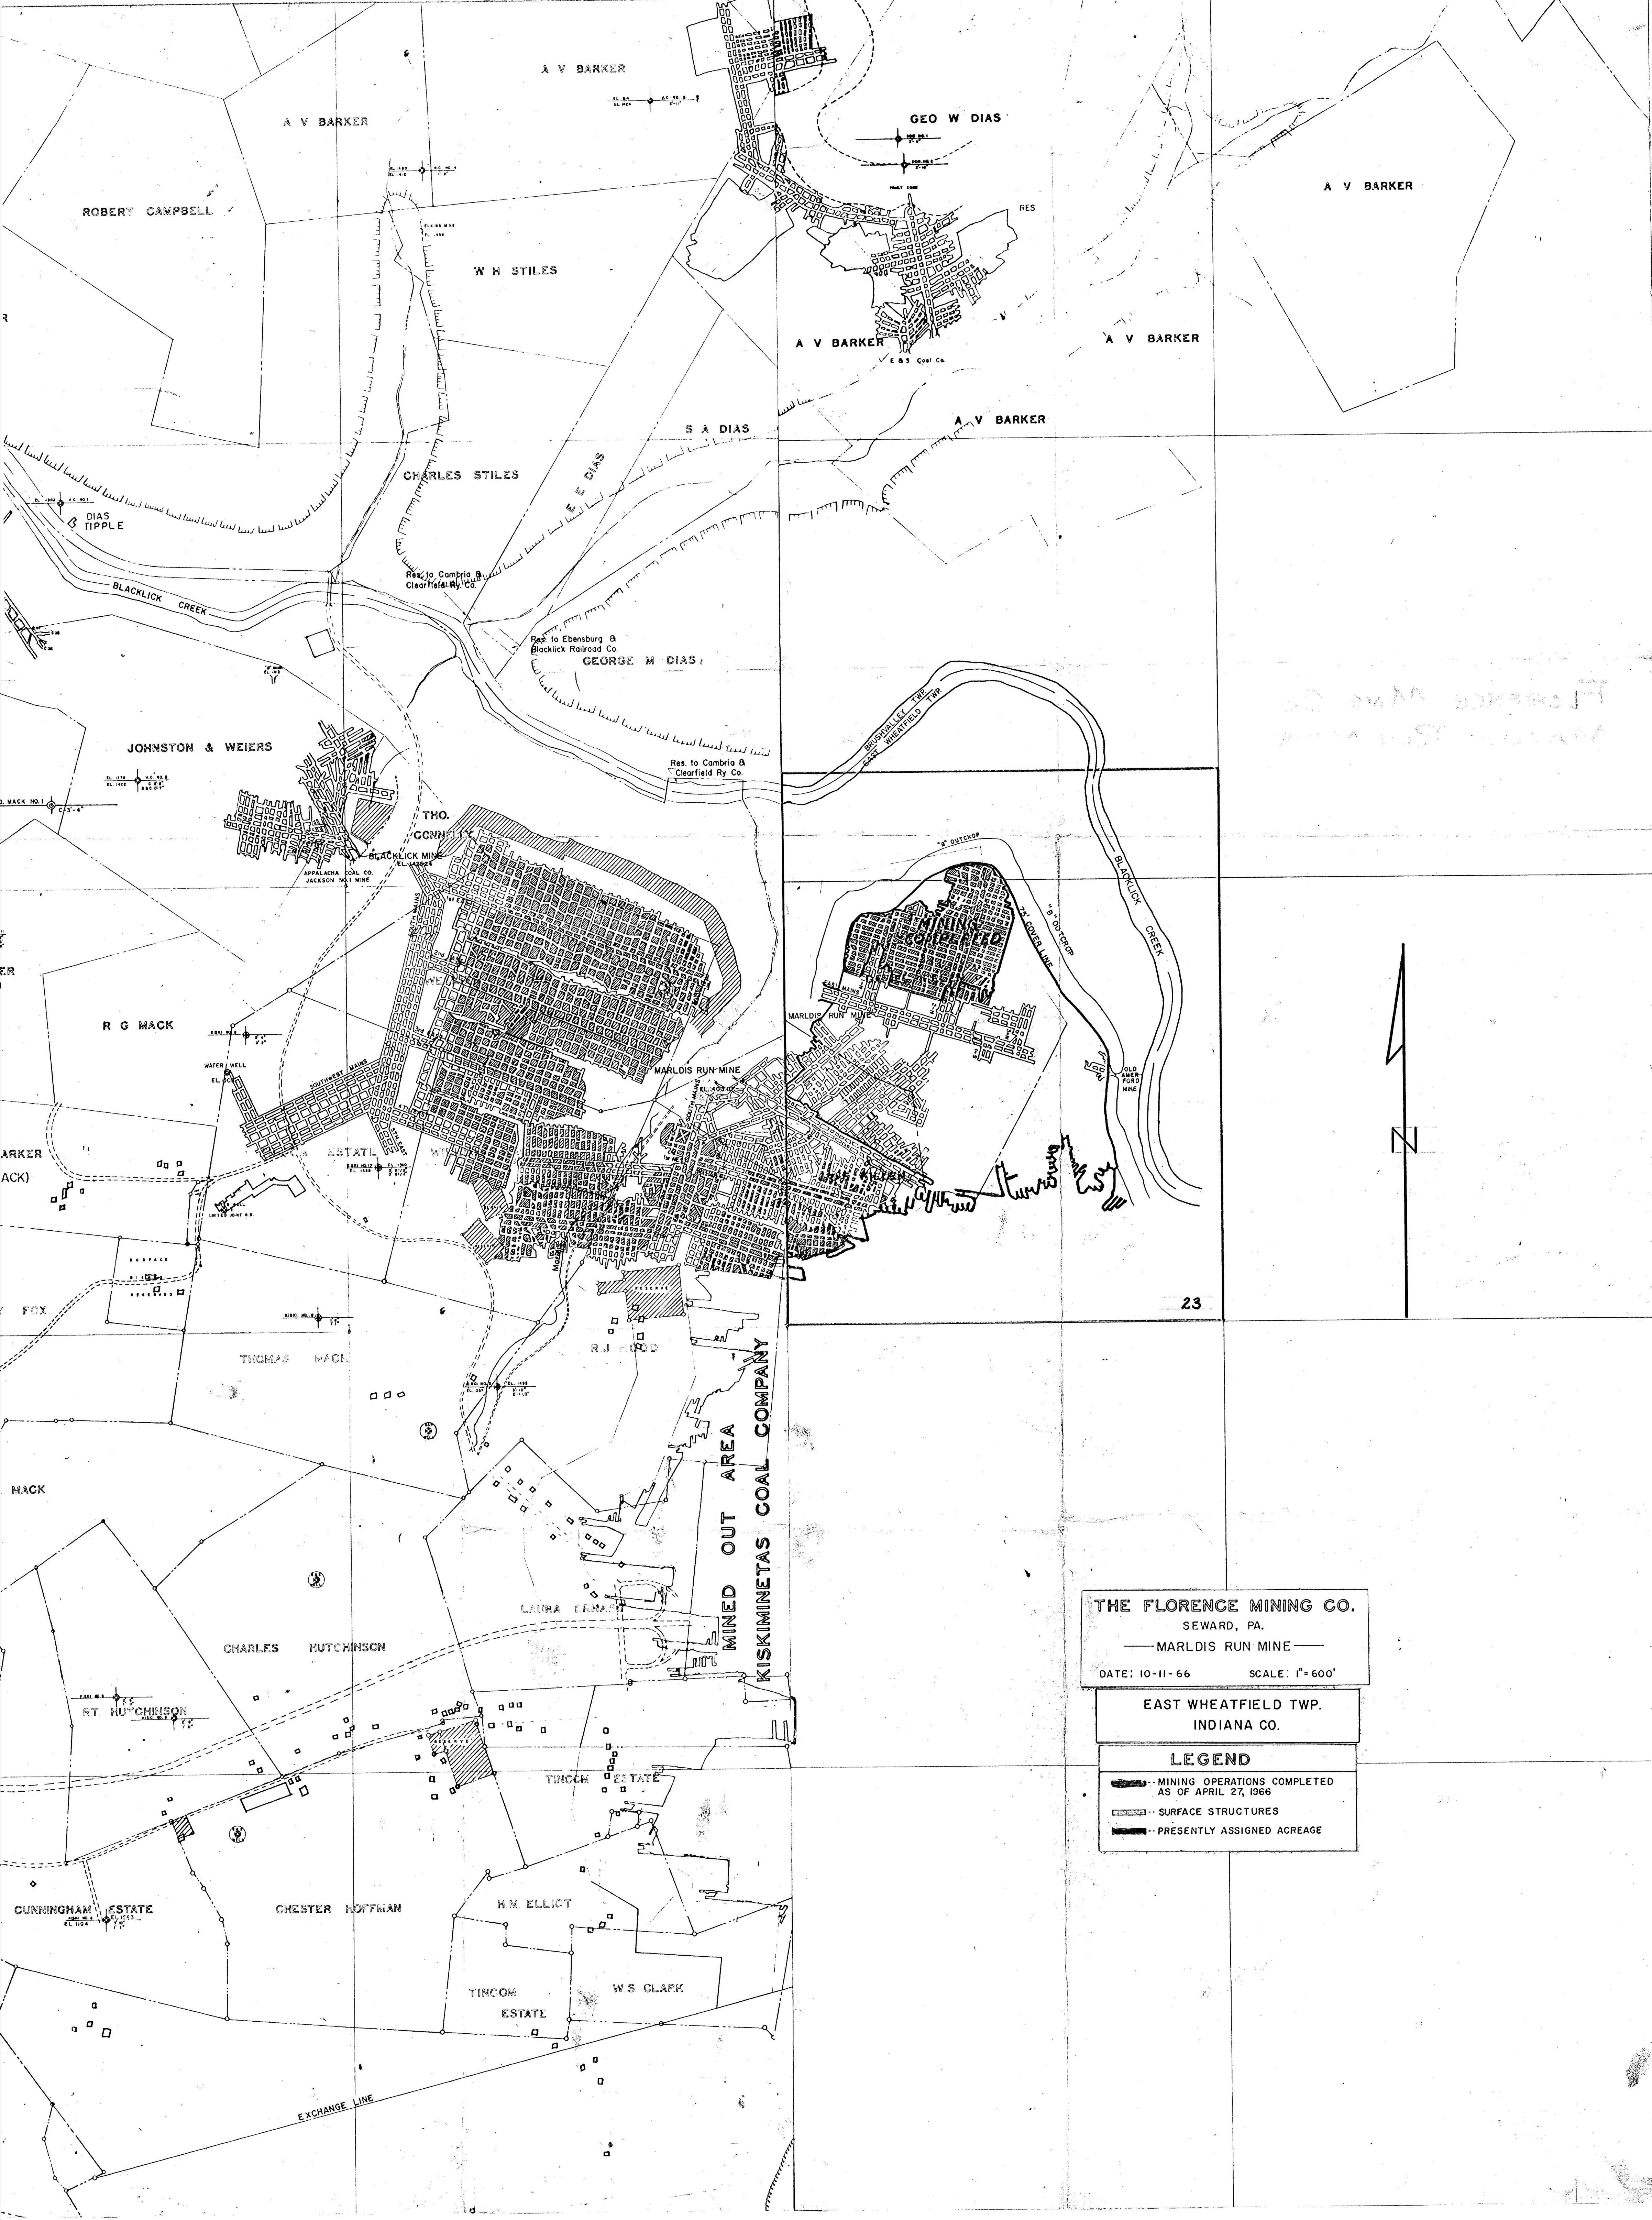

THE FLORENCE MINING CO.
SEWARD, PA.
— MARLDIS RUN MINE —
DATE: 10-11-66 SCALE: 1" = 600'

EAST WHEATFIELD TWP.
INDIANA CO.

LEGEND
--- MINING OPERATIONS COMPLETED
AS OF APRIL 27, 1966
--- SURFACE STRUCTURES
--- PRESENTLY ASSIGNED ACRES