



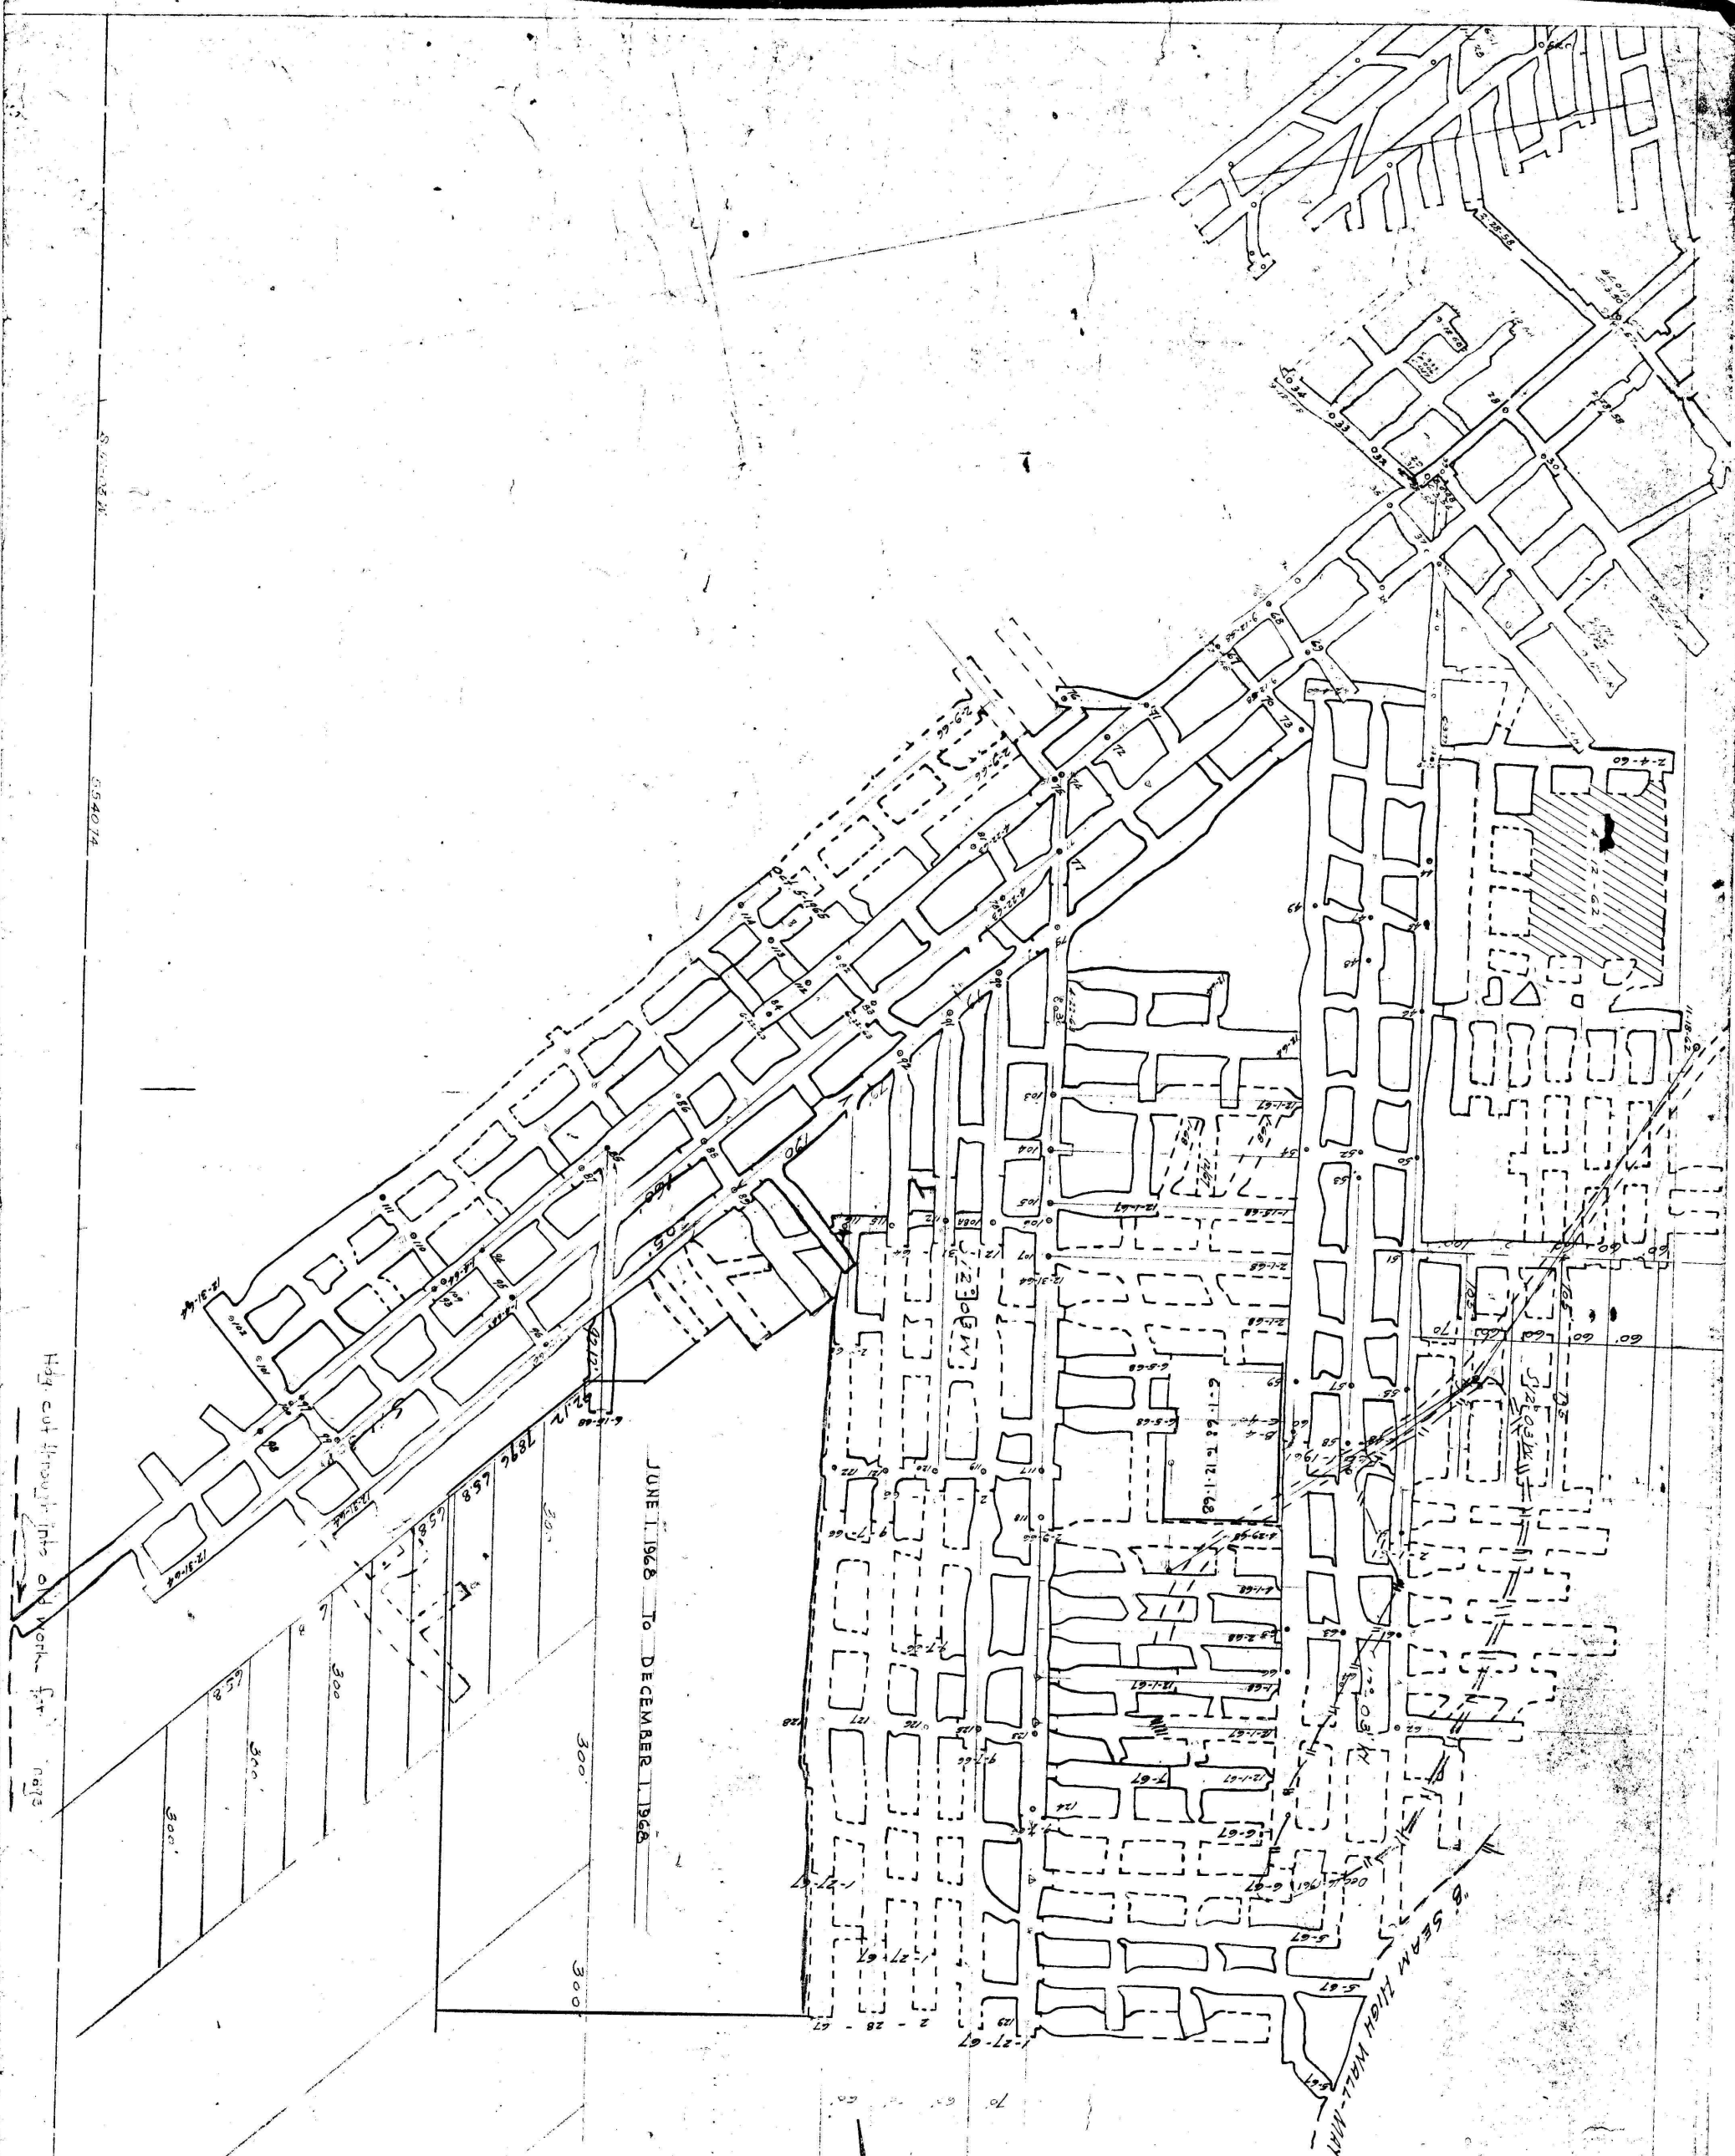

JUNE 1 1968 TO DECEMBER 1 1968

SWAMP COAL COMPANY
 MAP OF N. 2 MINE
 PROJECTED WORKING AREAS. JUNE 1 1968 TO DEC. 1 1968
 SCALE 1" = 100'

Hwy cut through into old work for nags

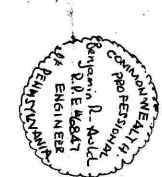

10/1/68
 P. C. C.