



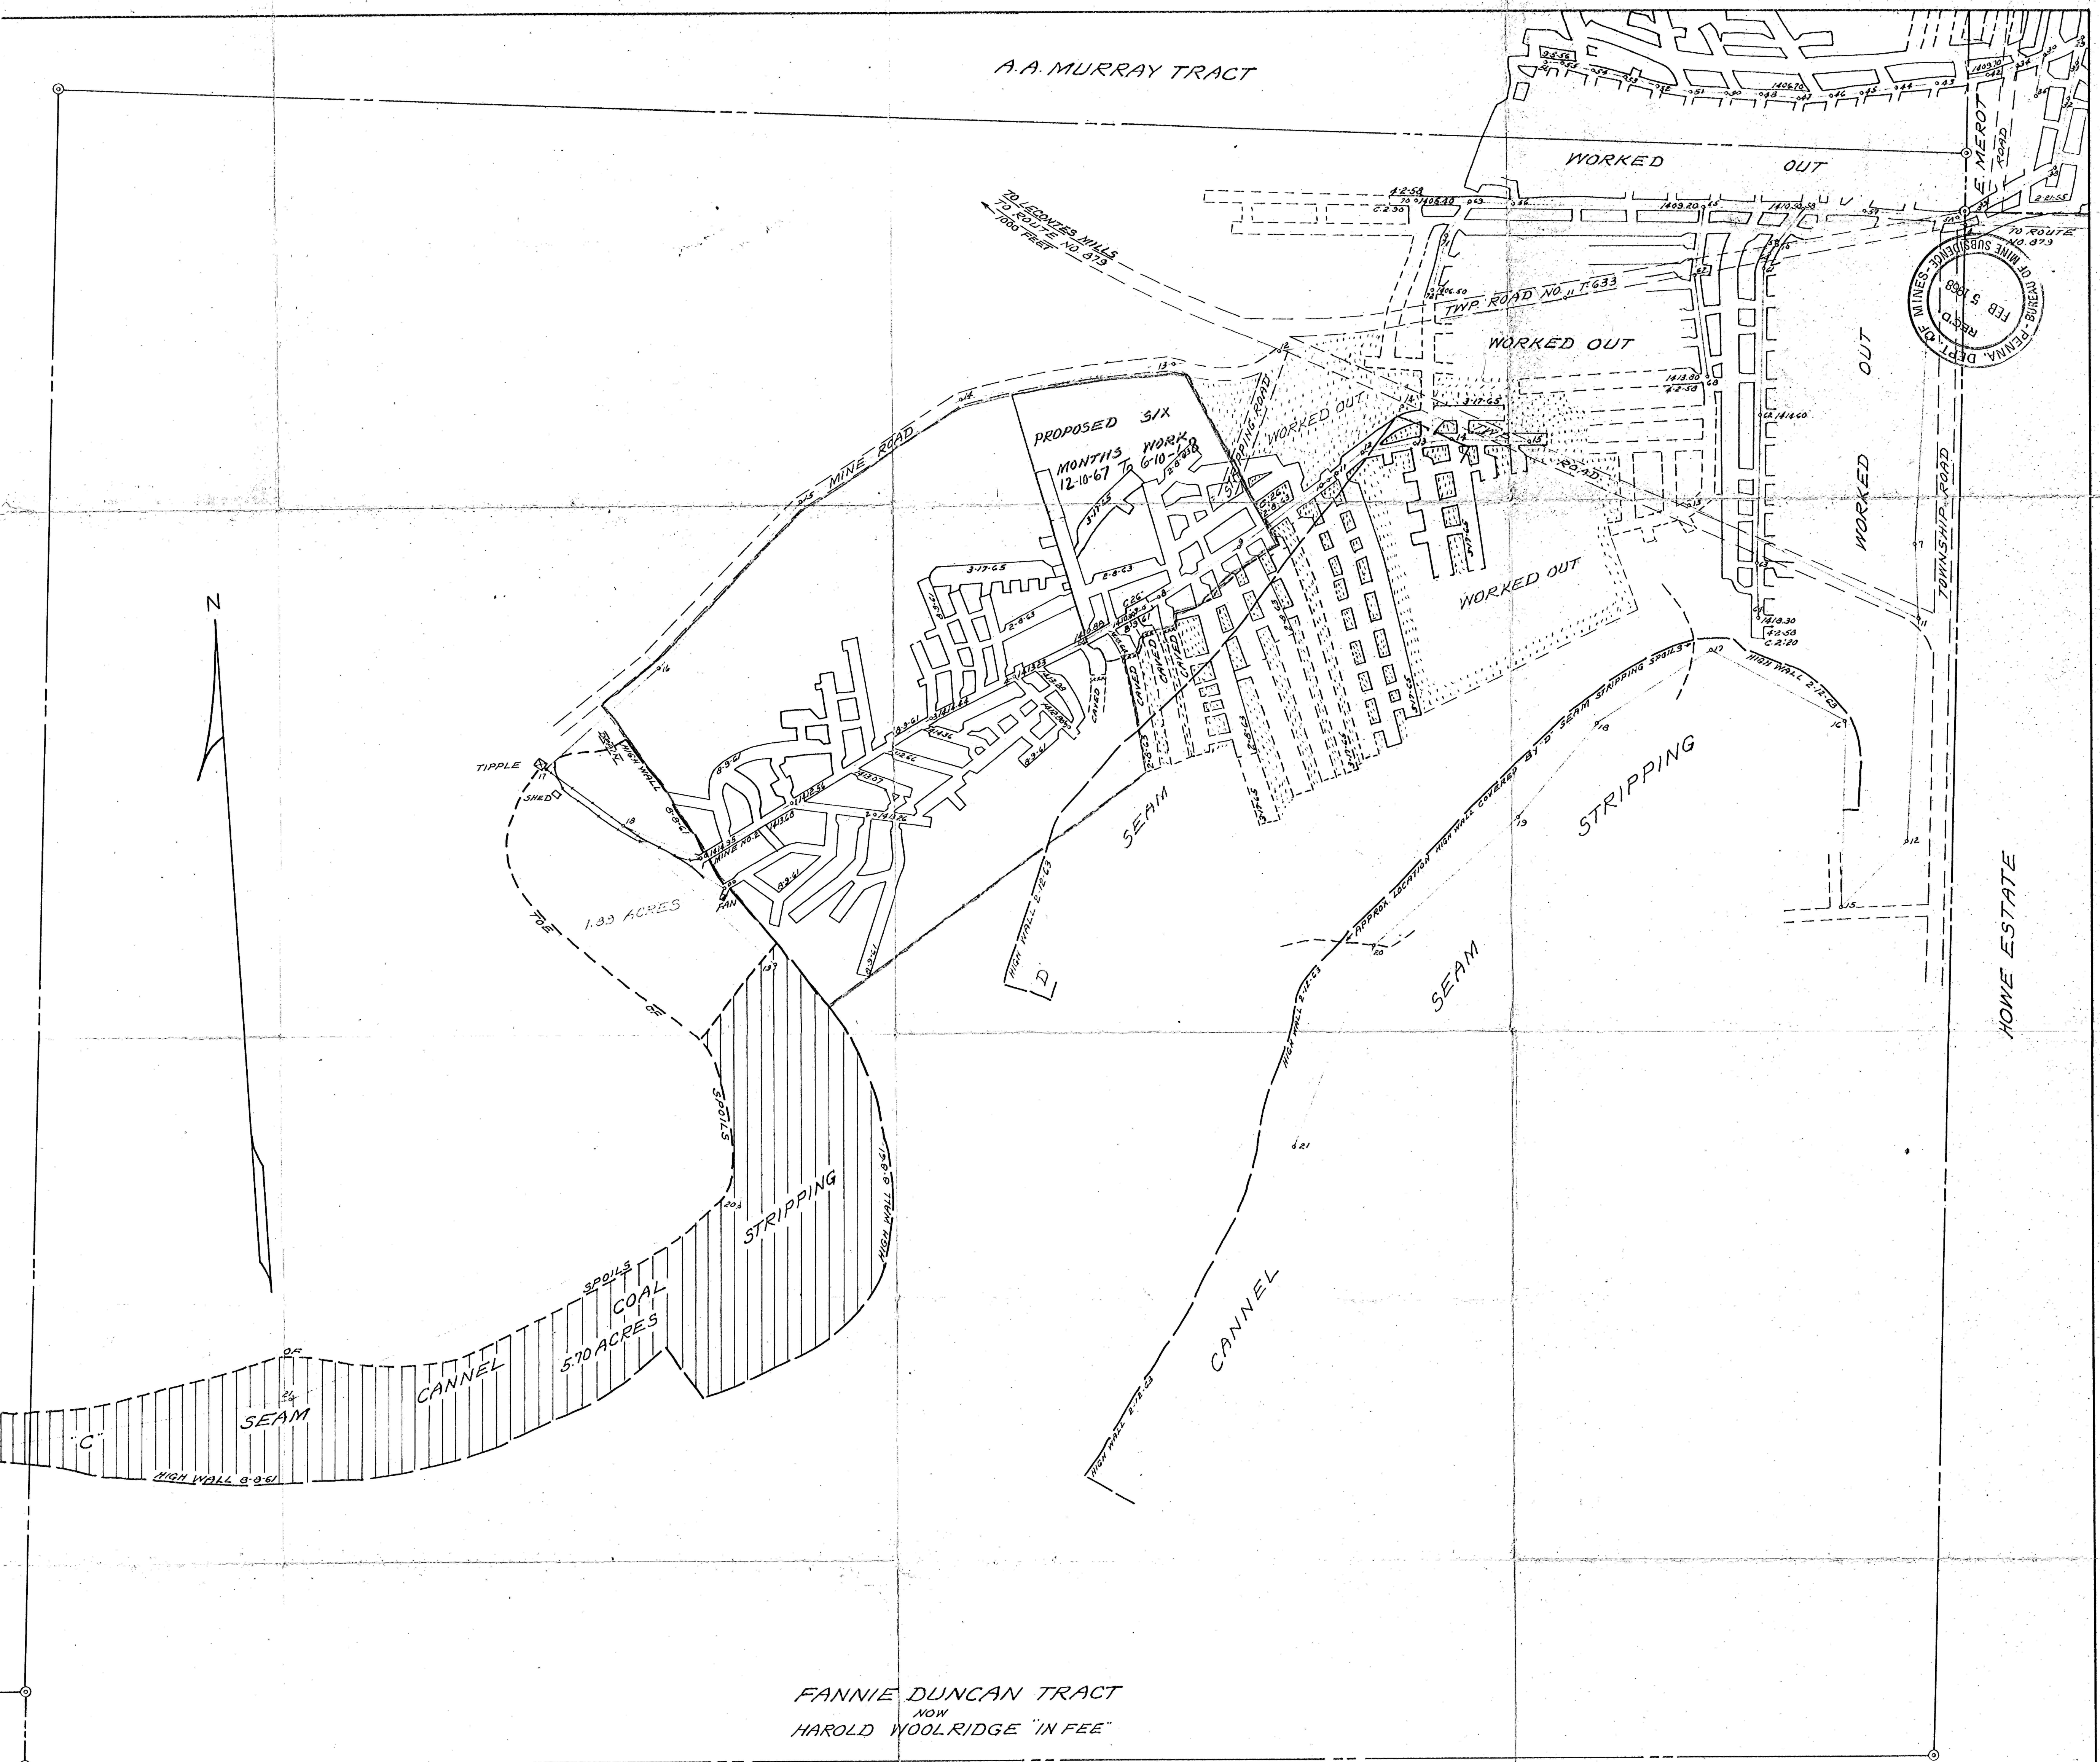

NOTE:
8-10-61 BACKFILLED & LEVELED 7.58 ACRES
AREA LEFT TO BE MINED 10.00 ACRES IN YELLOW
AREA OUTLINED IN RED PROPOSED SIX MONTHS WORK 12-10-68 TO 6-10-69

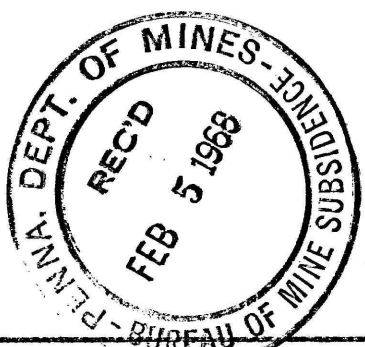

— MAP OF 'C' SEAM CANNEL COAL MINE —
— OPERATED BY W. B. MARTELL —
— GIRARD TOWNSHIP CLEARFIELD COUNTY PENNA. —
— SCALE 1"=100' — — AUG. 10, 1961 —
— BERNARD LUCAS ASSOCIATES —

#1732
12-11-99
c.c.