


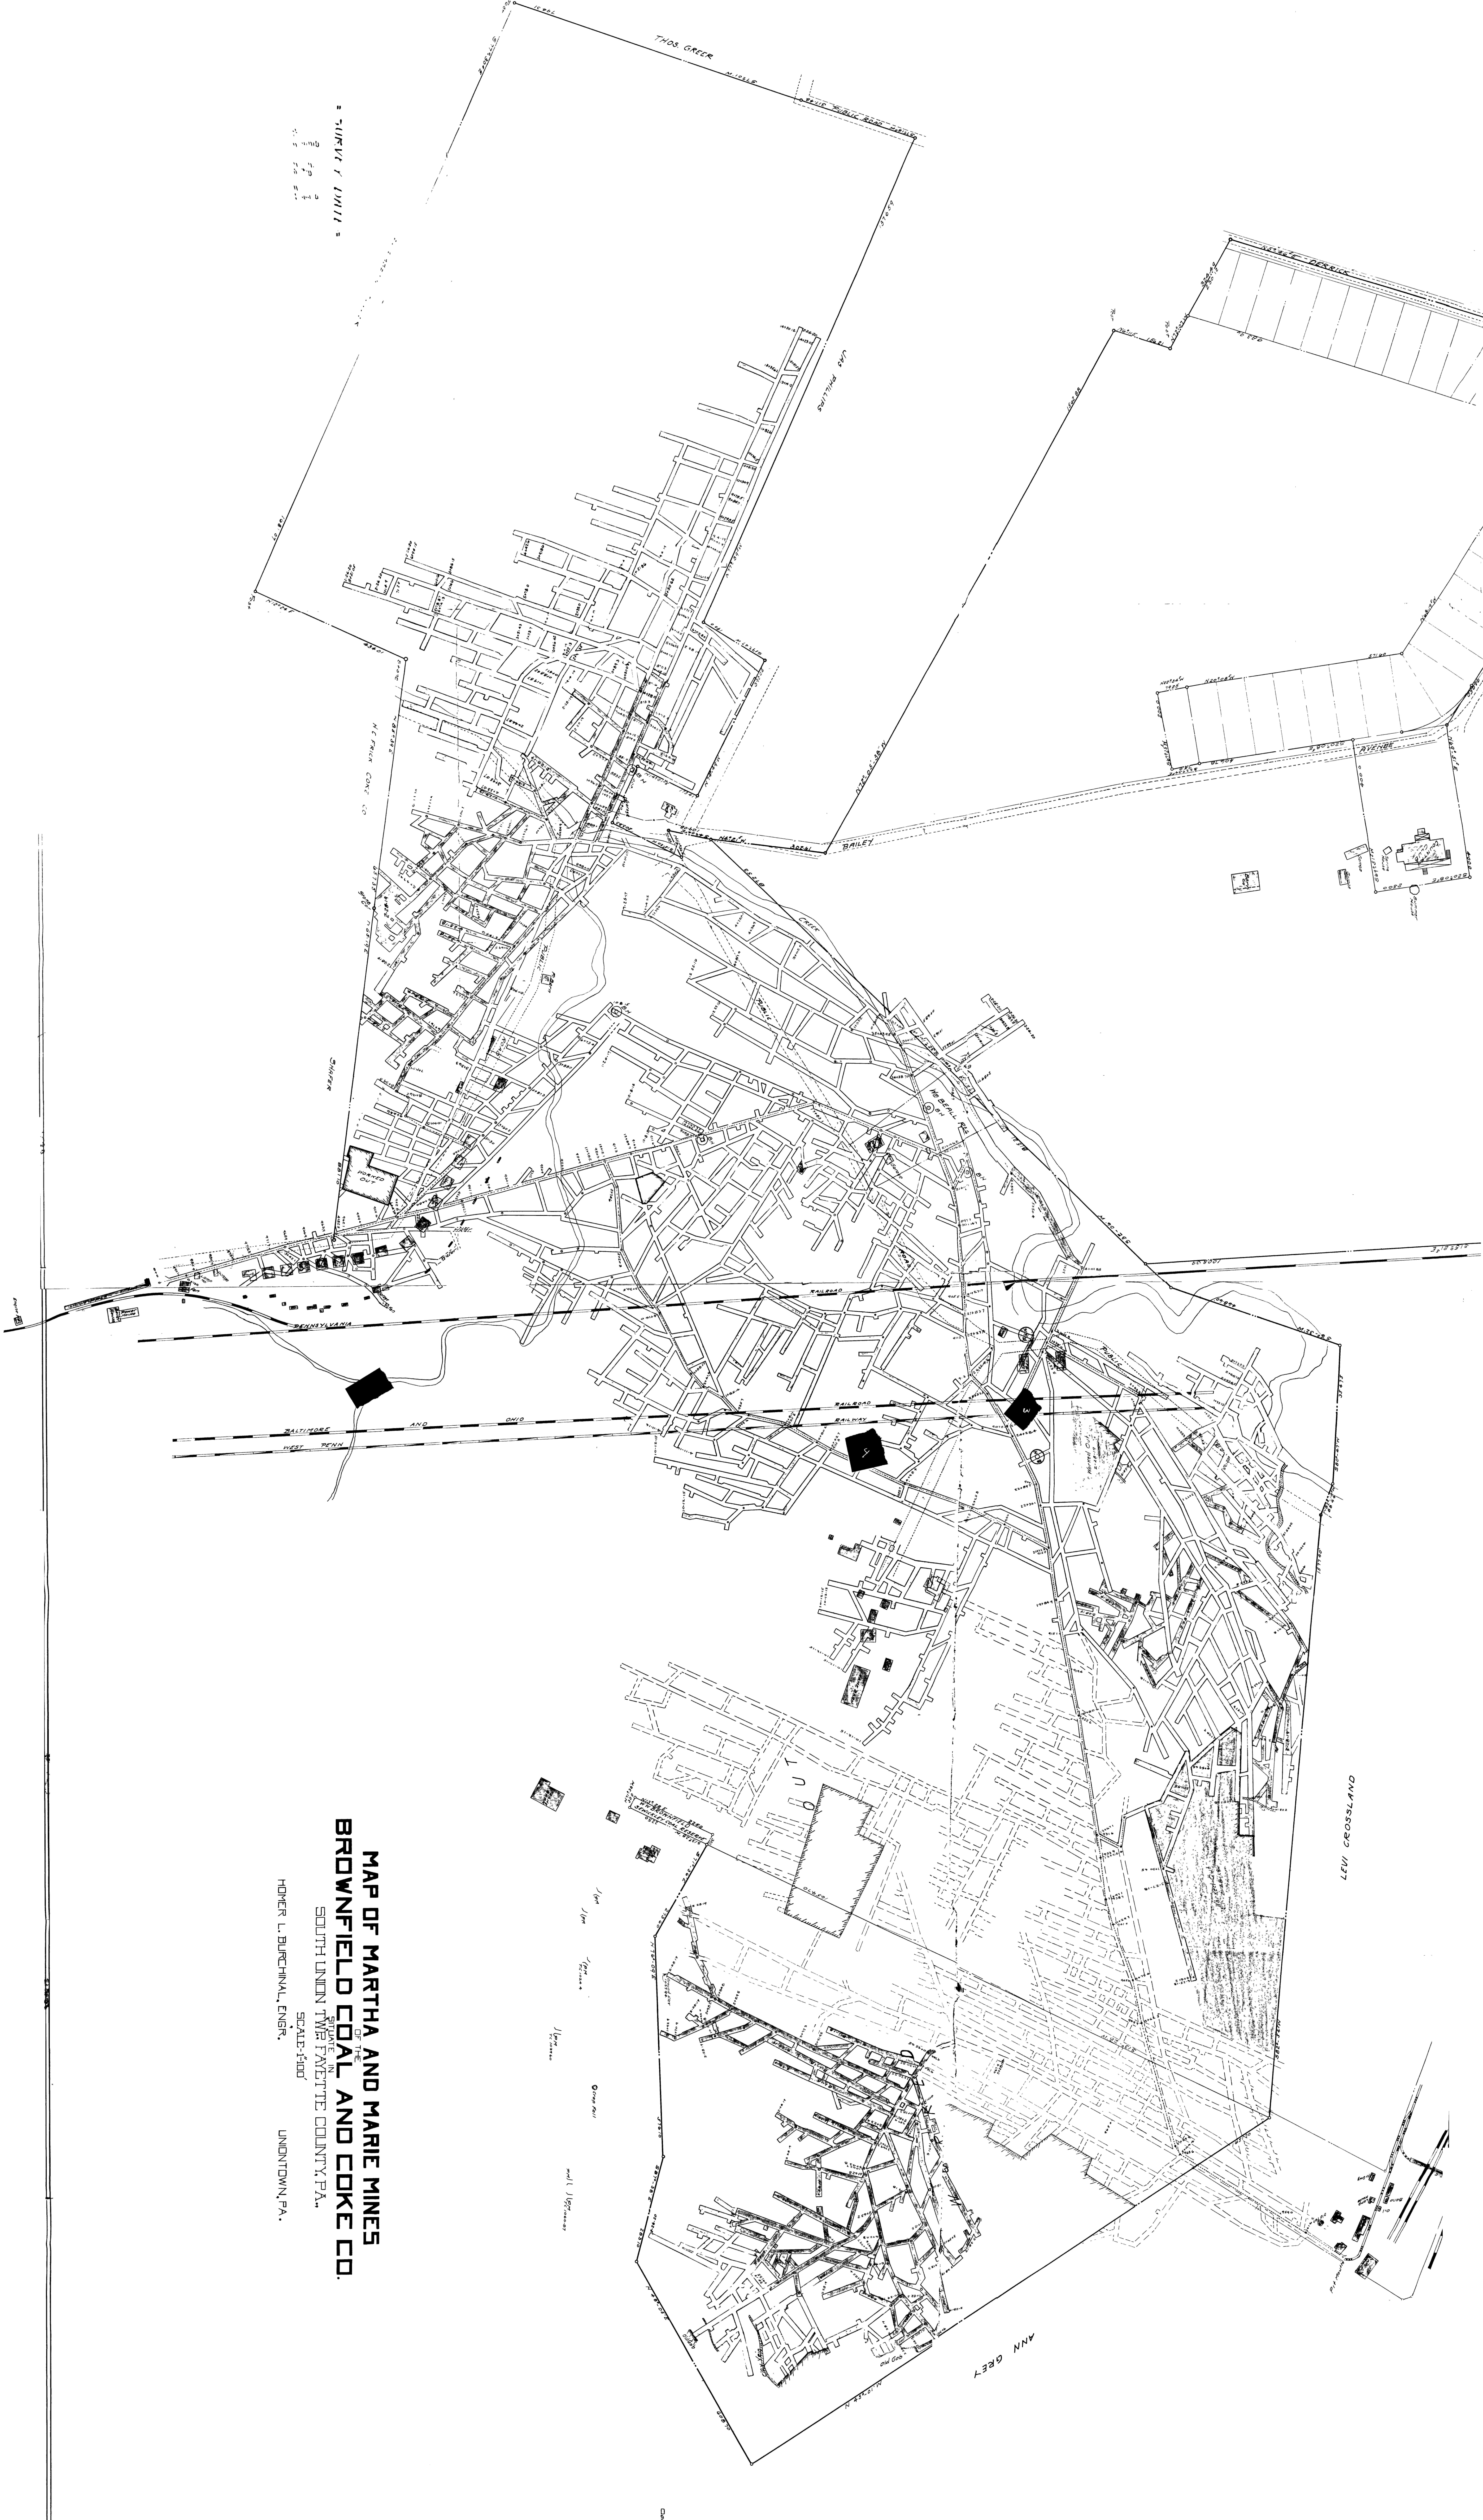

UNIONTOWN, PA.
1911

MAP OF MARTHA AND MARIE MINES
OF THE
BROWNFIELD COAL AND COKE CO.
SCALE 1:100'

HOMER L. BURCHINAL, ENGR.
UNIONTOWN, PA.