


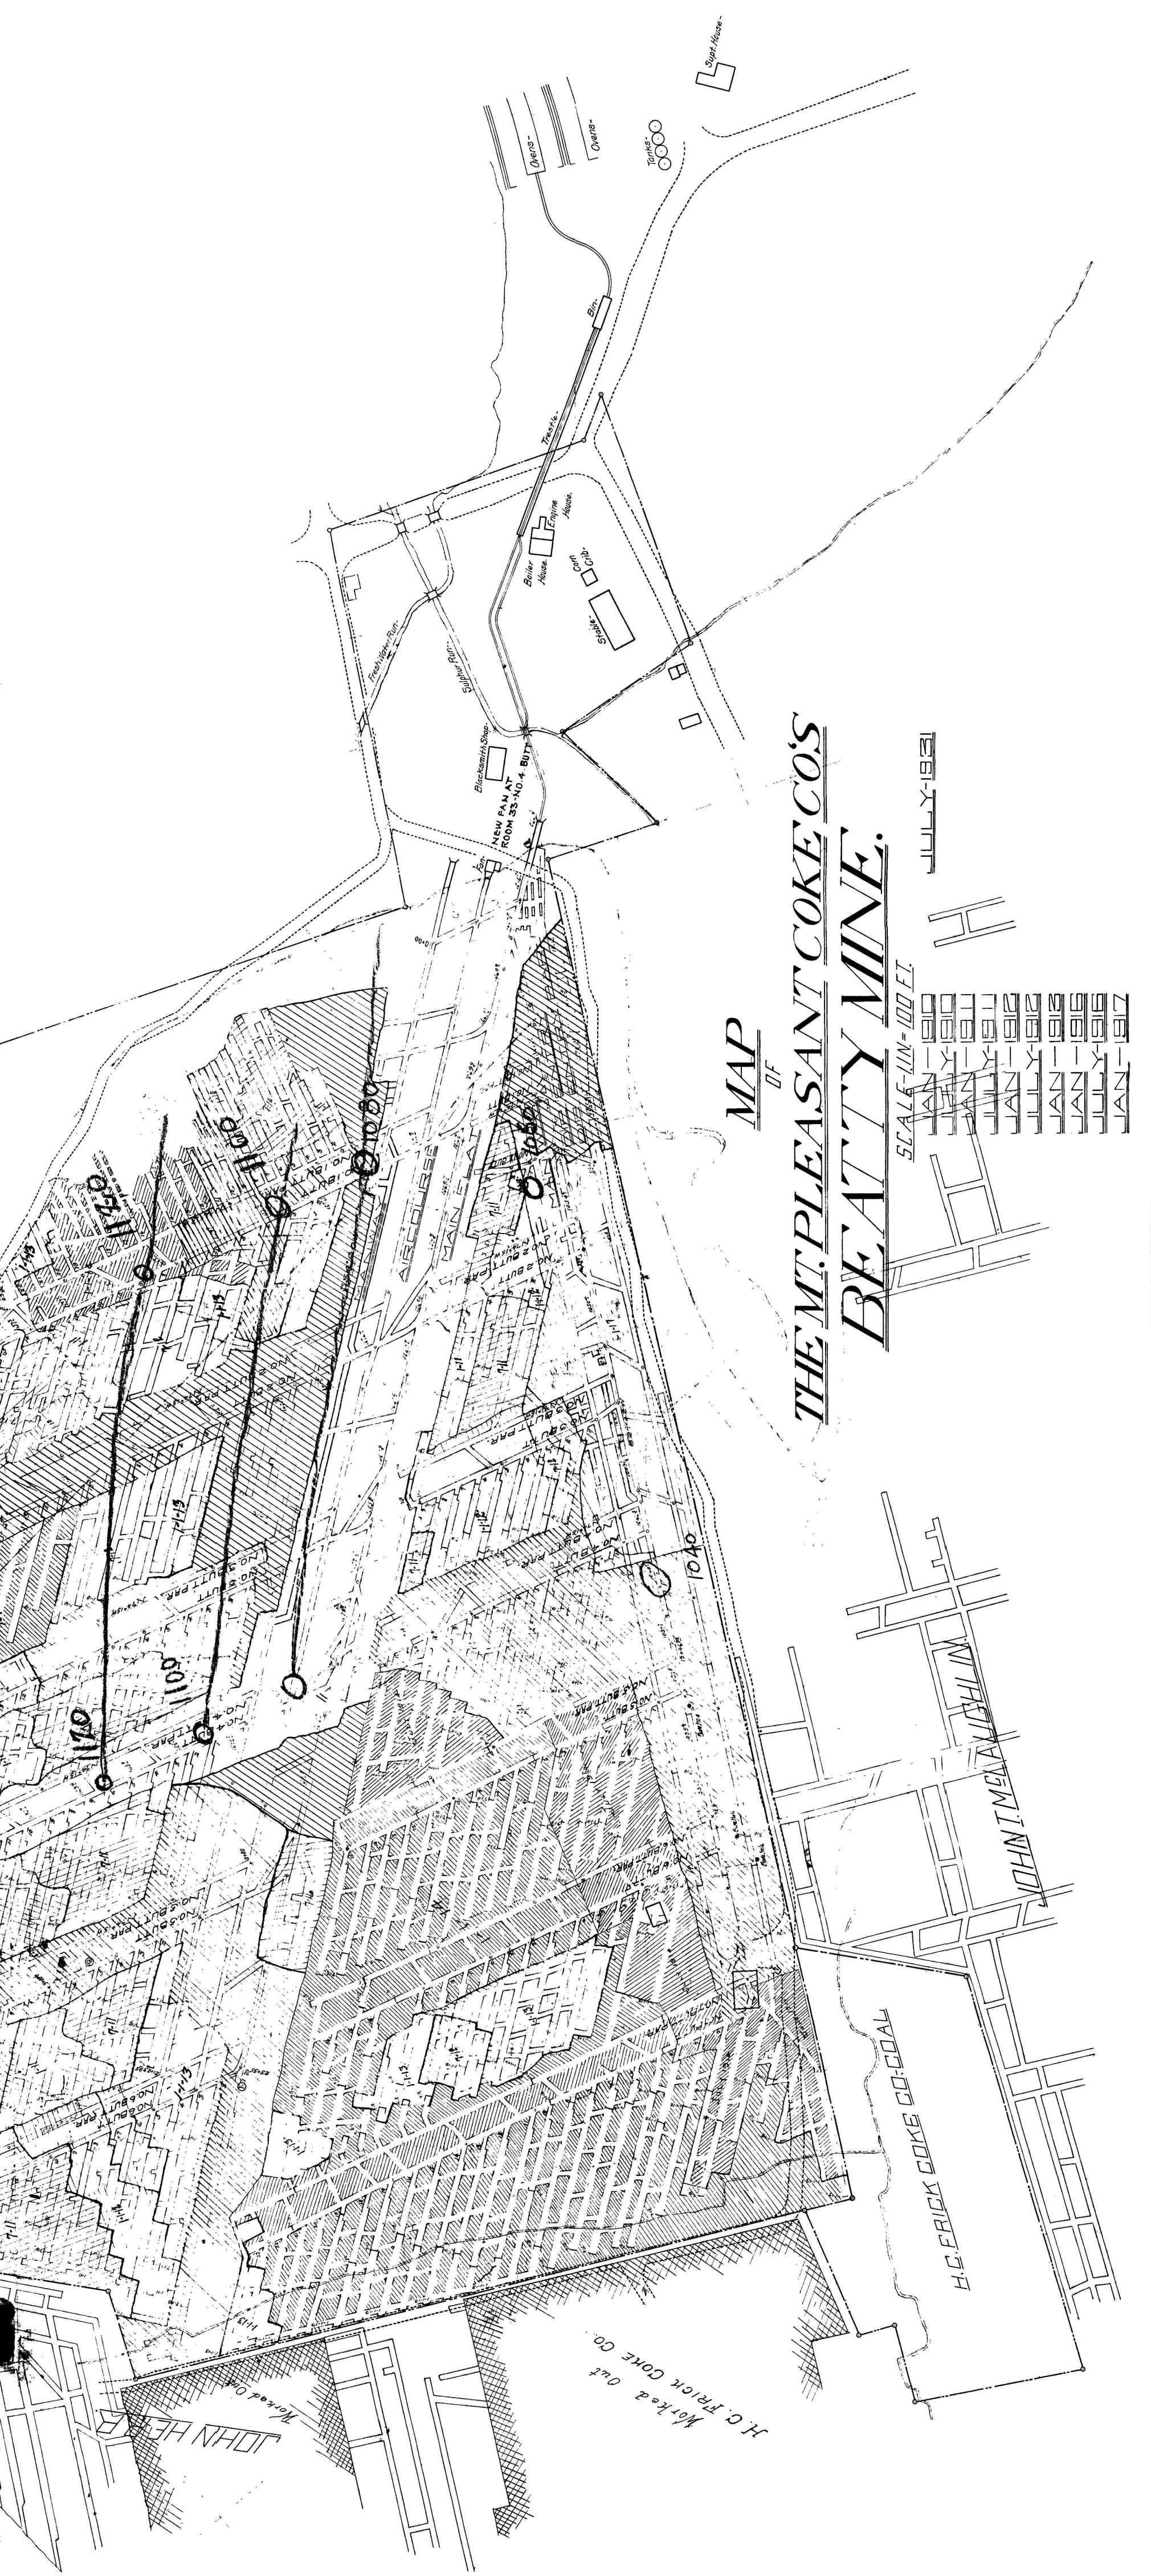

MAP
OF
THE MT. PLEASANT COKE CO'S
BEATTY MINE.