2-C

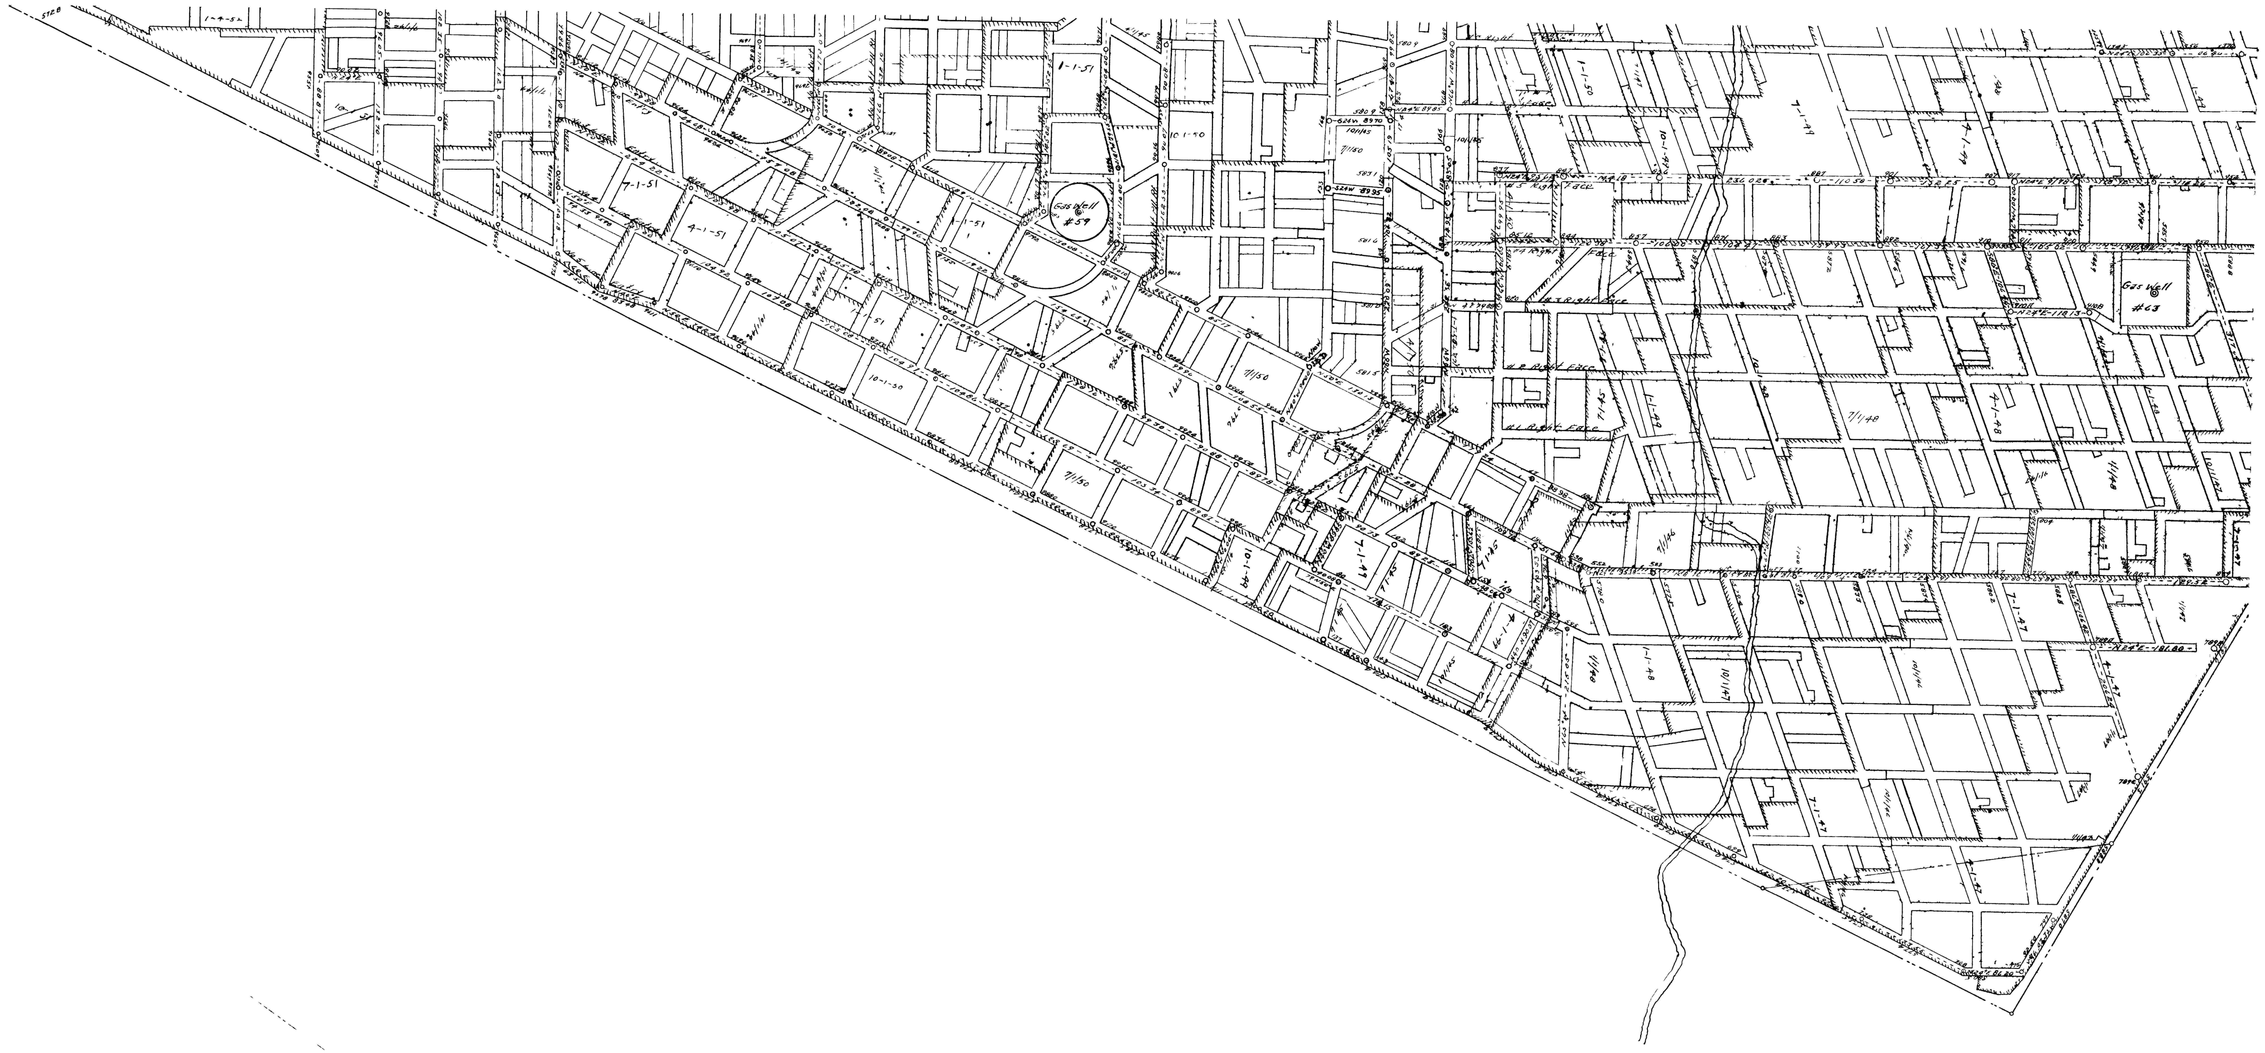
Gas Well #59
Gas Well #63
1-1-51
7-1-51
4-1-51
10-1-50
7/1/50
7-1-49
4-1-49
1-1-49
10/1/49
7-1-47
4-1-47
10-1-48
7/1/48
4-1-48
1-1-48

2-C