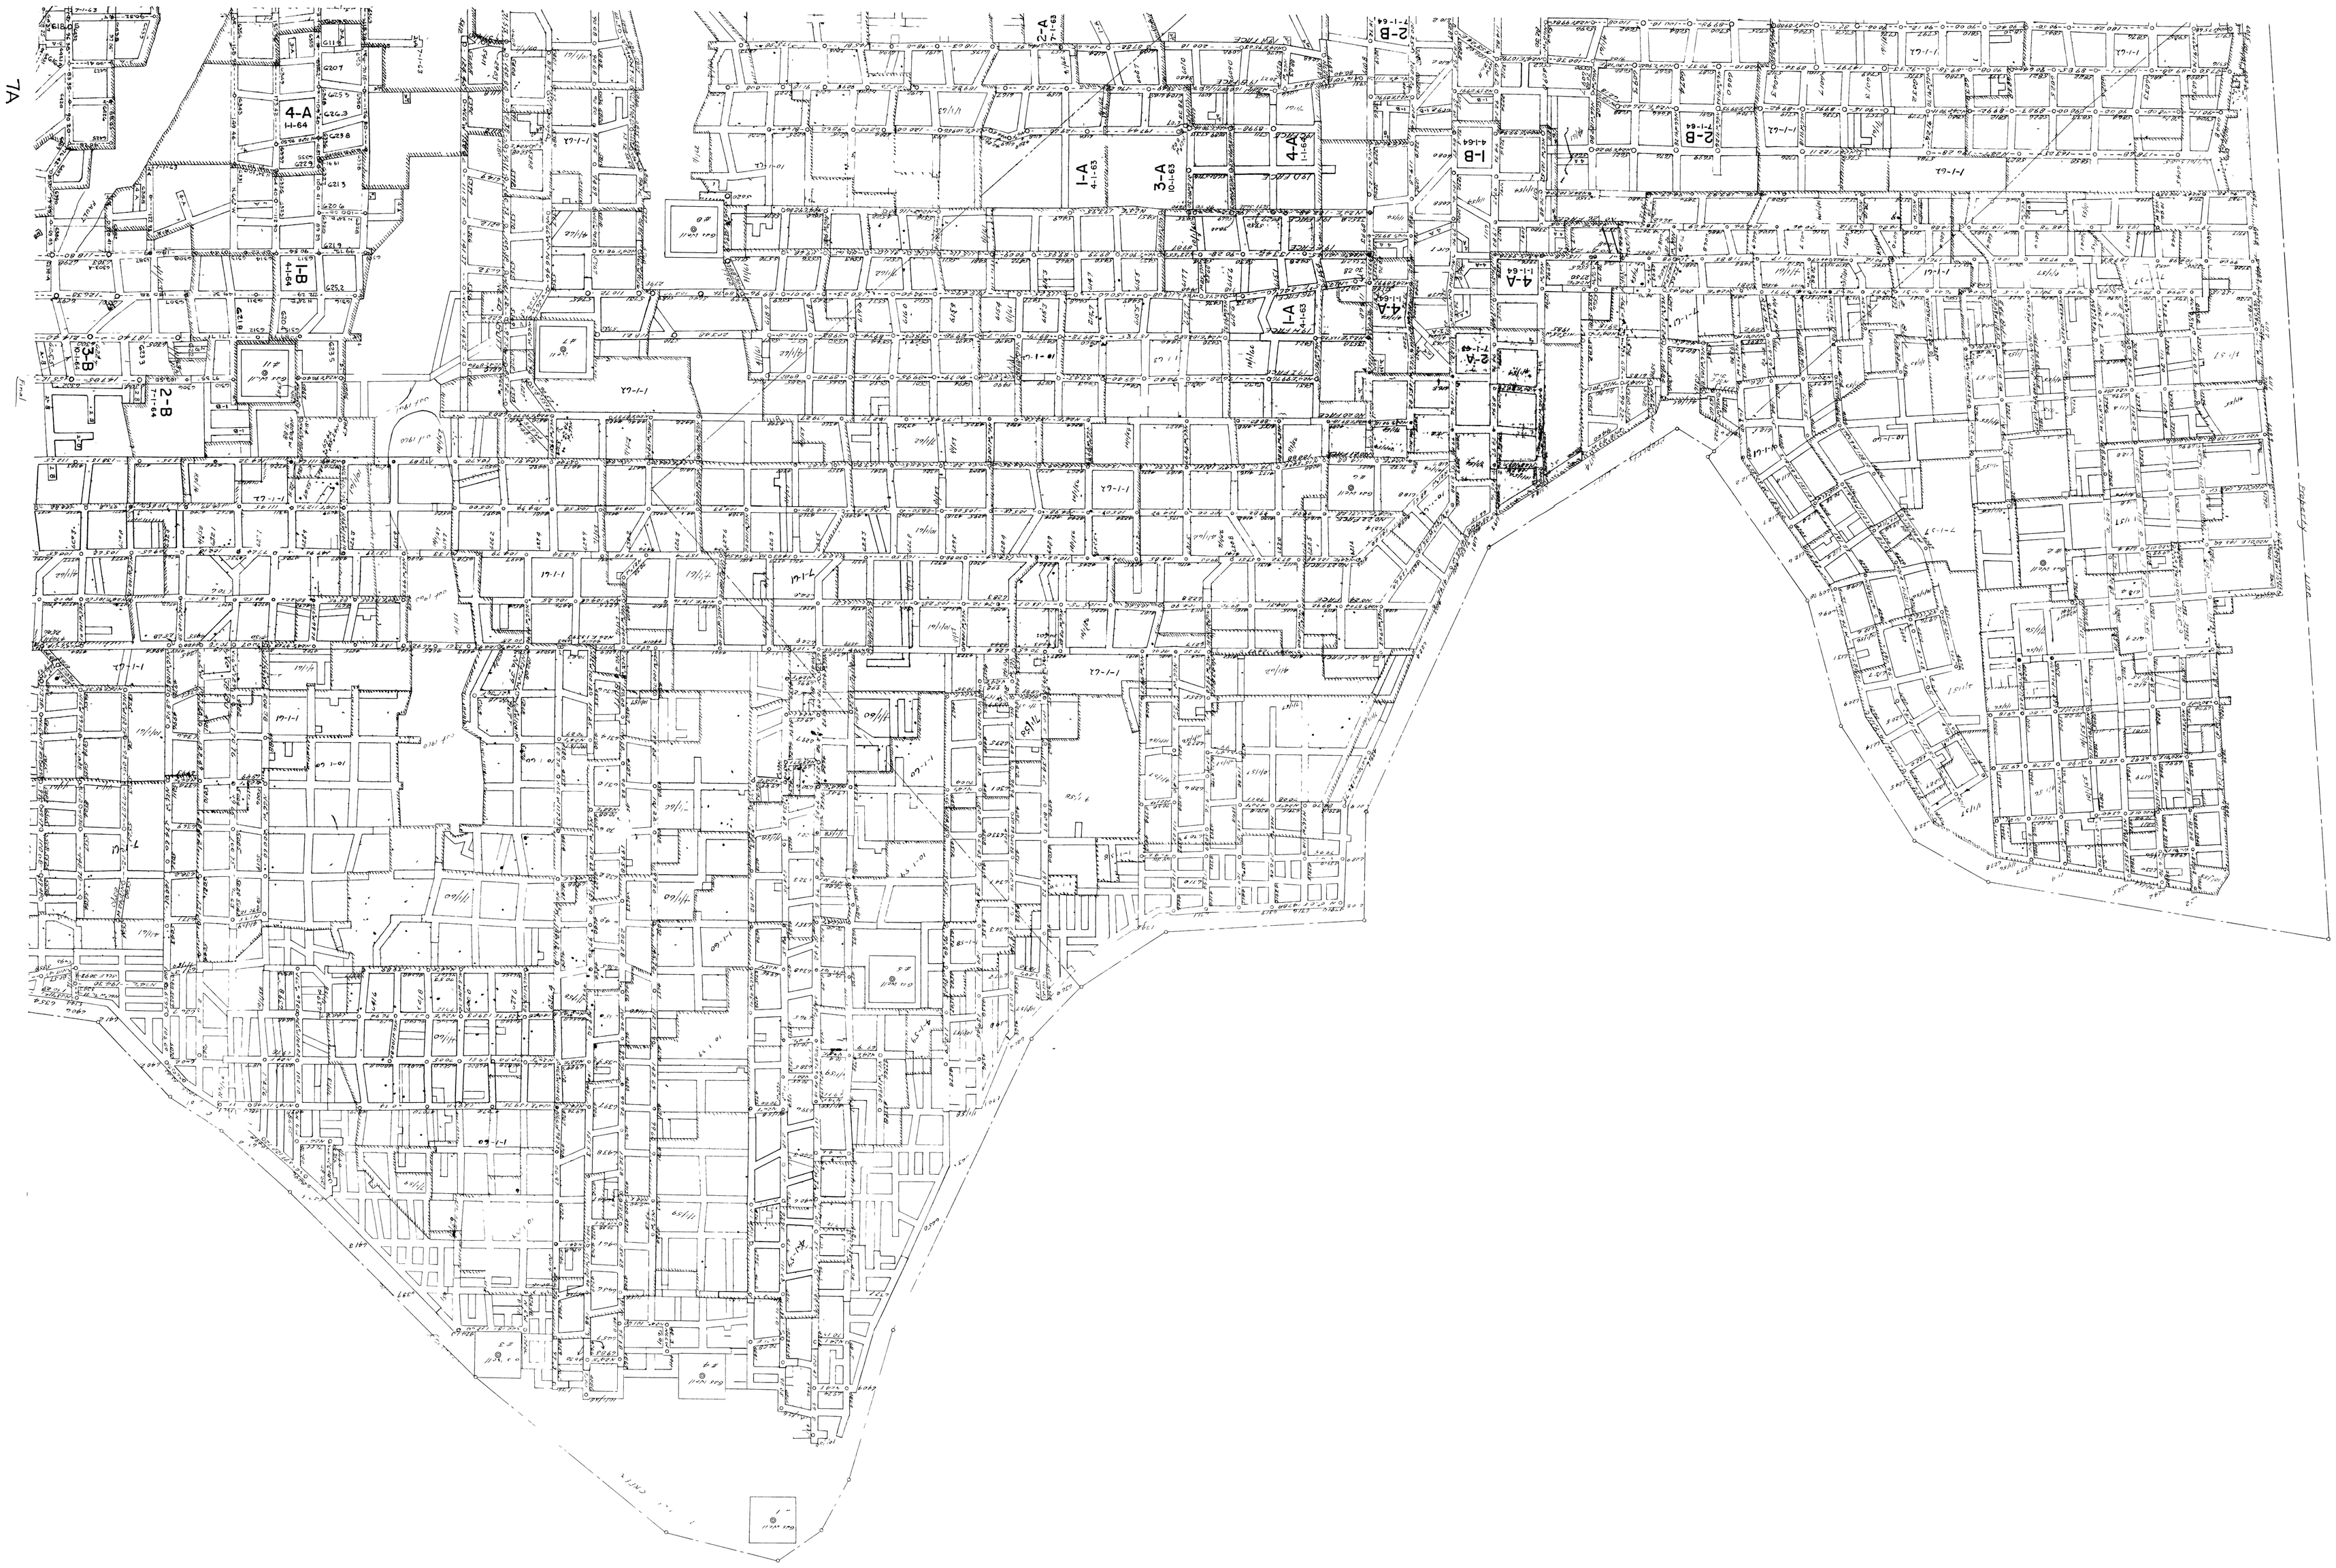
4-A
11-64
1-B
4-1-64
2-B
7-1-64
1-A
4-1-63
3-A
10-1-63
2-A
7-1-63
4-A
11-1-64
1-B
4-1-64
2-B
7-1-64