


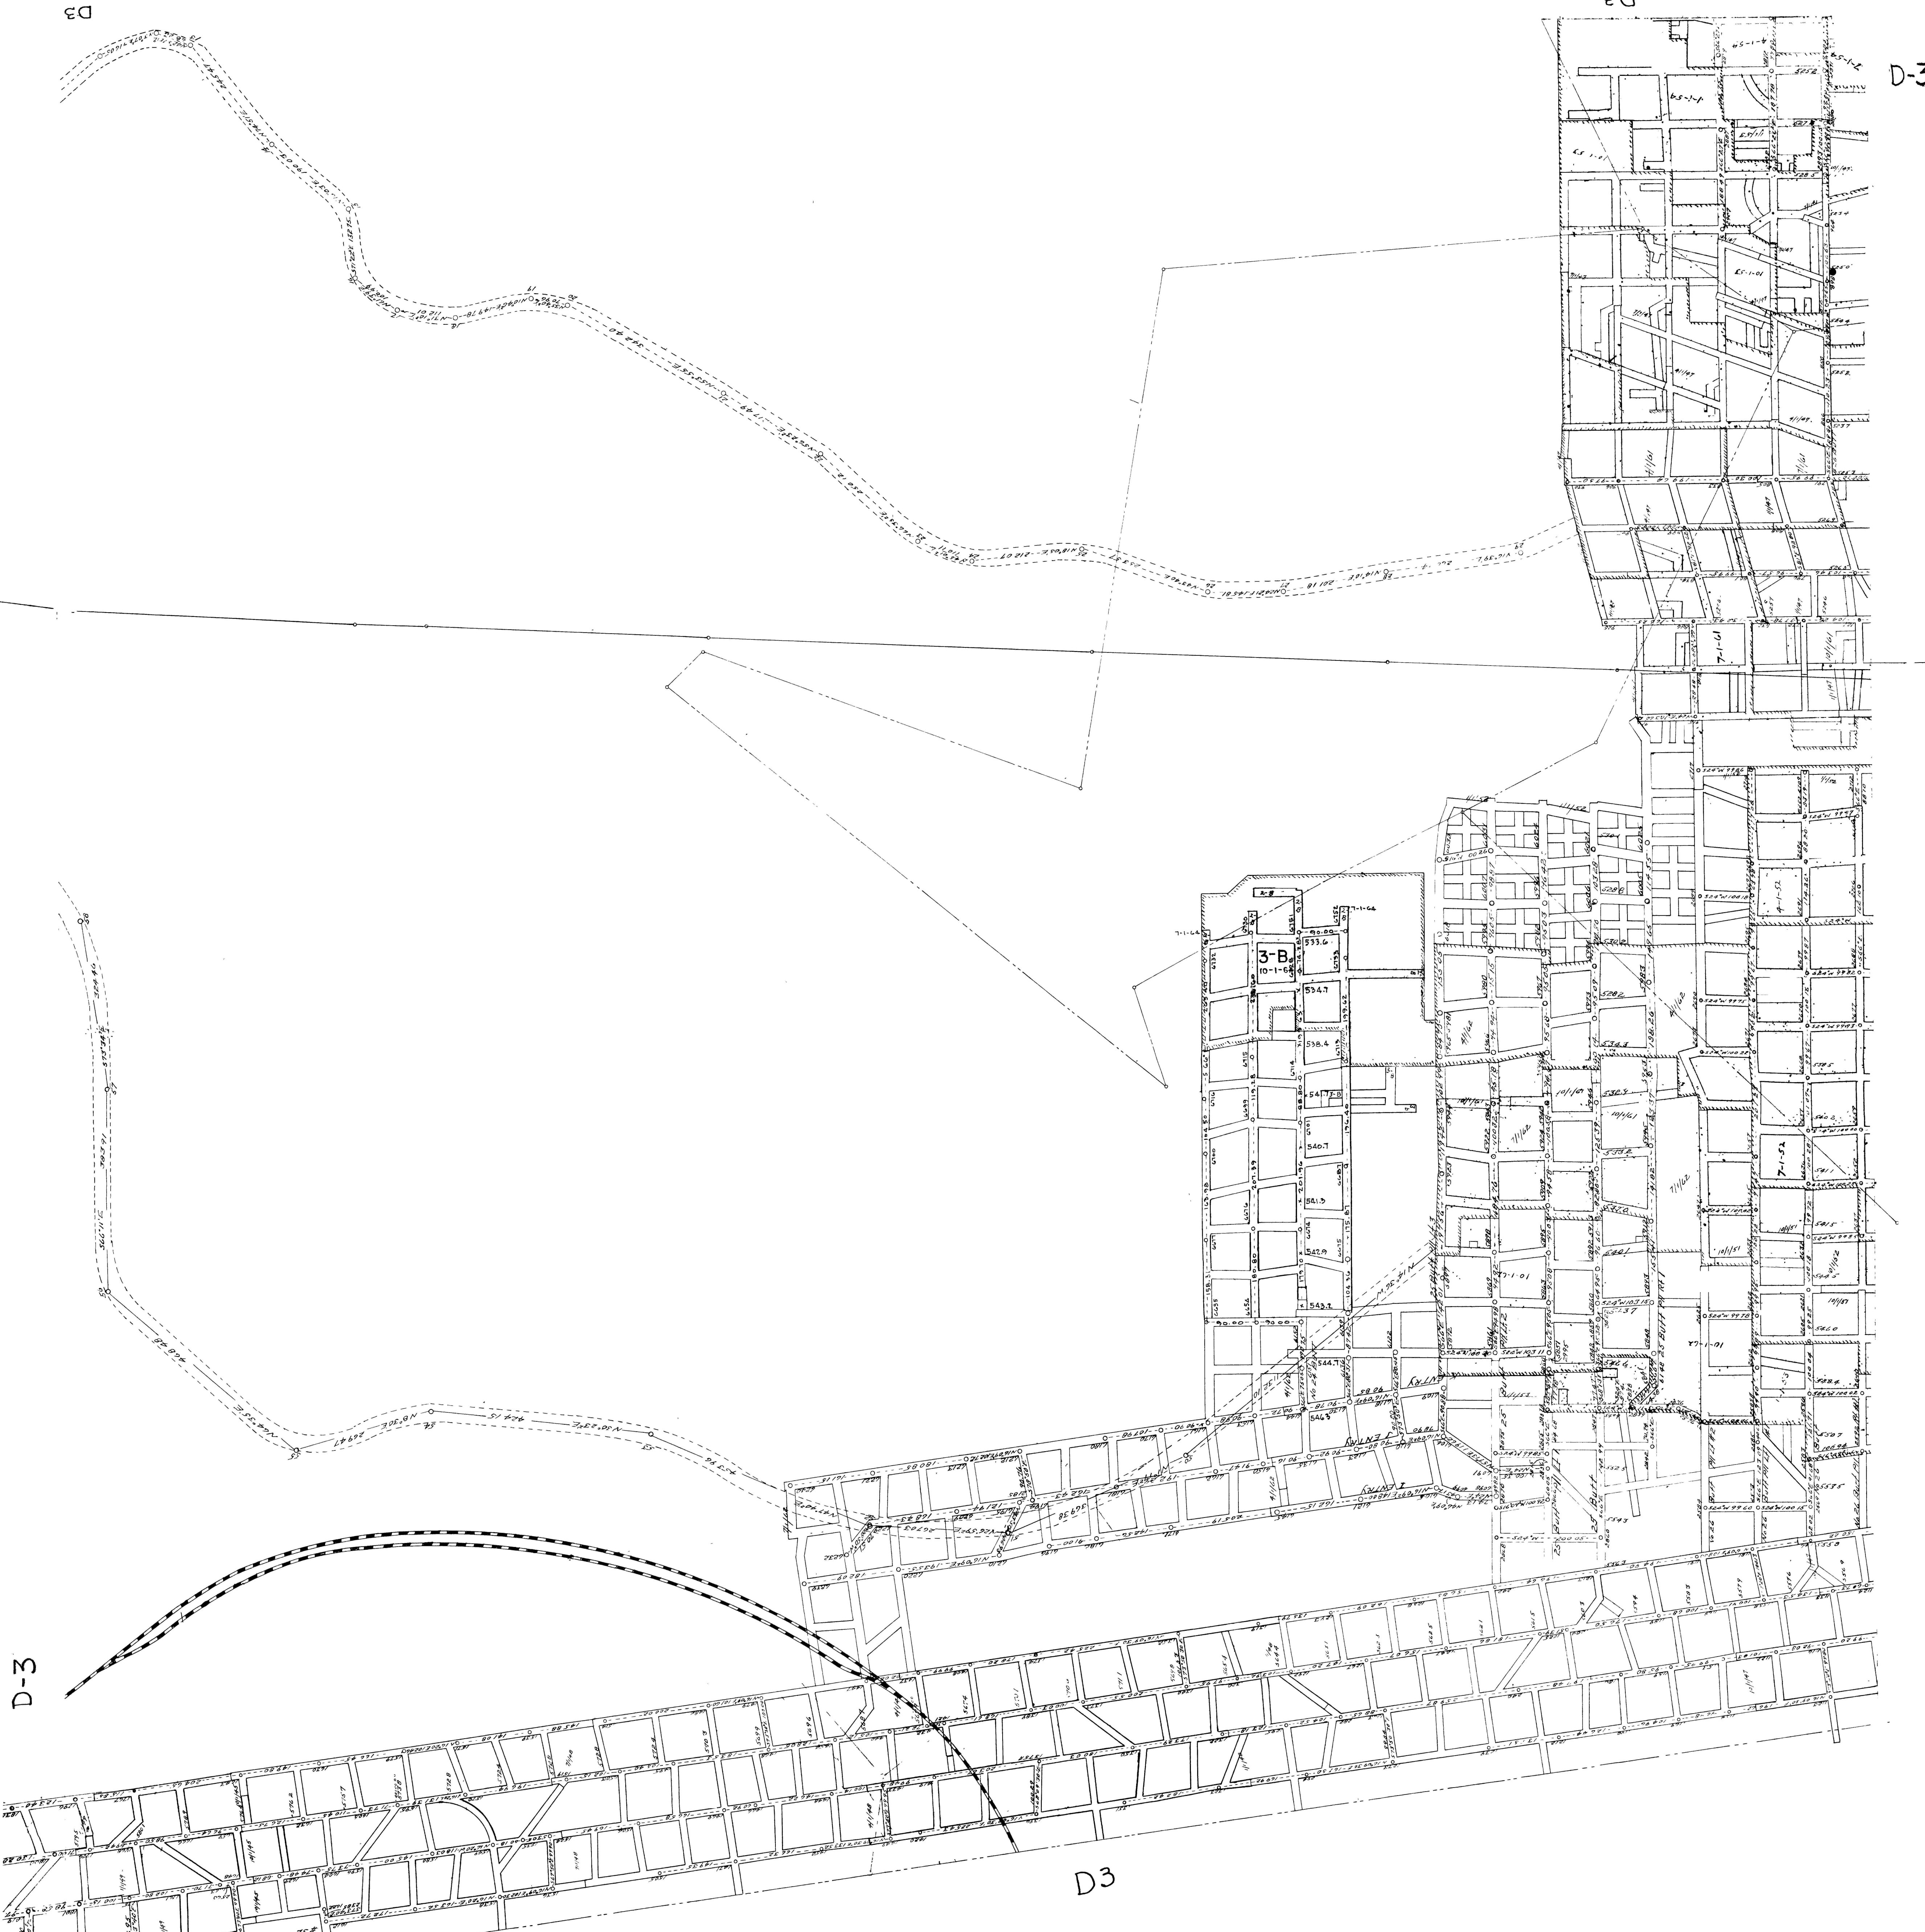

D-3

D3

D-3

D3

D3