


DANIEL REITZ

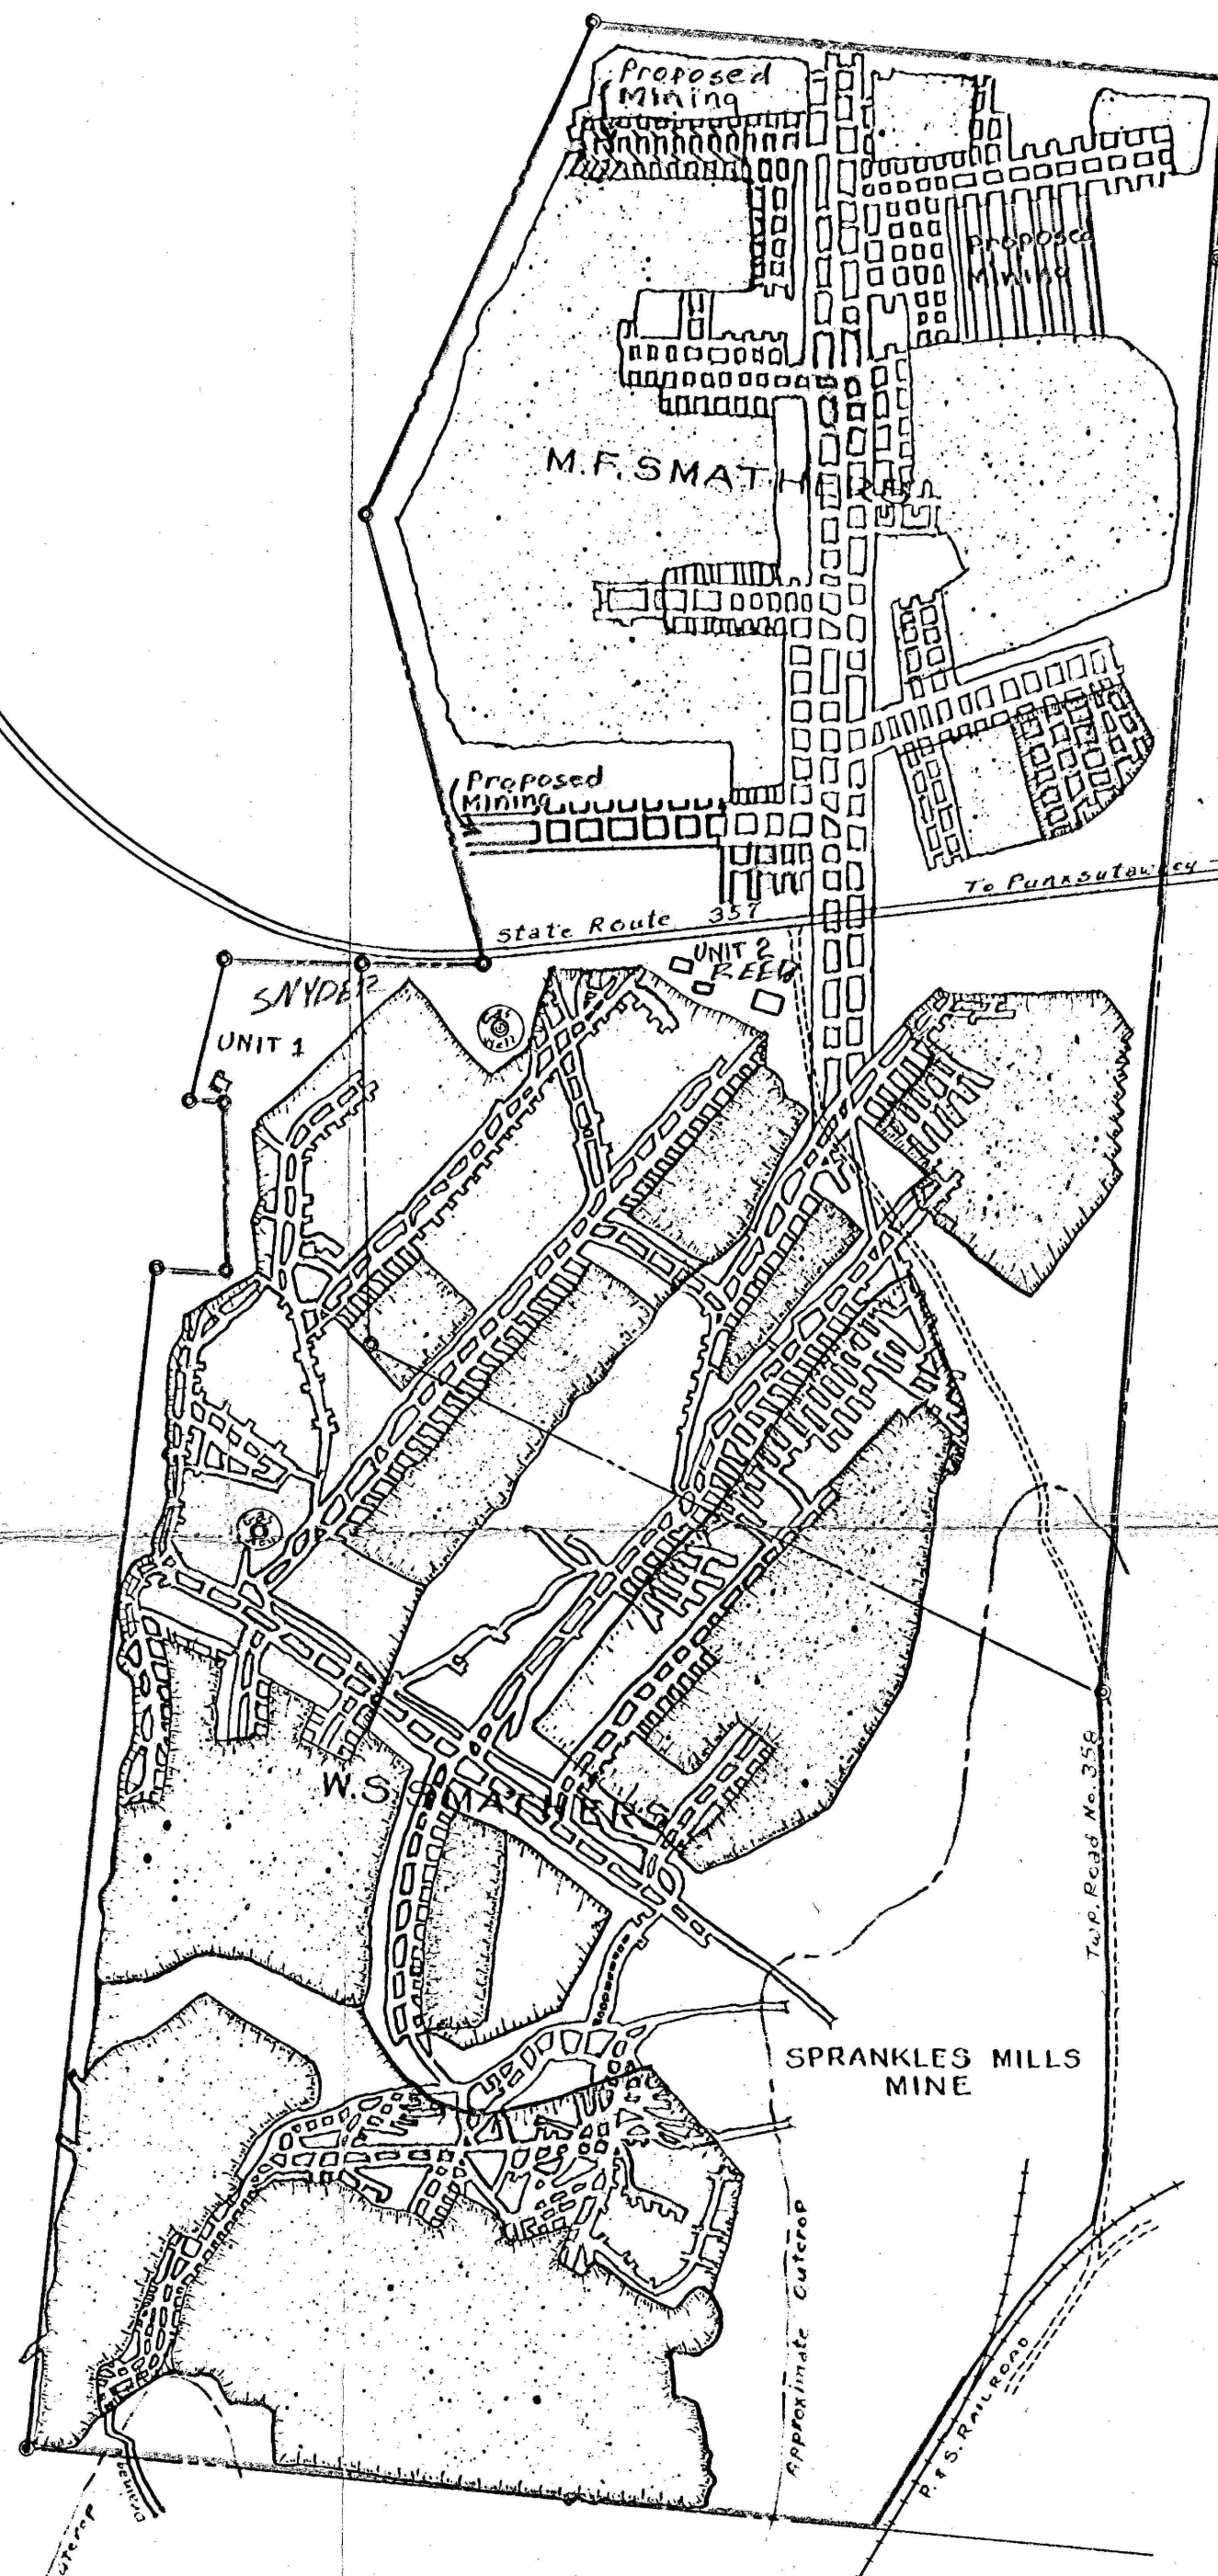

FIELD COBA

LULA BLOSE BARNETT

PHILLIP SMATHERS

JAMES CAYLOR



-N-

MINE | MAP

SPENCER AND MAUK COAL CO., INC.


SPRANKLES MILLS MINE

AND

WORTHVILLE MINE

RINGGOLD TOWNSHIP, JEFFERSON COUNTY, PA.

SCALE: 1"=400' JUNE 8, 1956

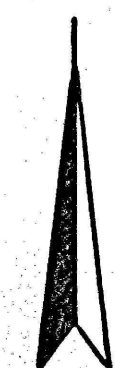

Eugene F. Long RS 10067E