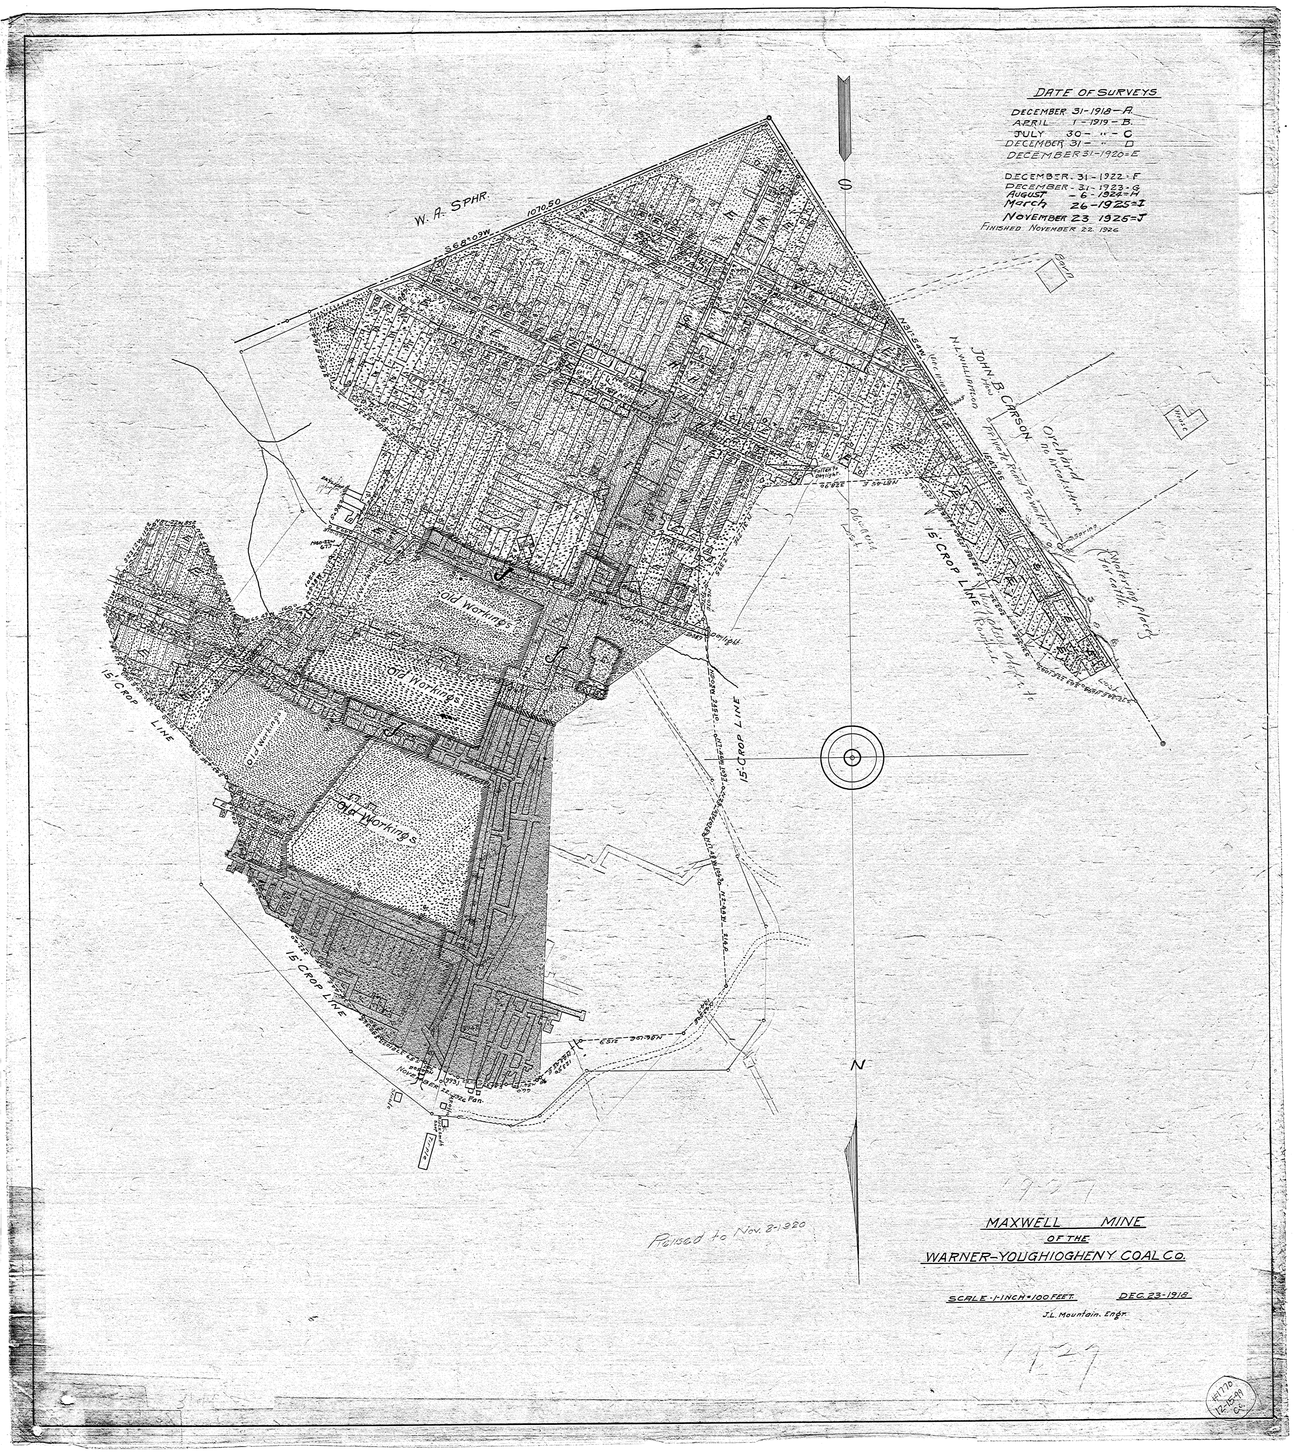
DATE OF SURVEYS
DECEMBER 31-1918-A.
APRIL 1-1919-B.
JULY 30-" -C
DECEMBER 31-" -D
DECEMBER 31-1920-E
DECEMBER 31-1922-F
DECEMBER 31-1923-G
AUGUST 6-1924-H
MARCH 26-1925-I
NOVEMBER 23 1926-J
FINISHED NOVEMBER 22, 1926
S
N
W. A. SPAHR
JOHN B. CARSON
Old Workings
15' CROP LINE
MAXWELL MINE
OF THE
WARNER-YOUGHIOGHENY COAL CO.
SCALE 1 INCH = 100 FEET
DEC. 23-1916
J.L. Mountain, Engr.
Revised to Nov. 21-1920
1927
1929