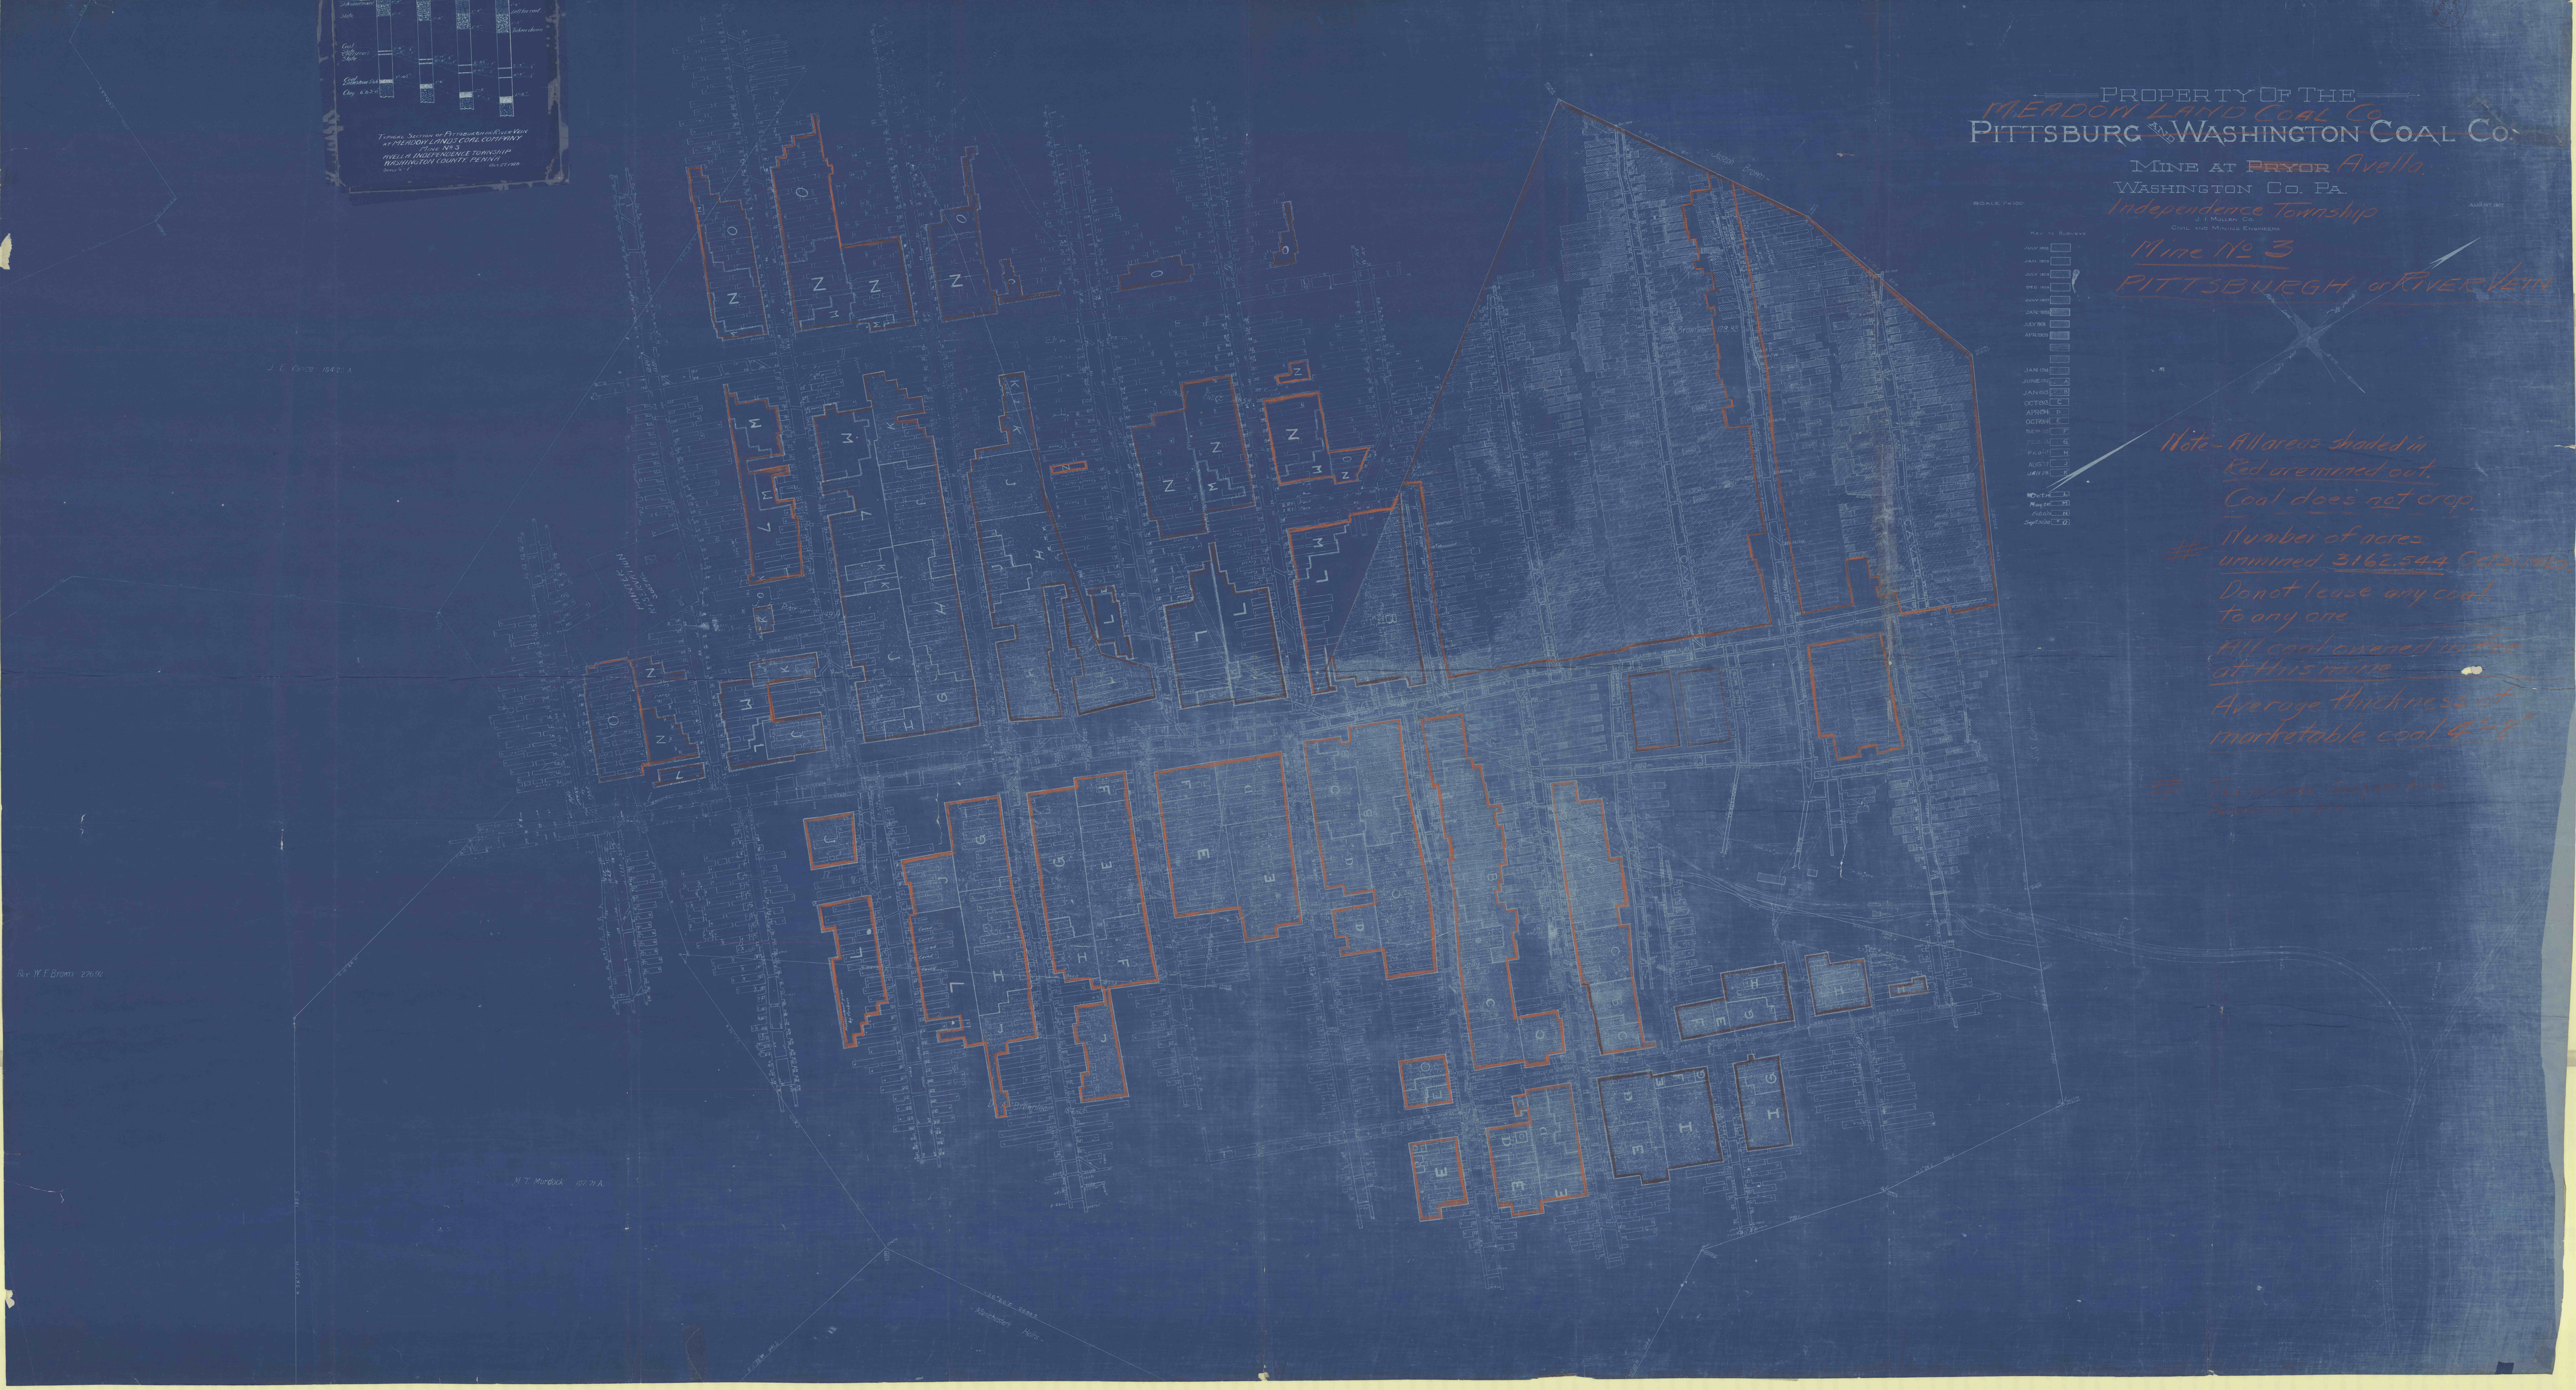
PROPERTY OF THE
MEADOW LAND COAL CO.
PITTSBURG & WASHINGTON COAL CO.
MINE AT ~~PRYOR~~ Avella,
WASHINGTON CO. PA.
Independence Township
Mine No 3
PITTSBURGH, or RIVER VEIN
Note - All areas shaded in Red are mined out.
Coal does not crop.
Number of acres unmined 3162.544
Do not lease any coal to any one
All coal owened in fee at this mine
Average thickness of marketable coal 4 ft 8 in
J. E. Force 1842 A
Per W. F. Brown 27.6.90
M. T. Murdock 1911 A.