


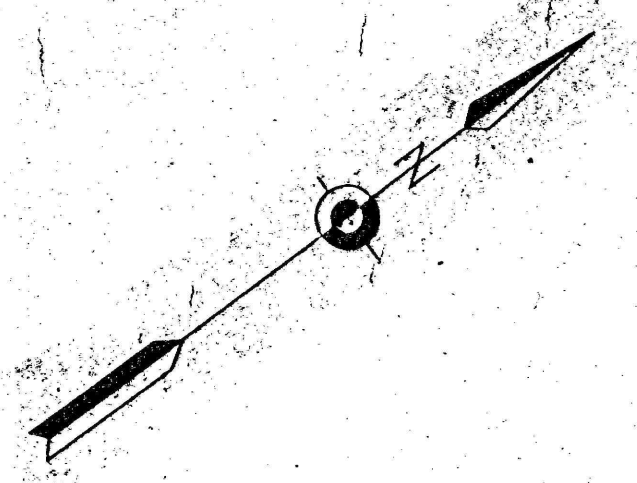


ARCH. NICKOL TR

MINE ABANDONED MAY 1966

SURF - PENNA GAME COMMISSION

J. M. COLEMAN TR

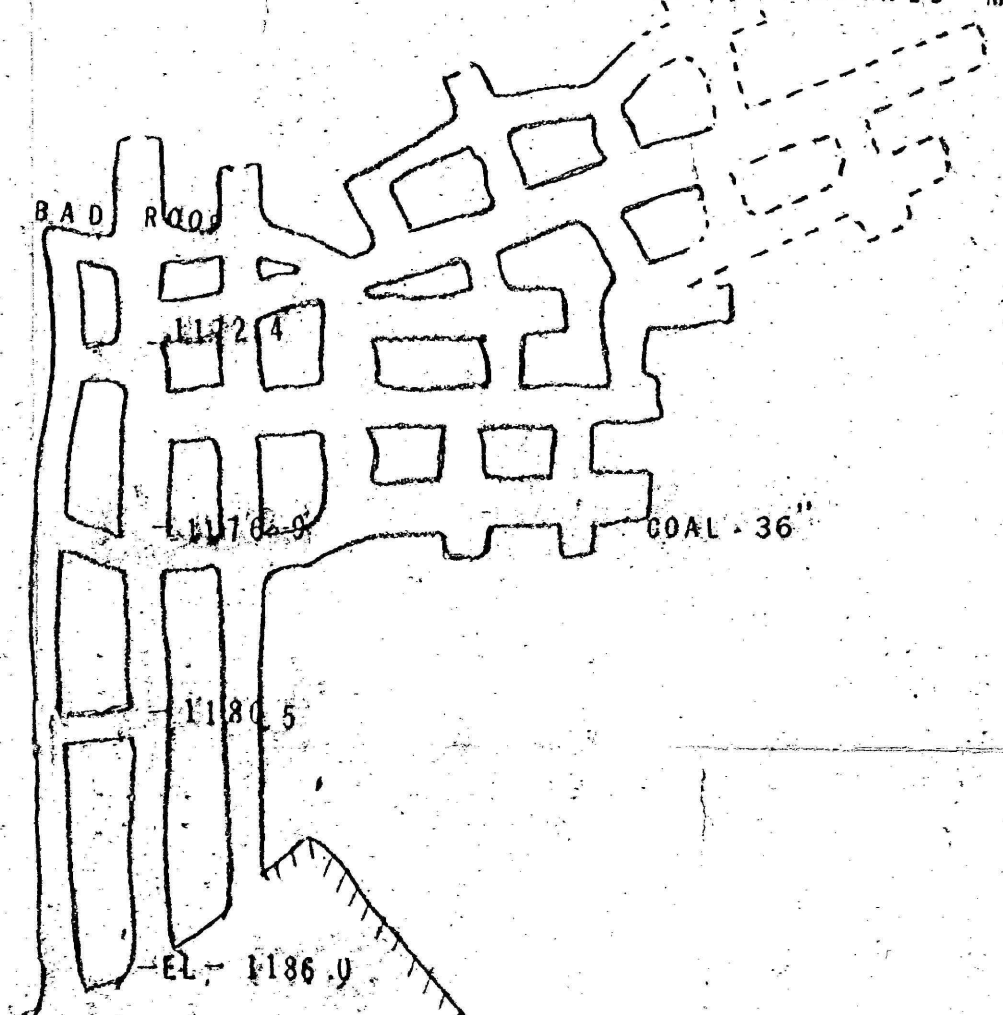


MINE STARTED NOV. 1965

SURF - PENNA. GAME COMMISSION

J. C. FYOCK TR

Note: Property line coordinated from office records.

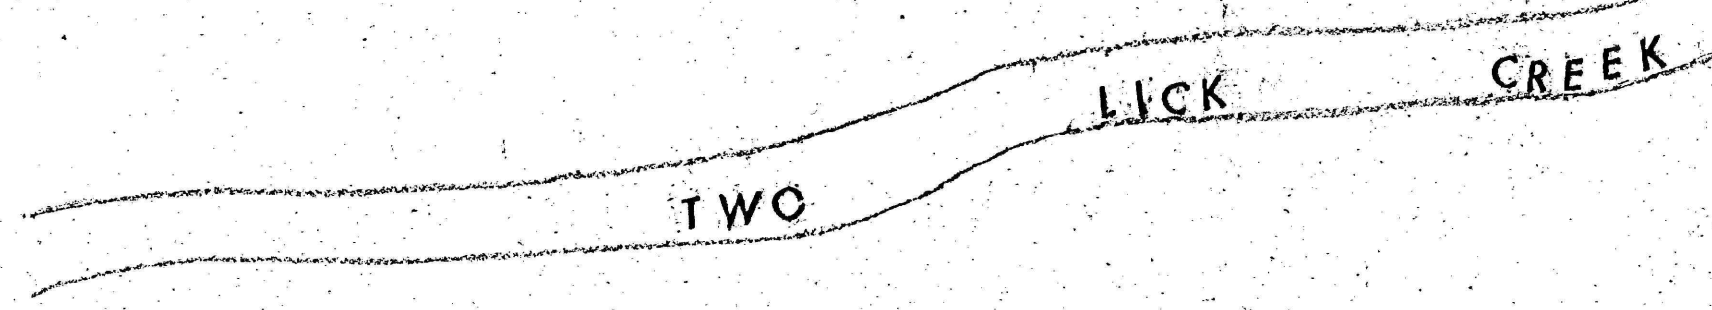

ABANDONED MINE MAP
COPPER VALLEY COAL CO.
CHERRYHILL TWP., INDIANA CO.
B-SEAM SCALE 1" = 100'
DATE 5-29-66
DRAWN BY JOHN C. BASSMORE

#1786
12-16-99
C.C.