


N 6° 39' E

2209.211

S 81° 30' E

2048.34

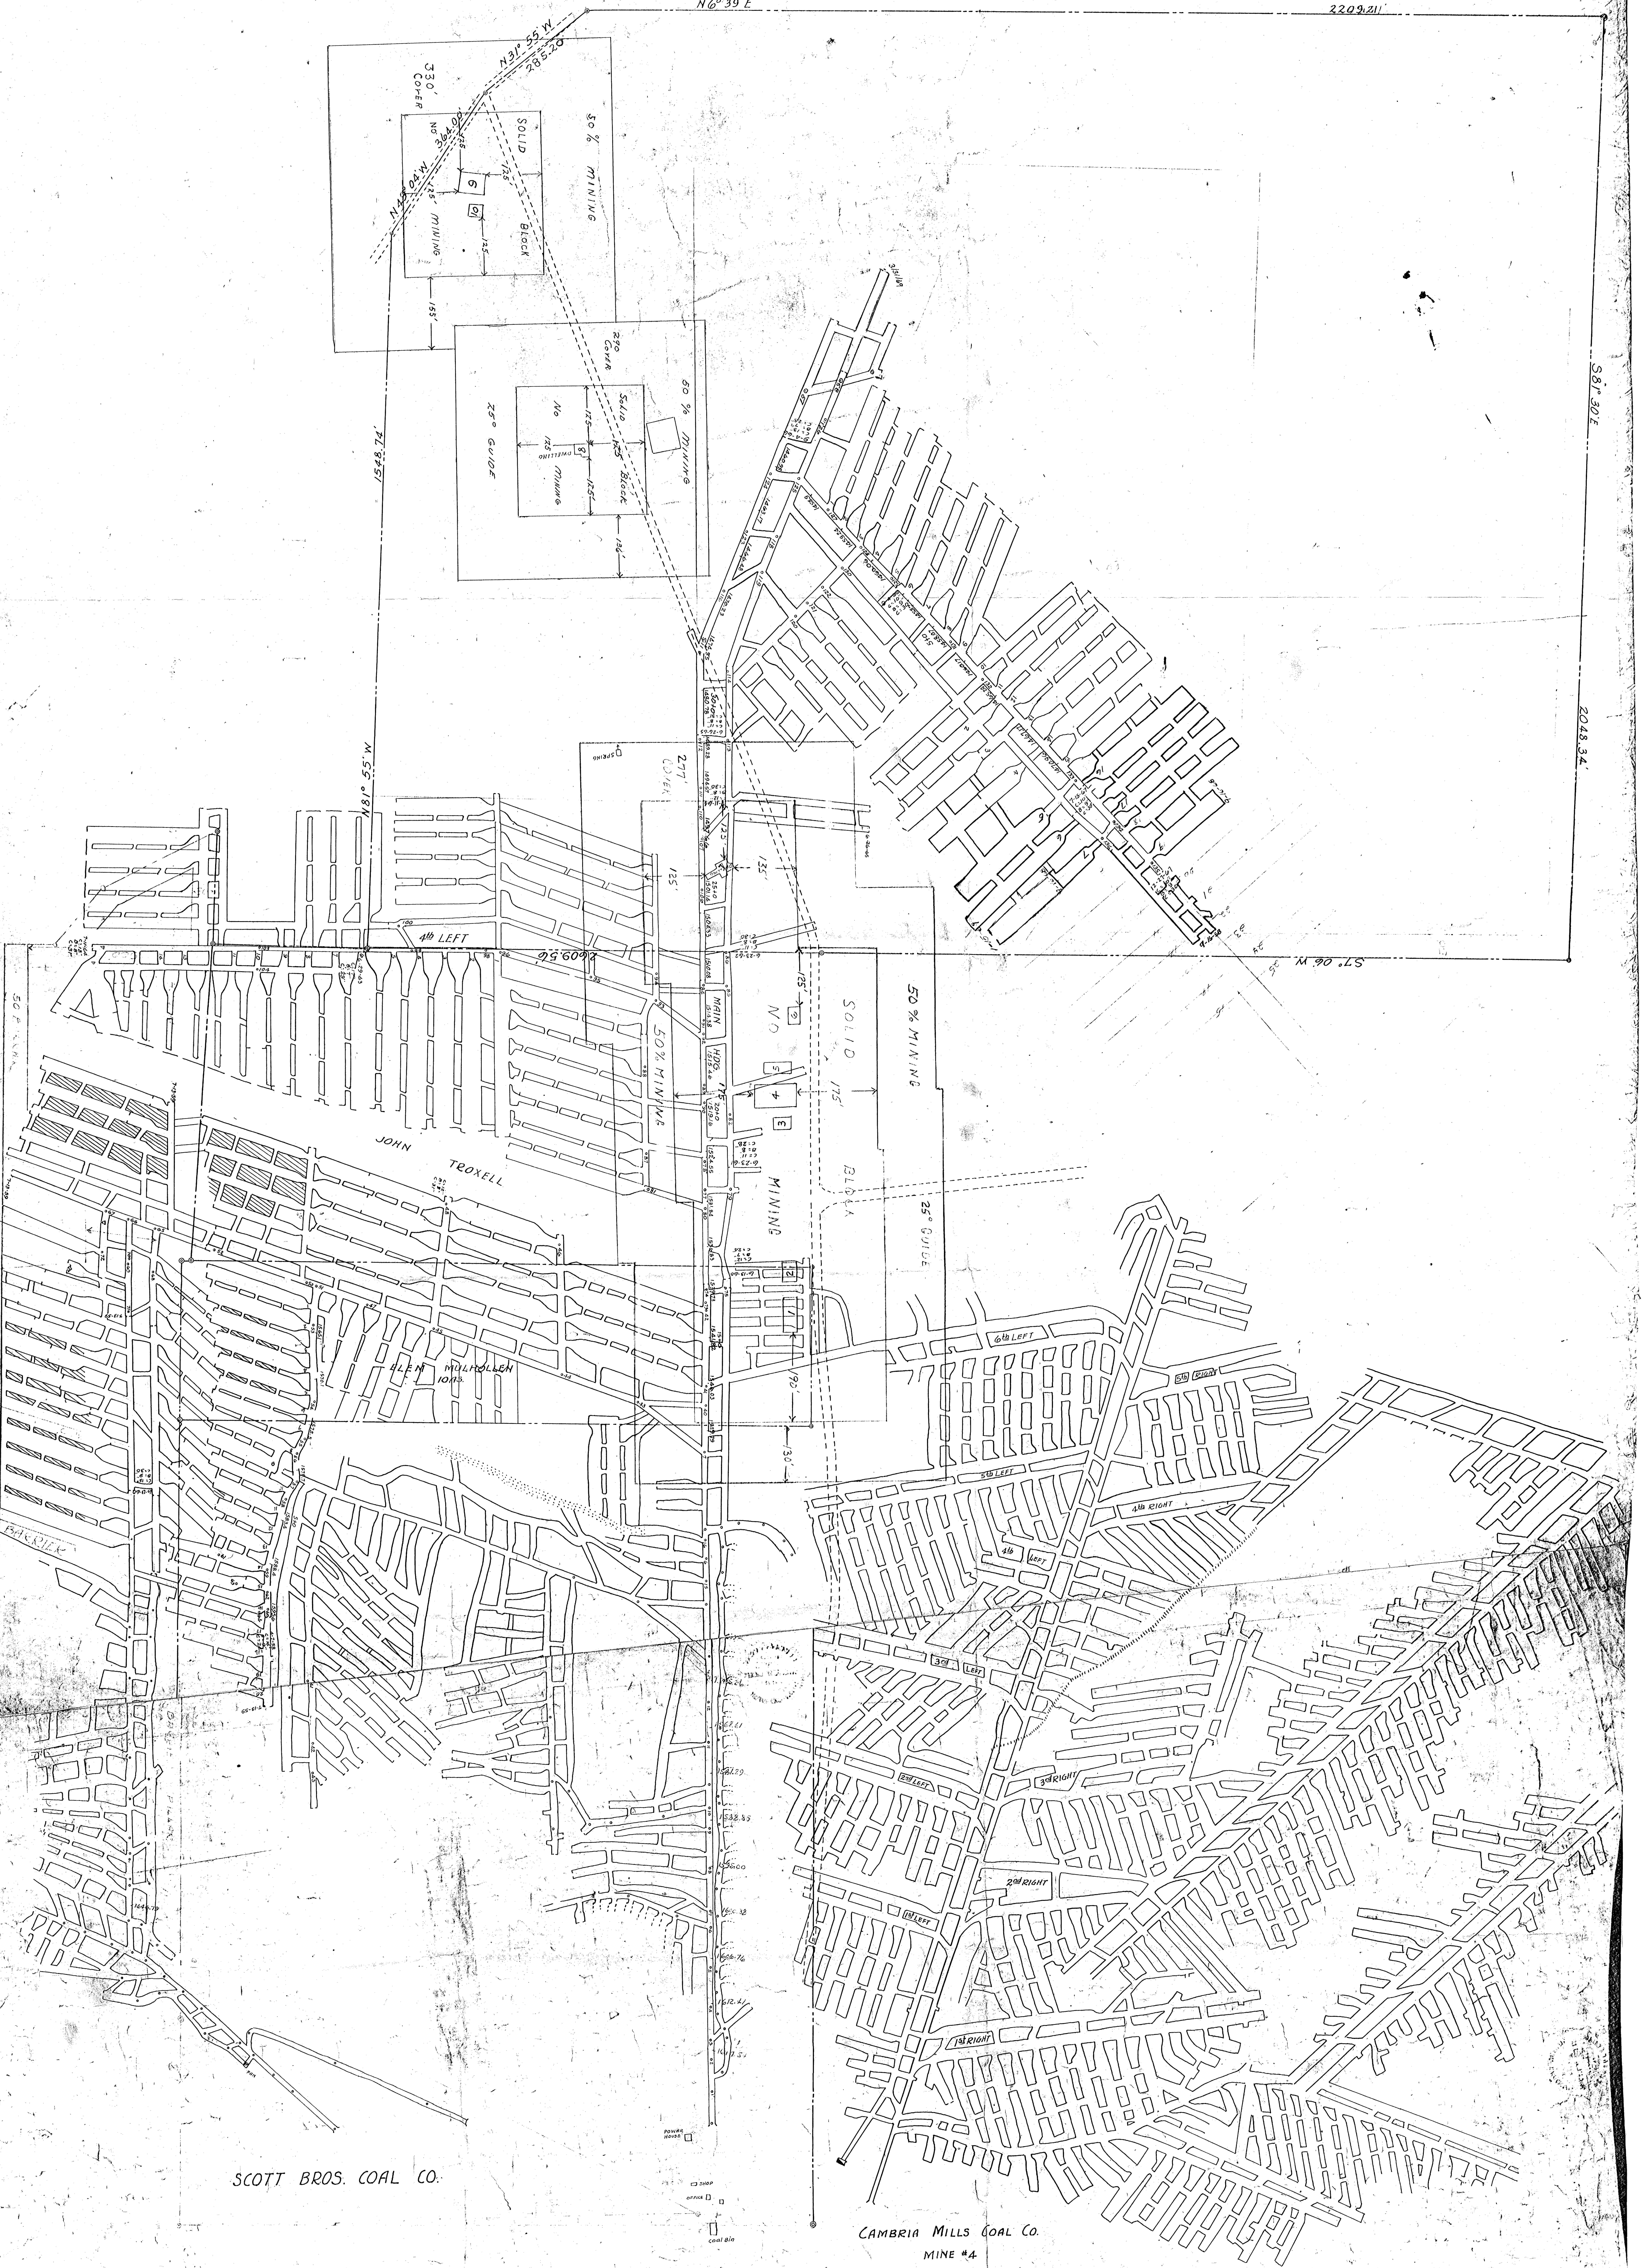

SCOTT BROS. COAL CO.

CAMBRIA MILLS COAL CO.
MINE #4

PROPERTY LINE
CONTEMPLATED MINING
SUPPORT AREA
PROTECTED STRUCTURES
MINING COMPLETED AREA

ABANDONED MINE MAP
W.H. MILLER COAL COMPANY
READE TWP., CAMBRIA CO.
SCALE 1"=100' B SEAM
DATE MINE ABANDONED - 3/31/19
Certification is here by made that
this map is a true & correct copy
of the original mine map of this mine
and is filed for my knowledge, and
original map is filed, complete, and correct

MAP
SHOWING
"B" SEAM WORKINGS
W.H. MILLER COAL CO.
READE TWP., CAMBRIA CO., PENNA.
SCALE 1"=100' J.L. BANFIELD REG. ENG.

#1807
12-16-19
CCL