


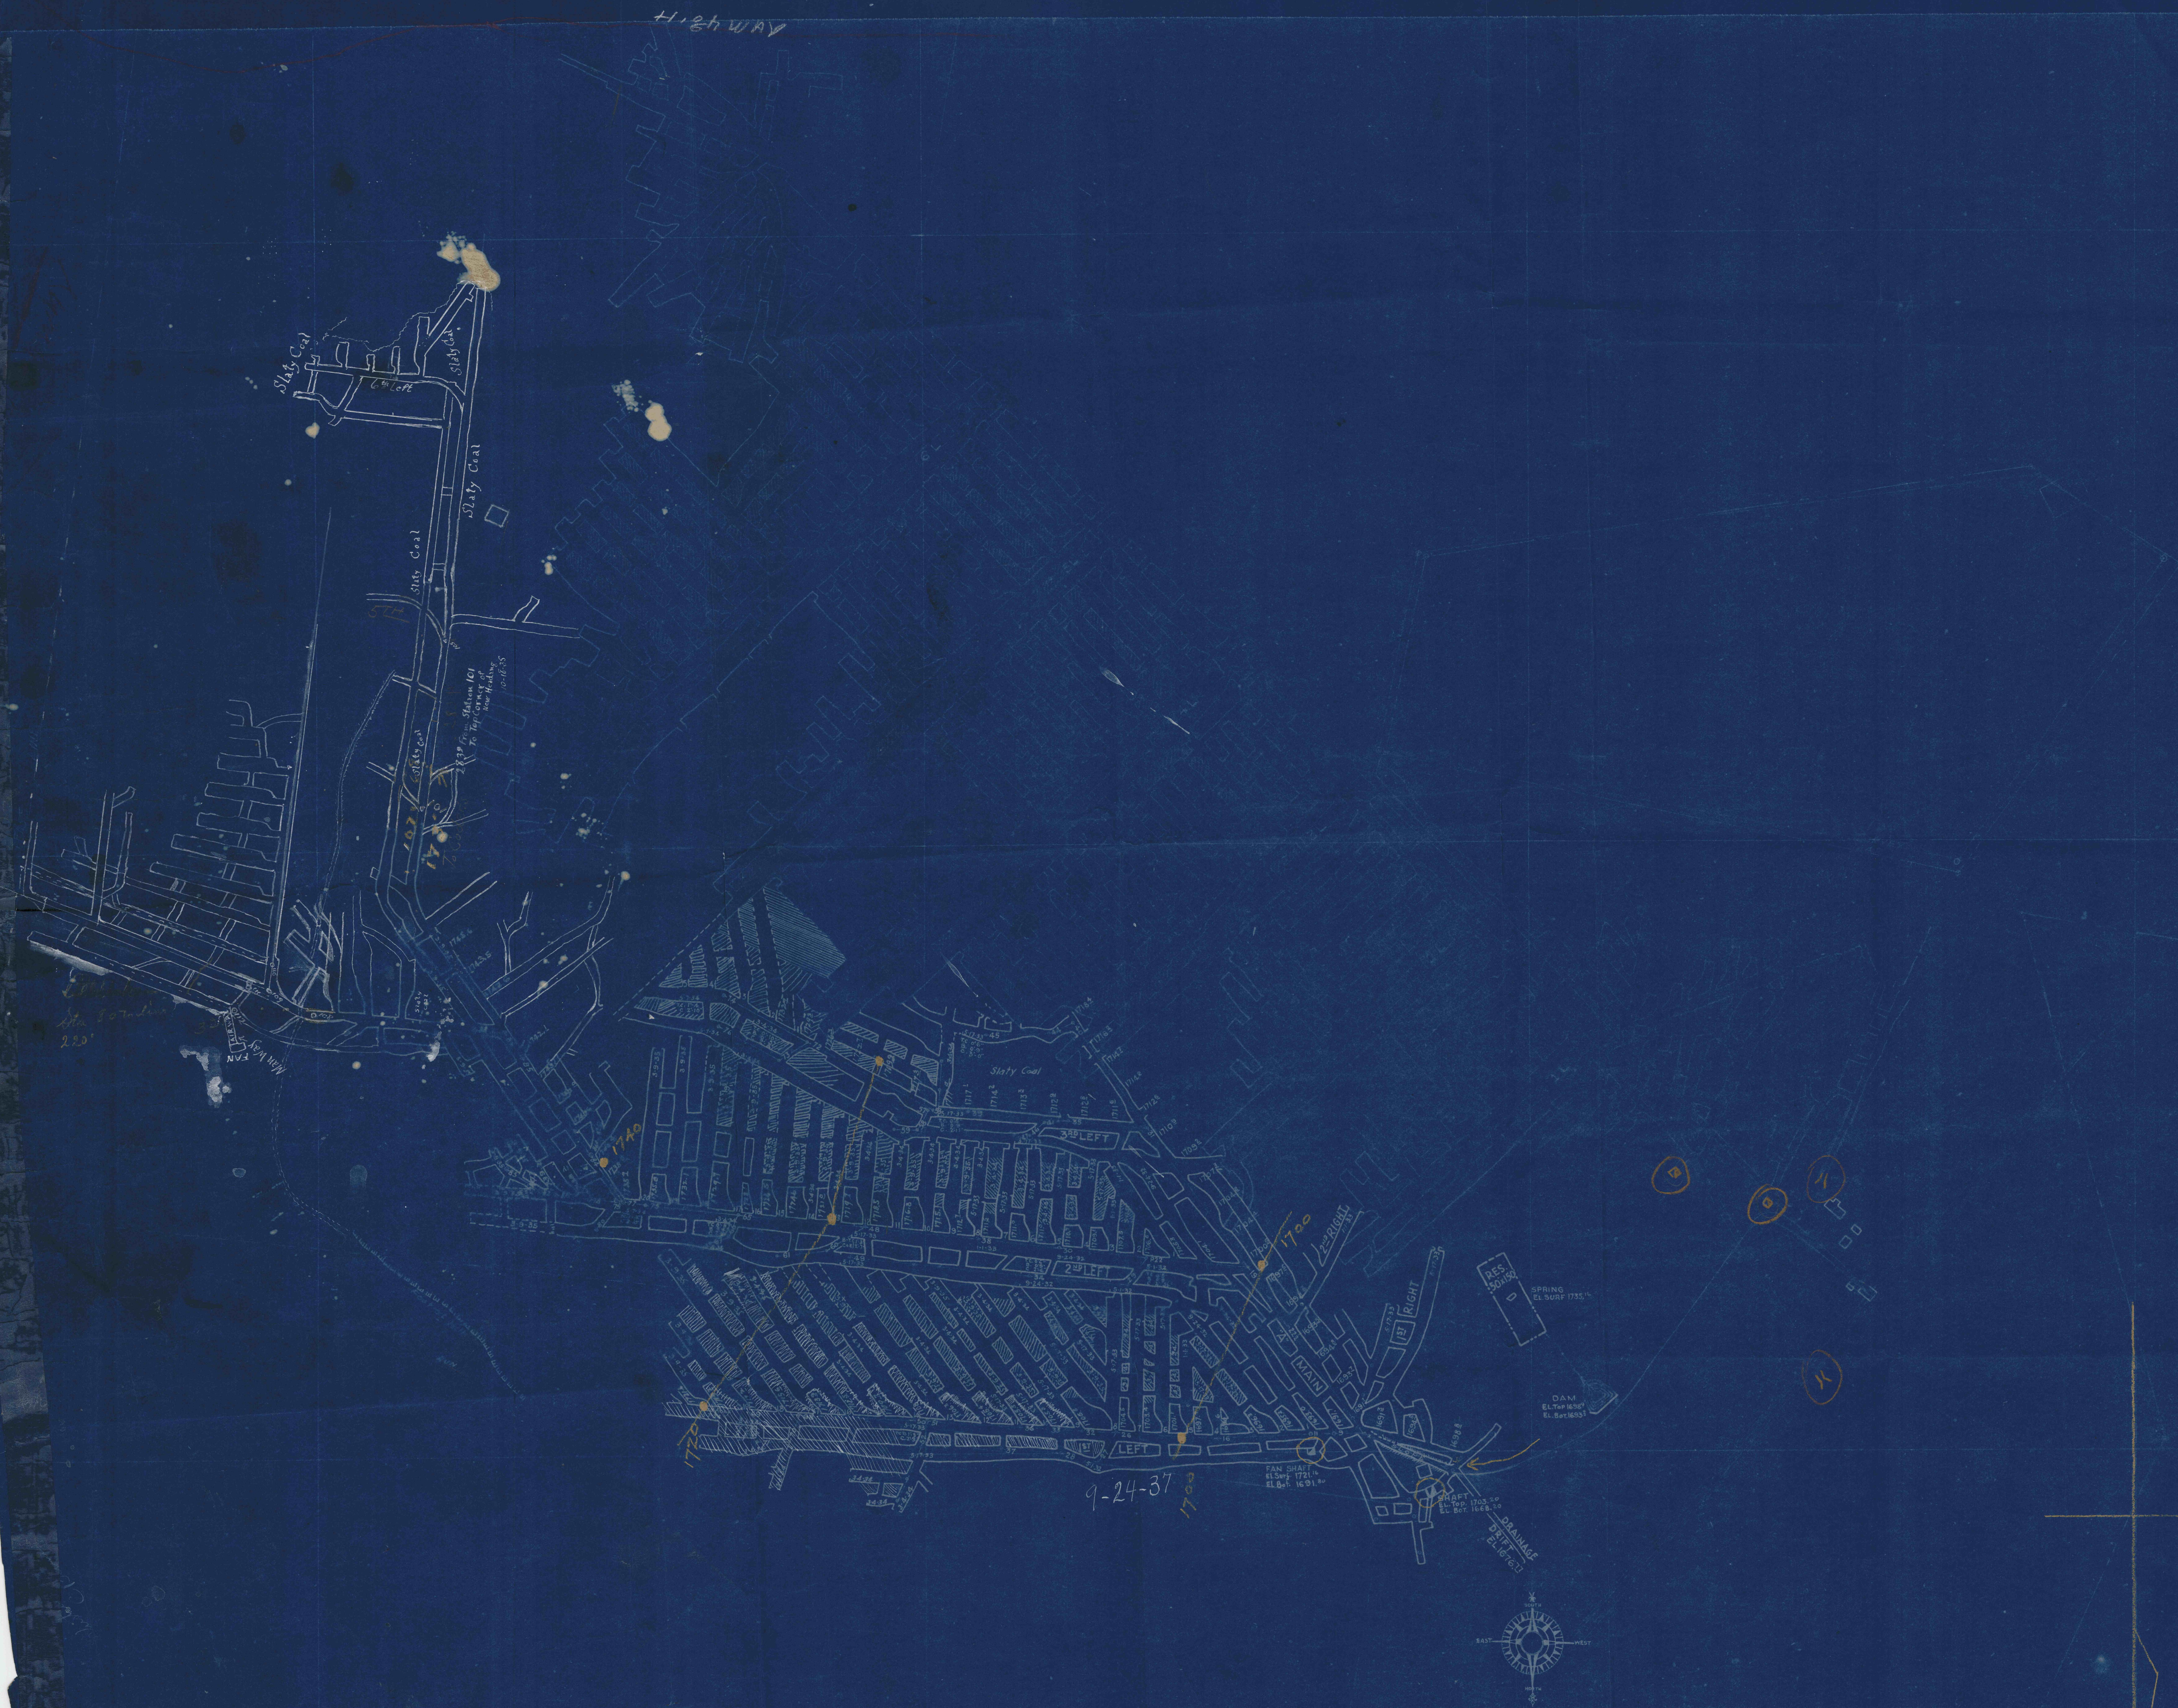

MAP OF
MILLER RUN No. 6 MINE
"B" VEIN
ELDER TOWNSHIP - CAMBRIA COUNTY-PA.
BEUNIER COAL MINING Co.
Scale 1"=100'