


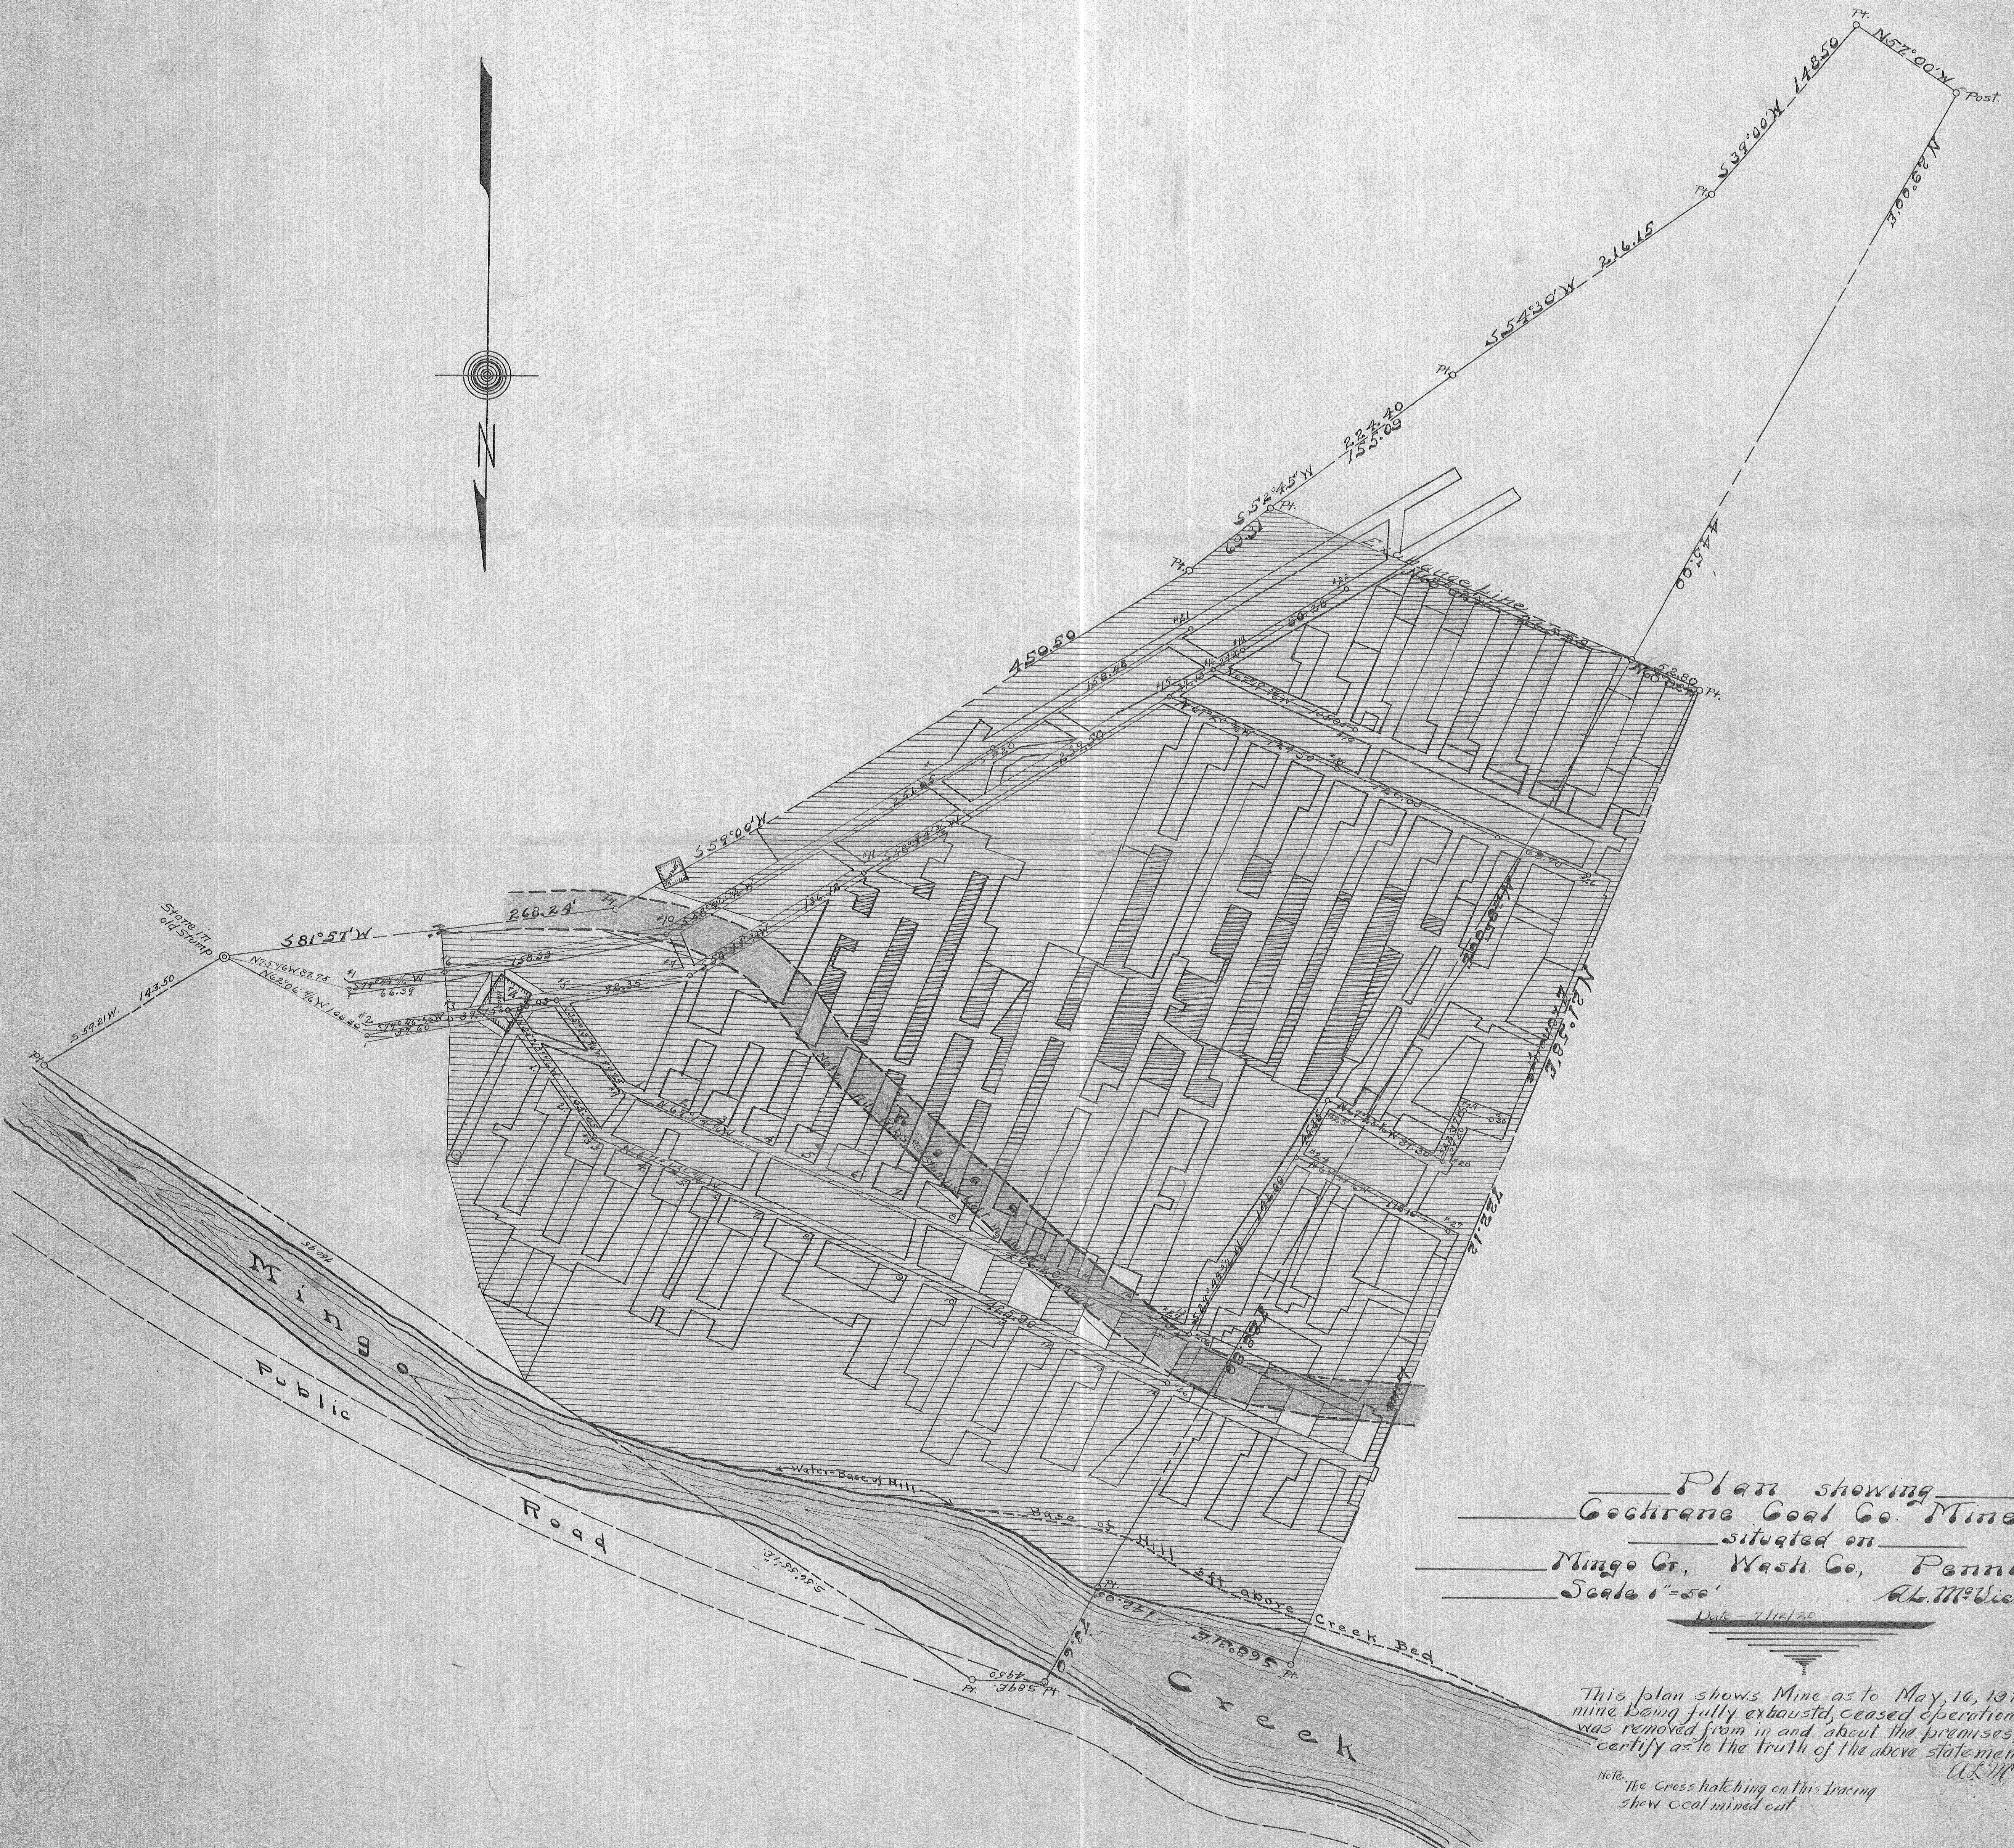

Plan showing
Cochrane Coal Co. Mine
situated on

Mingo Cr., Wash. Co., Penna.
Scale 1"=50'

Date 7/12/20

A. M. Vicker,
Eng'r.

This plan shows Mine as to May, 16, 1923, when mine being fully exhausted, ceased operation and all material was removed from in and about the premises, and I hereby certify as to the truth of the above statement.

Note: The cross hatching on this tracing show coal mined out.

A. M. Vicker,
Mining Eng.

#1022
12-17-29
CC