


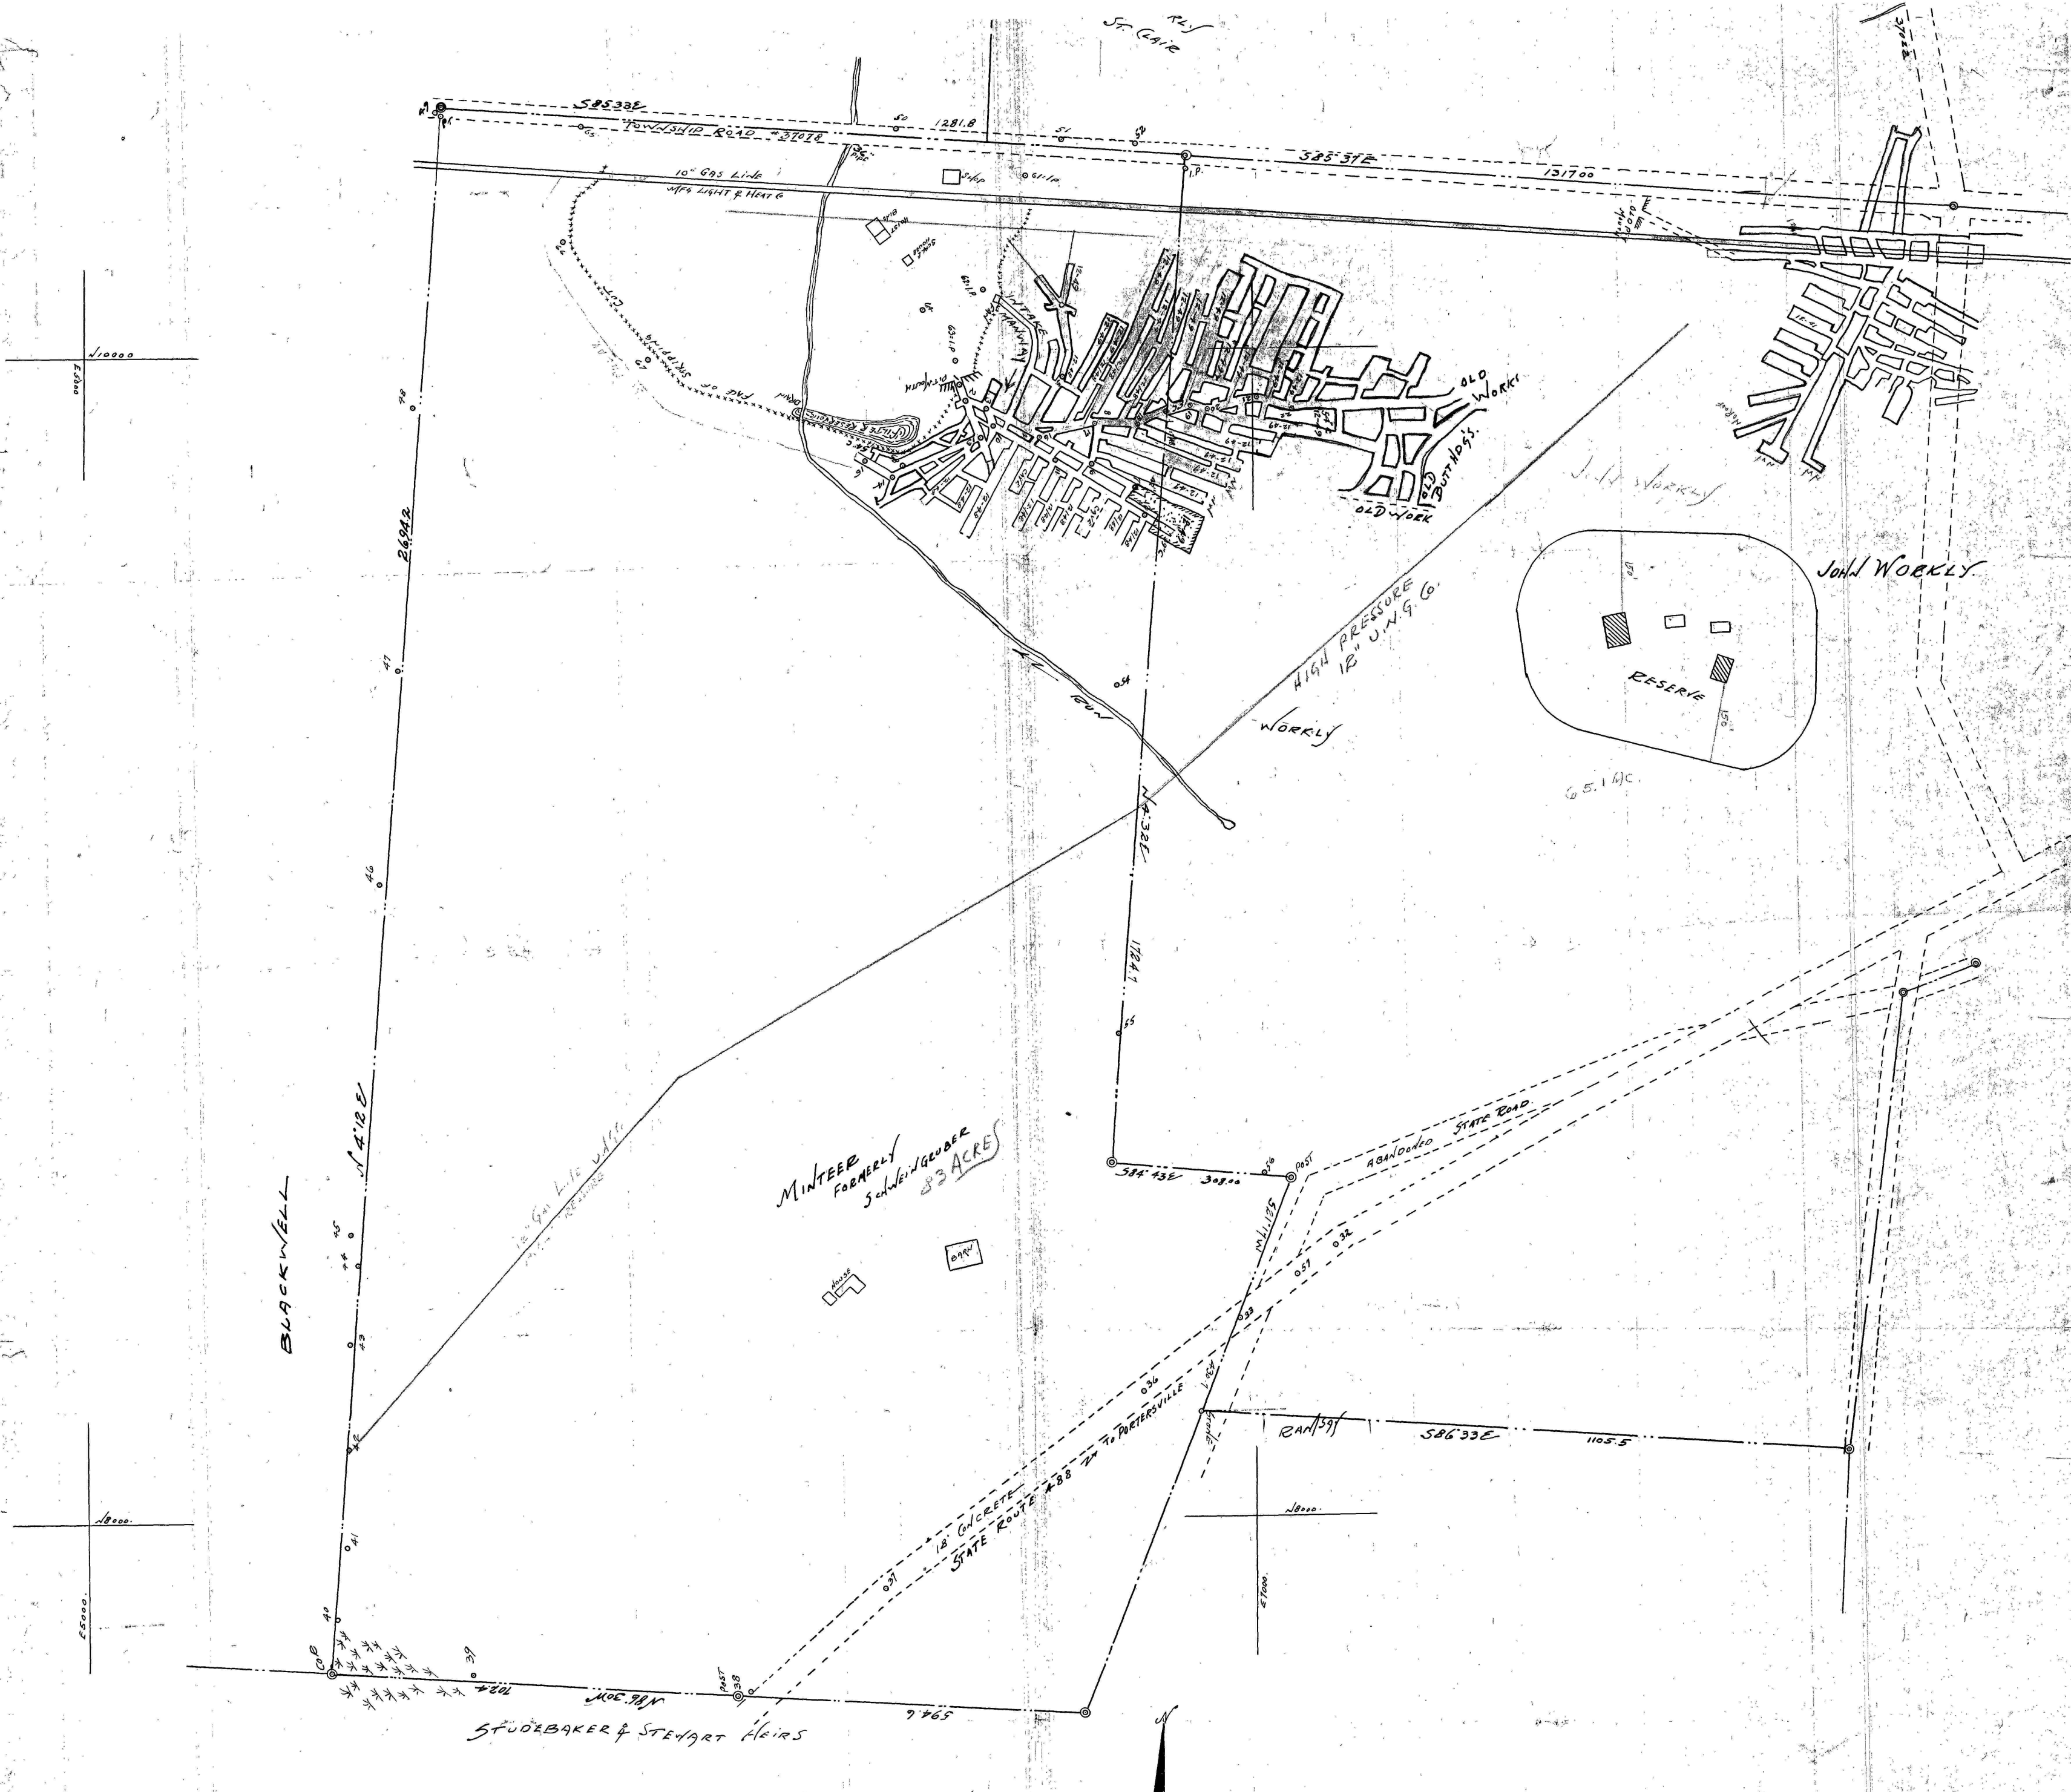

M&P
 MINTER MINE
 R.W. KERRY & SONS COAL CO.
 PERRY TOWNSHIP LAWRENCE CO. PENNA.
 SCALE 1"=100'
 SURVEYED & POSTED DEC-1948 R.J.D.
 POSTED DEC-1949 R.J.D.
 POSTED FEB-1952
 ALL MAP COORDINATES & CALCULATIONS CARRIED FROM
 FLOYD YOUNG MINE KERRY & SONS COAL CO.
 MAGNETIC NORTH OCT-1939

