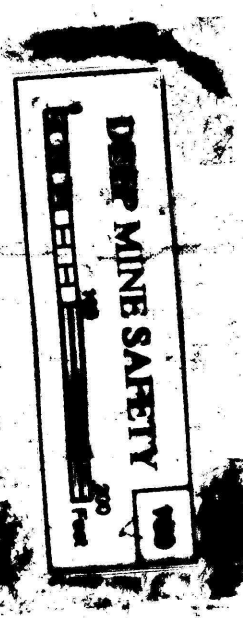


MOFFITT-STERLING GAS COAL CO.

SITUATE IN _____
DUNKARD TOWNSHIP, GREENE COUNTY, PA.
SCALE 1"=100' —X— FEB. 20, 1922.

SCALE 1"=100' —X— FEB. 20, 1922.

[illegible]

April 17, 1959

In compliance with Section 6 of Article 2 of the Pennsylvania Bituminous Mining Law, I, W. G. Stevenson, General Manager of Mines of J. H. Hillman & Sons Company, Pittsburgh, Pennsylvania, do hereby certify as follows:

One, Moffitt Mine of Molnar Brothers, in Dunkard Township, Greene County, Pennsylvania, was exhausted December 11, 1958. The portals and borehole openings all have been sealed in compliance with the recommendations of the District Inspector.

Mr. Moffett Mine of Mohr Brothers was operated under a Lease Agreement with J. H. Hillman & Sons Company. All engineering work was done by J. H. Hillman & Sons Company. The 100' scale print of Moffett Mine to which this is attached made part of a true and correct copy of the original map and shows the excavations made and the mine workings as of December 11, 1938.

[Signature]
General Manager of Mines
J. H. HILLMAN & SONS COMPANY

COMMONWEALTH OF PENNSYLVANIA)
) SS :
 COUNTY OF ALLEGHENY)

 Sworn to and subscribed before me this 20th day of
 April, A. D. 1939. _____/

Robert Jones
Library Public

