


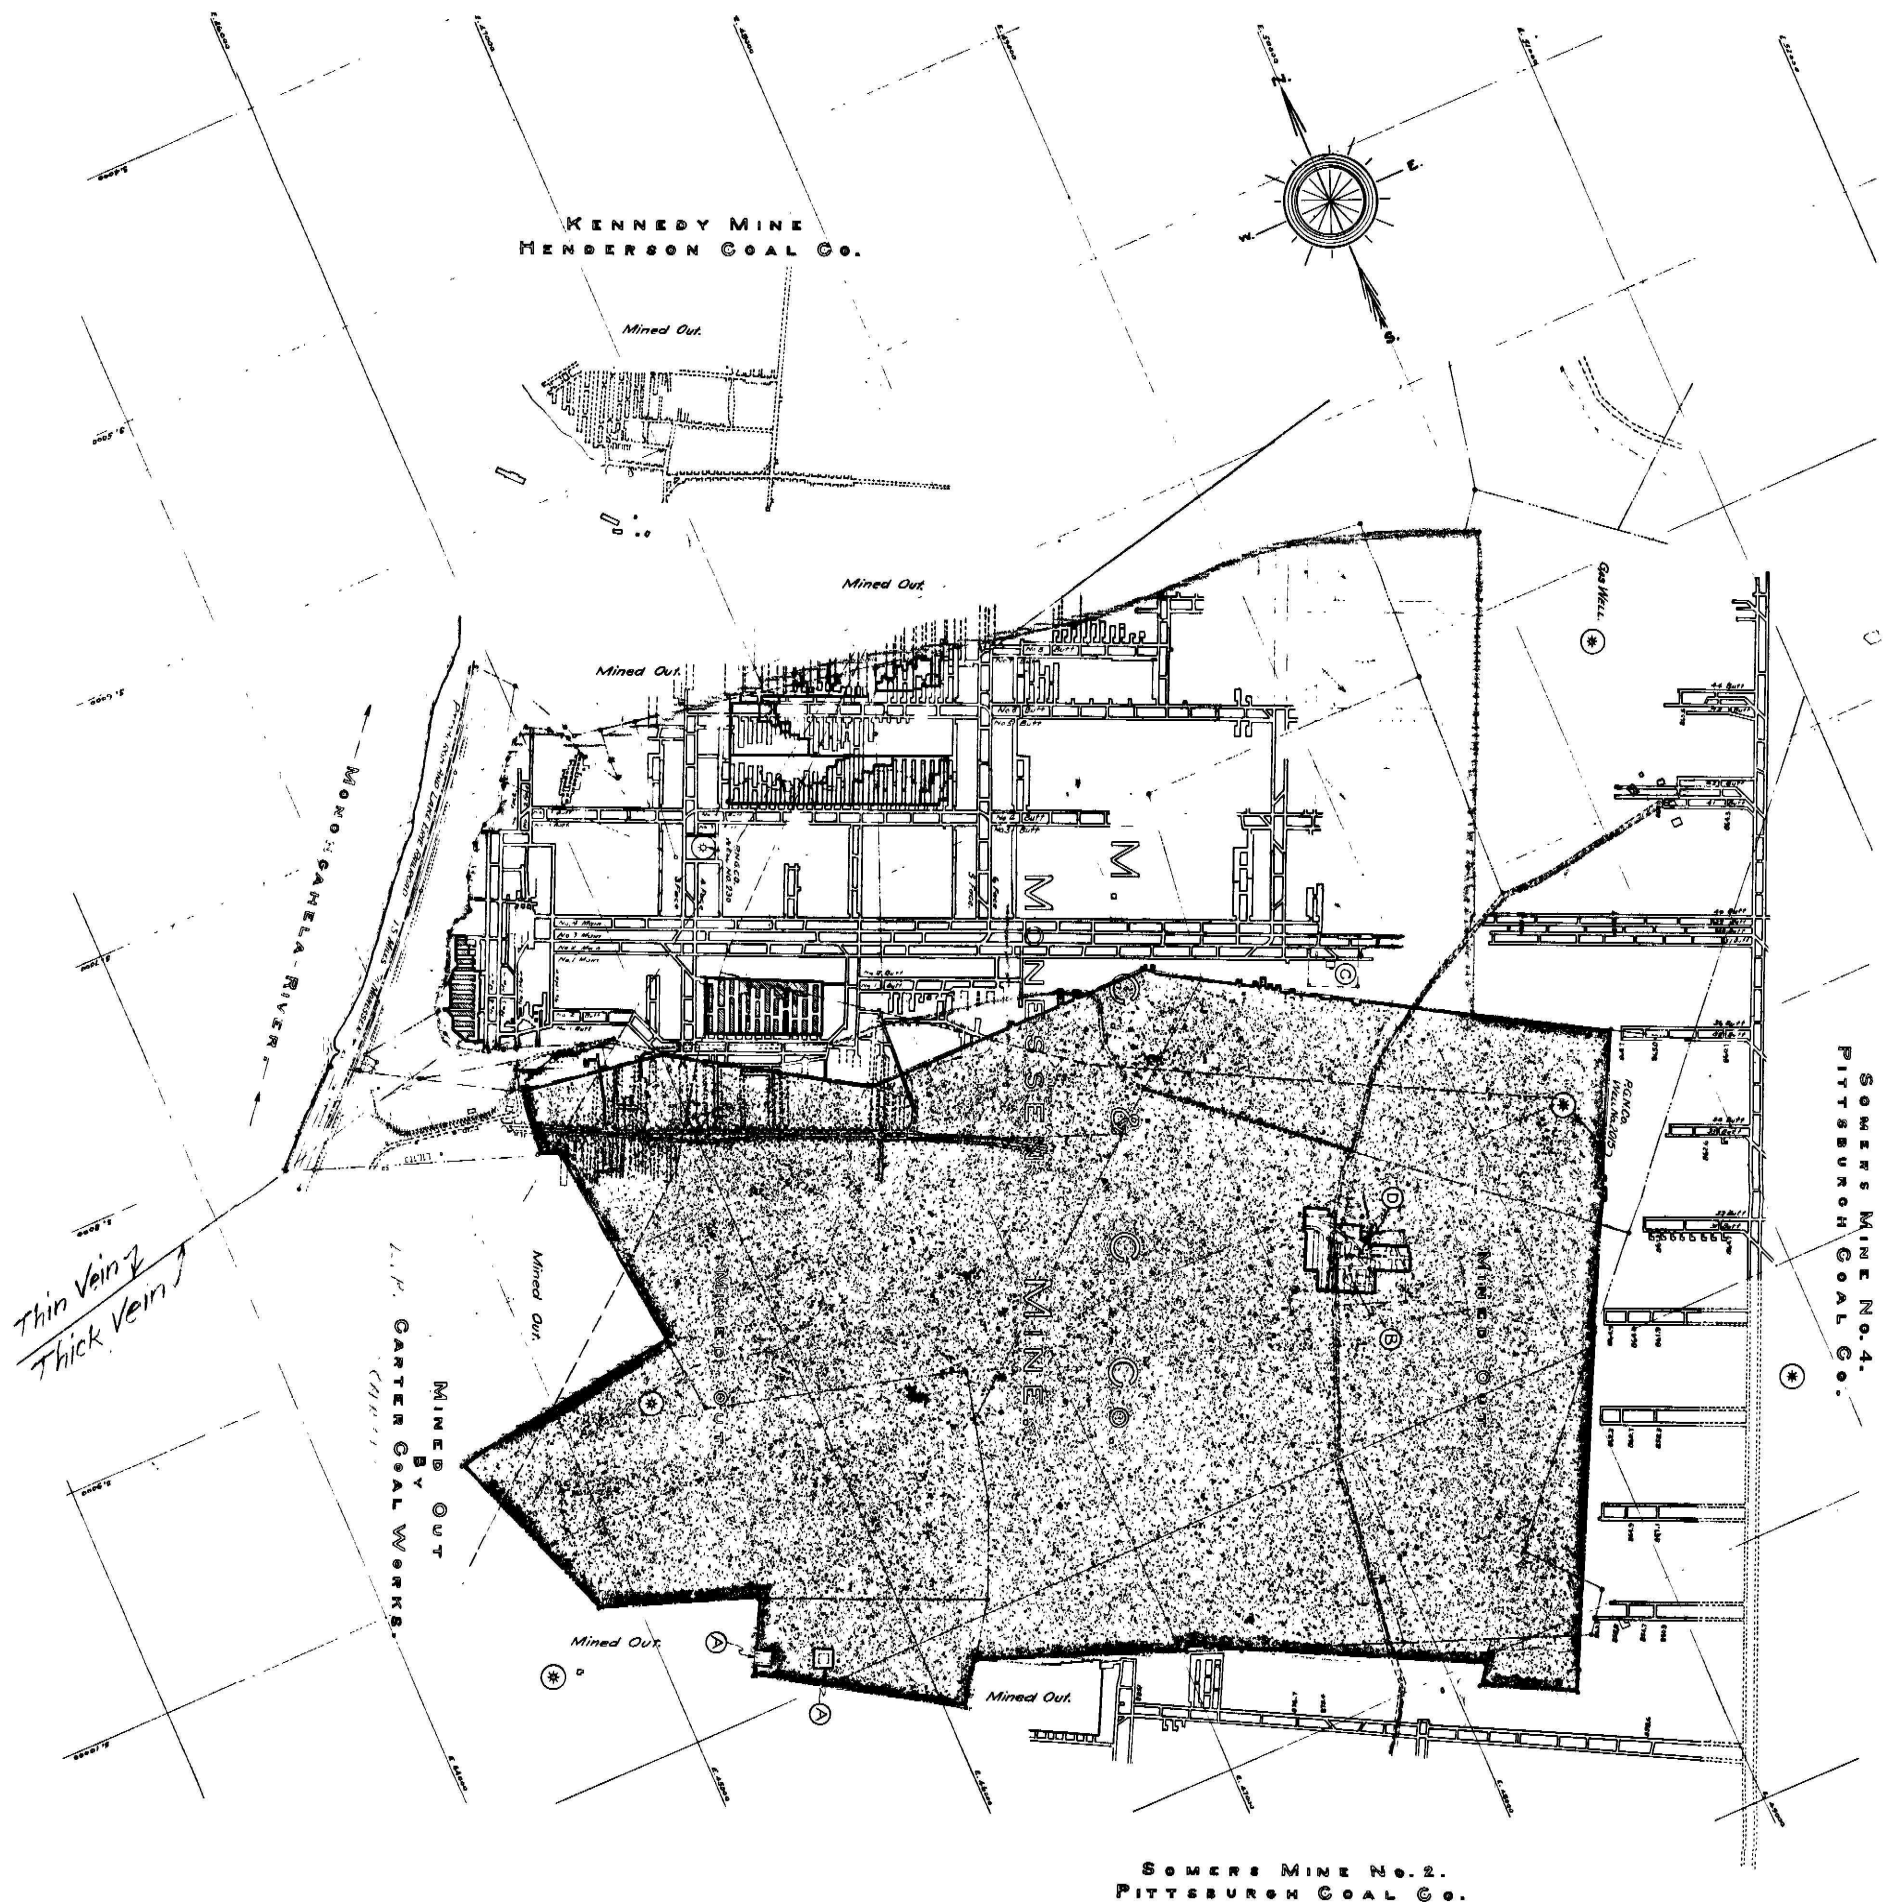

SOMERS MINE No. 2.
PITTSBURGH COAL CO.

LEGEND.

- (A) Coal Reserve Under House and Barn.
- (B) Railroad Tracks Left in To Support Shanties.
- (C) Mining Rights Reserved.
- (D) Shaft.

MONESSEN COAL AND COKE CO.
ALICIA, PA.
SUBJECT Mine Map.

FOR Monessen Mine
Rostrevor Township
Westmoreland County, Pa.

SCALE 1/4" = 400 Feet.
DRAWN BY R.L.C. W.A.A.
CHECKED BY DATE Jan 20, 1929.
REVISED 524-1928, 127-1922, 525-1923, 127-1923.
5-28-29.

DATE PRINTED DRAWING NUMBER

7/9.

Drawing No. 44.