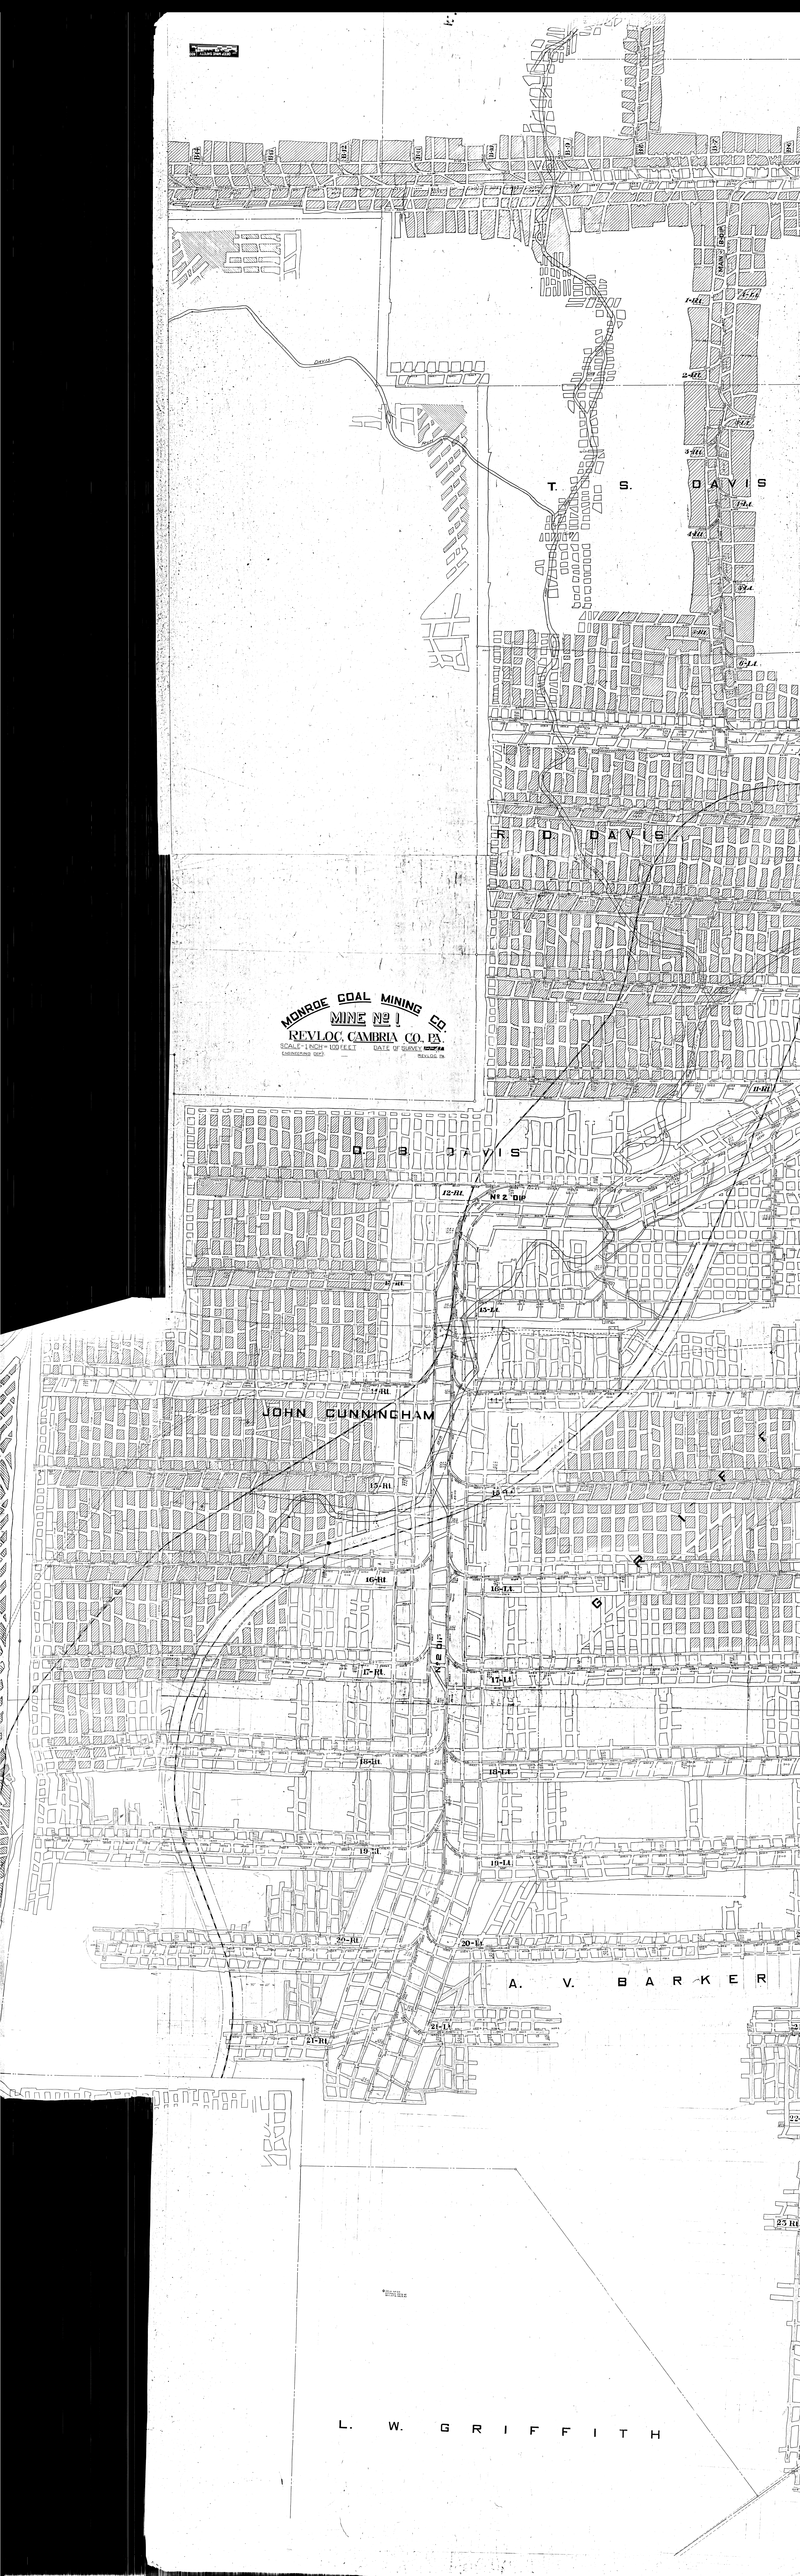

T. S. DAVIS
R. D. DAVIS
O. S. DAVIS
JOHN CUNNINGHAM
A. V. BARKER
L. W. GRIFFITH
MONROE COAL MINING CO.
MINE № 1
REVLOC, CAMBRIA CO. PA.
SCALE 1 INCH = 100 FEET
DATE OF SURVEY
CHECKED BY
REVLOC PA
12-RL
13-RL
14-RL
15-RL
16-RL
17-RL
18-RL
19-RL
20-RL
21-RL
22-RL
25 RL
1-LL
2-LL
3-LL
4-LL
5-LL
6-LL
7-LL
8-LL
9-LL
10-LL
11-LL
12-LL
13-LL
14-LL
15-LL
16-LL
17-LL
18-LL
19-LL
20-LL
21-LL
22-LL
№2 DIP
№3 DIP
DAVIS
MAIN