


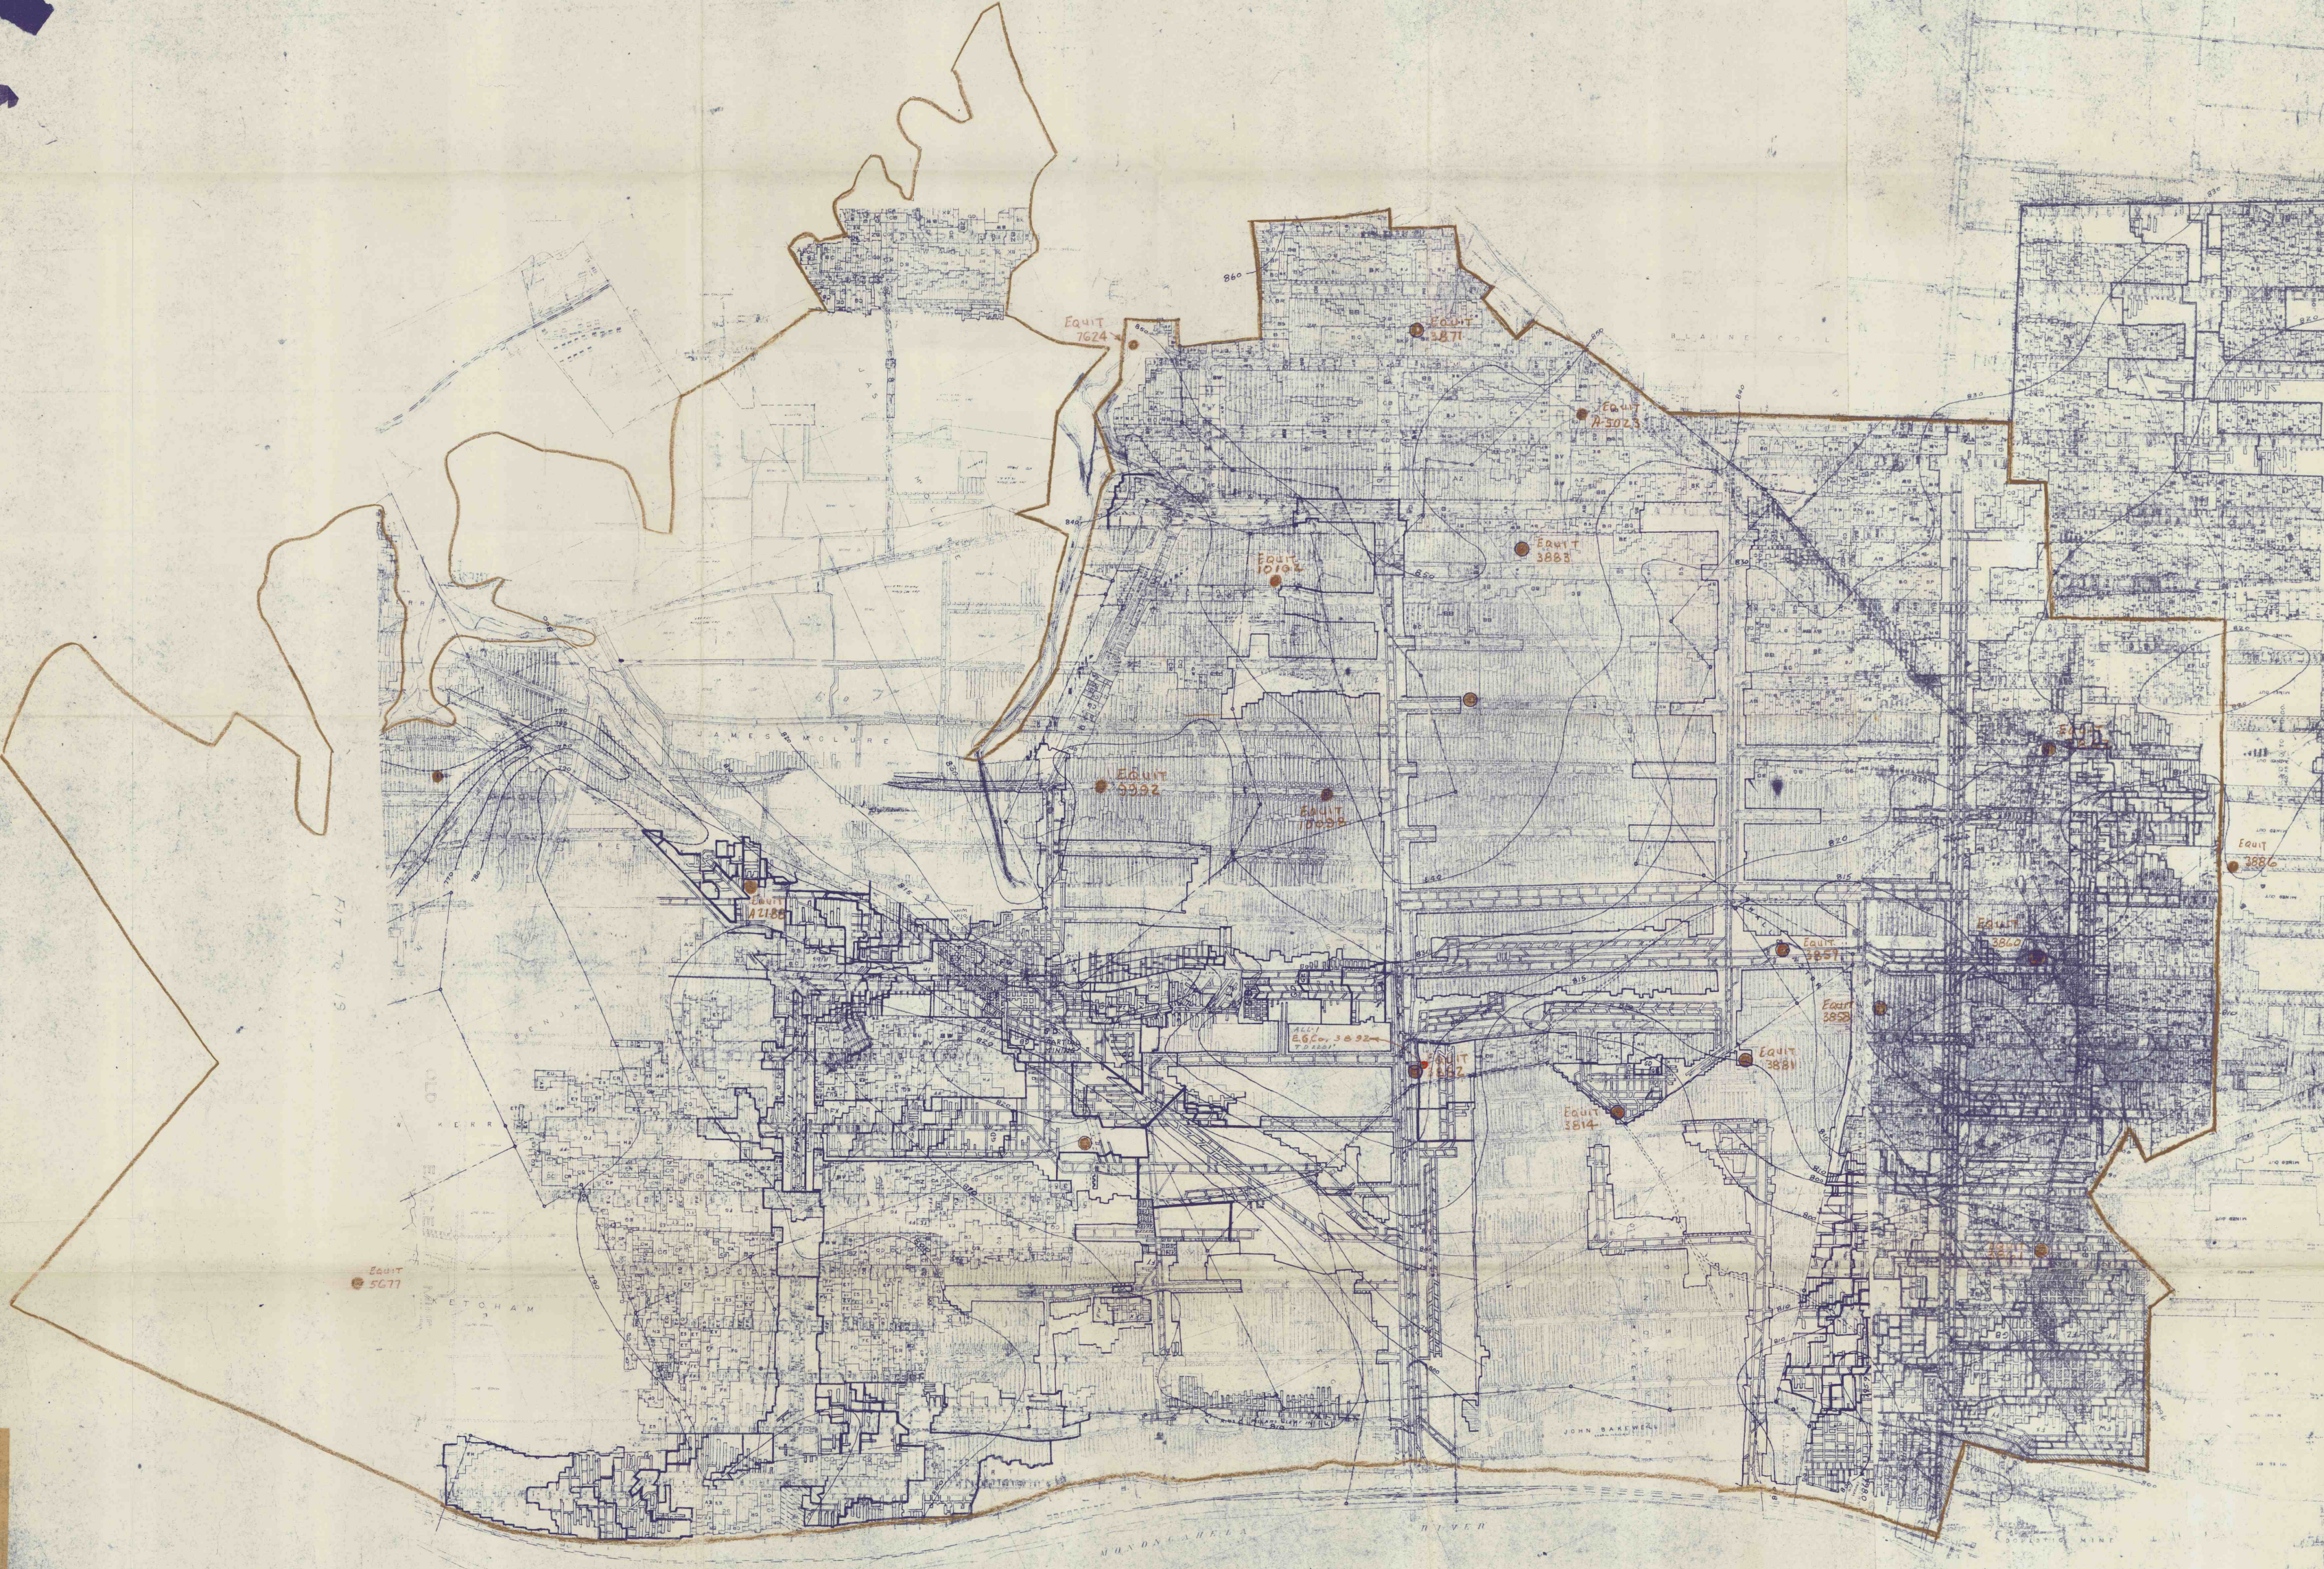

MONGAH MINE

SURVEY DATE 7-16-1956

SCALE 1" = 500'

Allegheny County

Dist. 22, 111
(Pittsburgh-Consolidation Coal Co.)
Pittsburgh, Pa. Co.

#1834
12-17-99
C.A.

Permit No.
ALL-1
Bundell's Record
SAC 3892