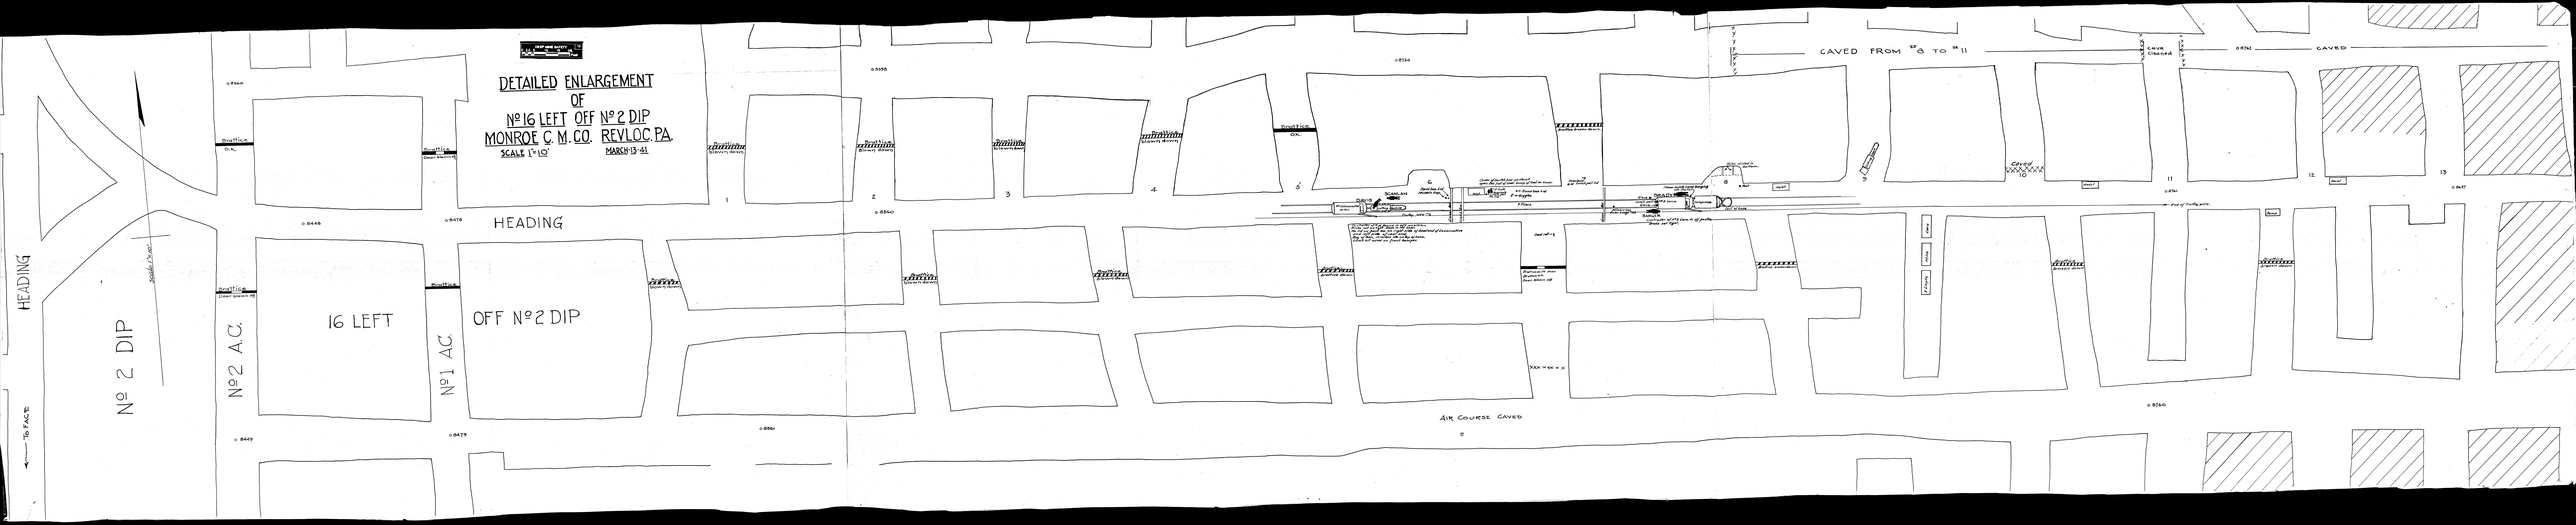
DETAILED ENLARGEMENT
OF
Nº 16 LEFT OFF Nº 2 DIP
MONROE C. M. CO. REVLOC, PA.
SCALE 1" = 10'
MARCH 13-41
HEADING
Nº 2 DIP
Nº 2 A.C.
16 LEFT
Nº 1 A.C.
OFF Nº 2 DIP
HEADING
TO FACE
