


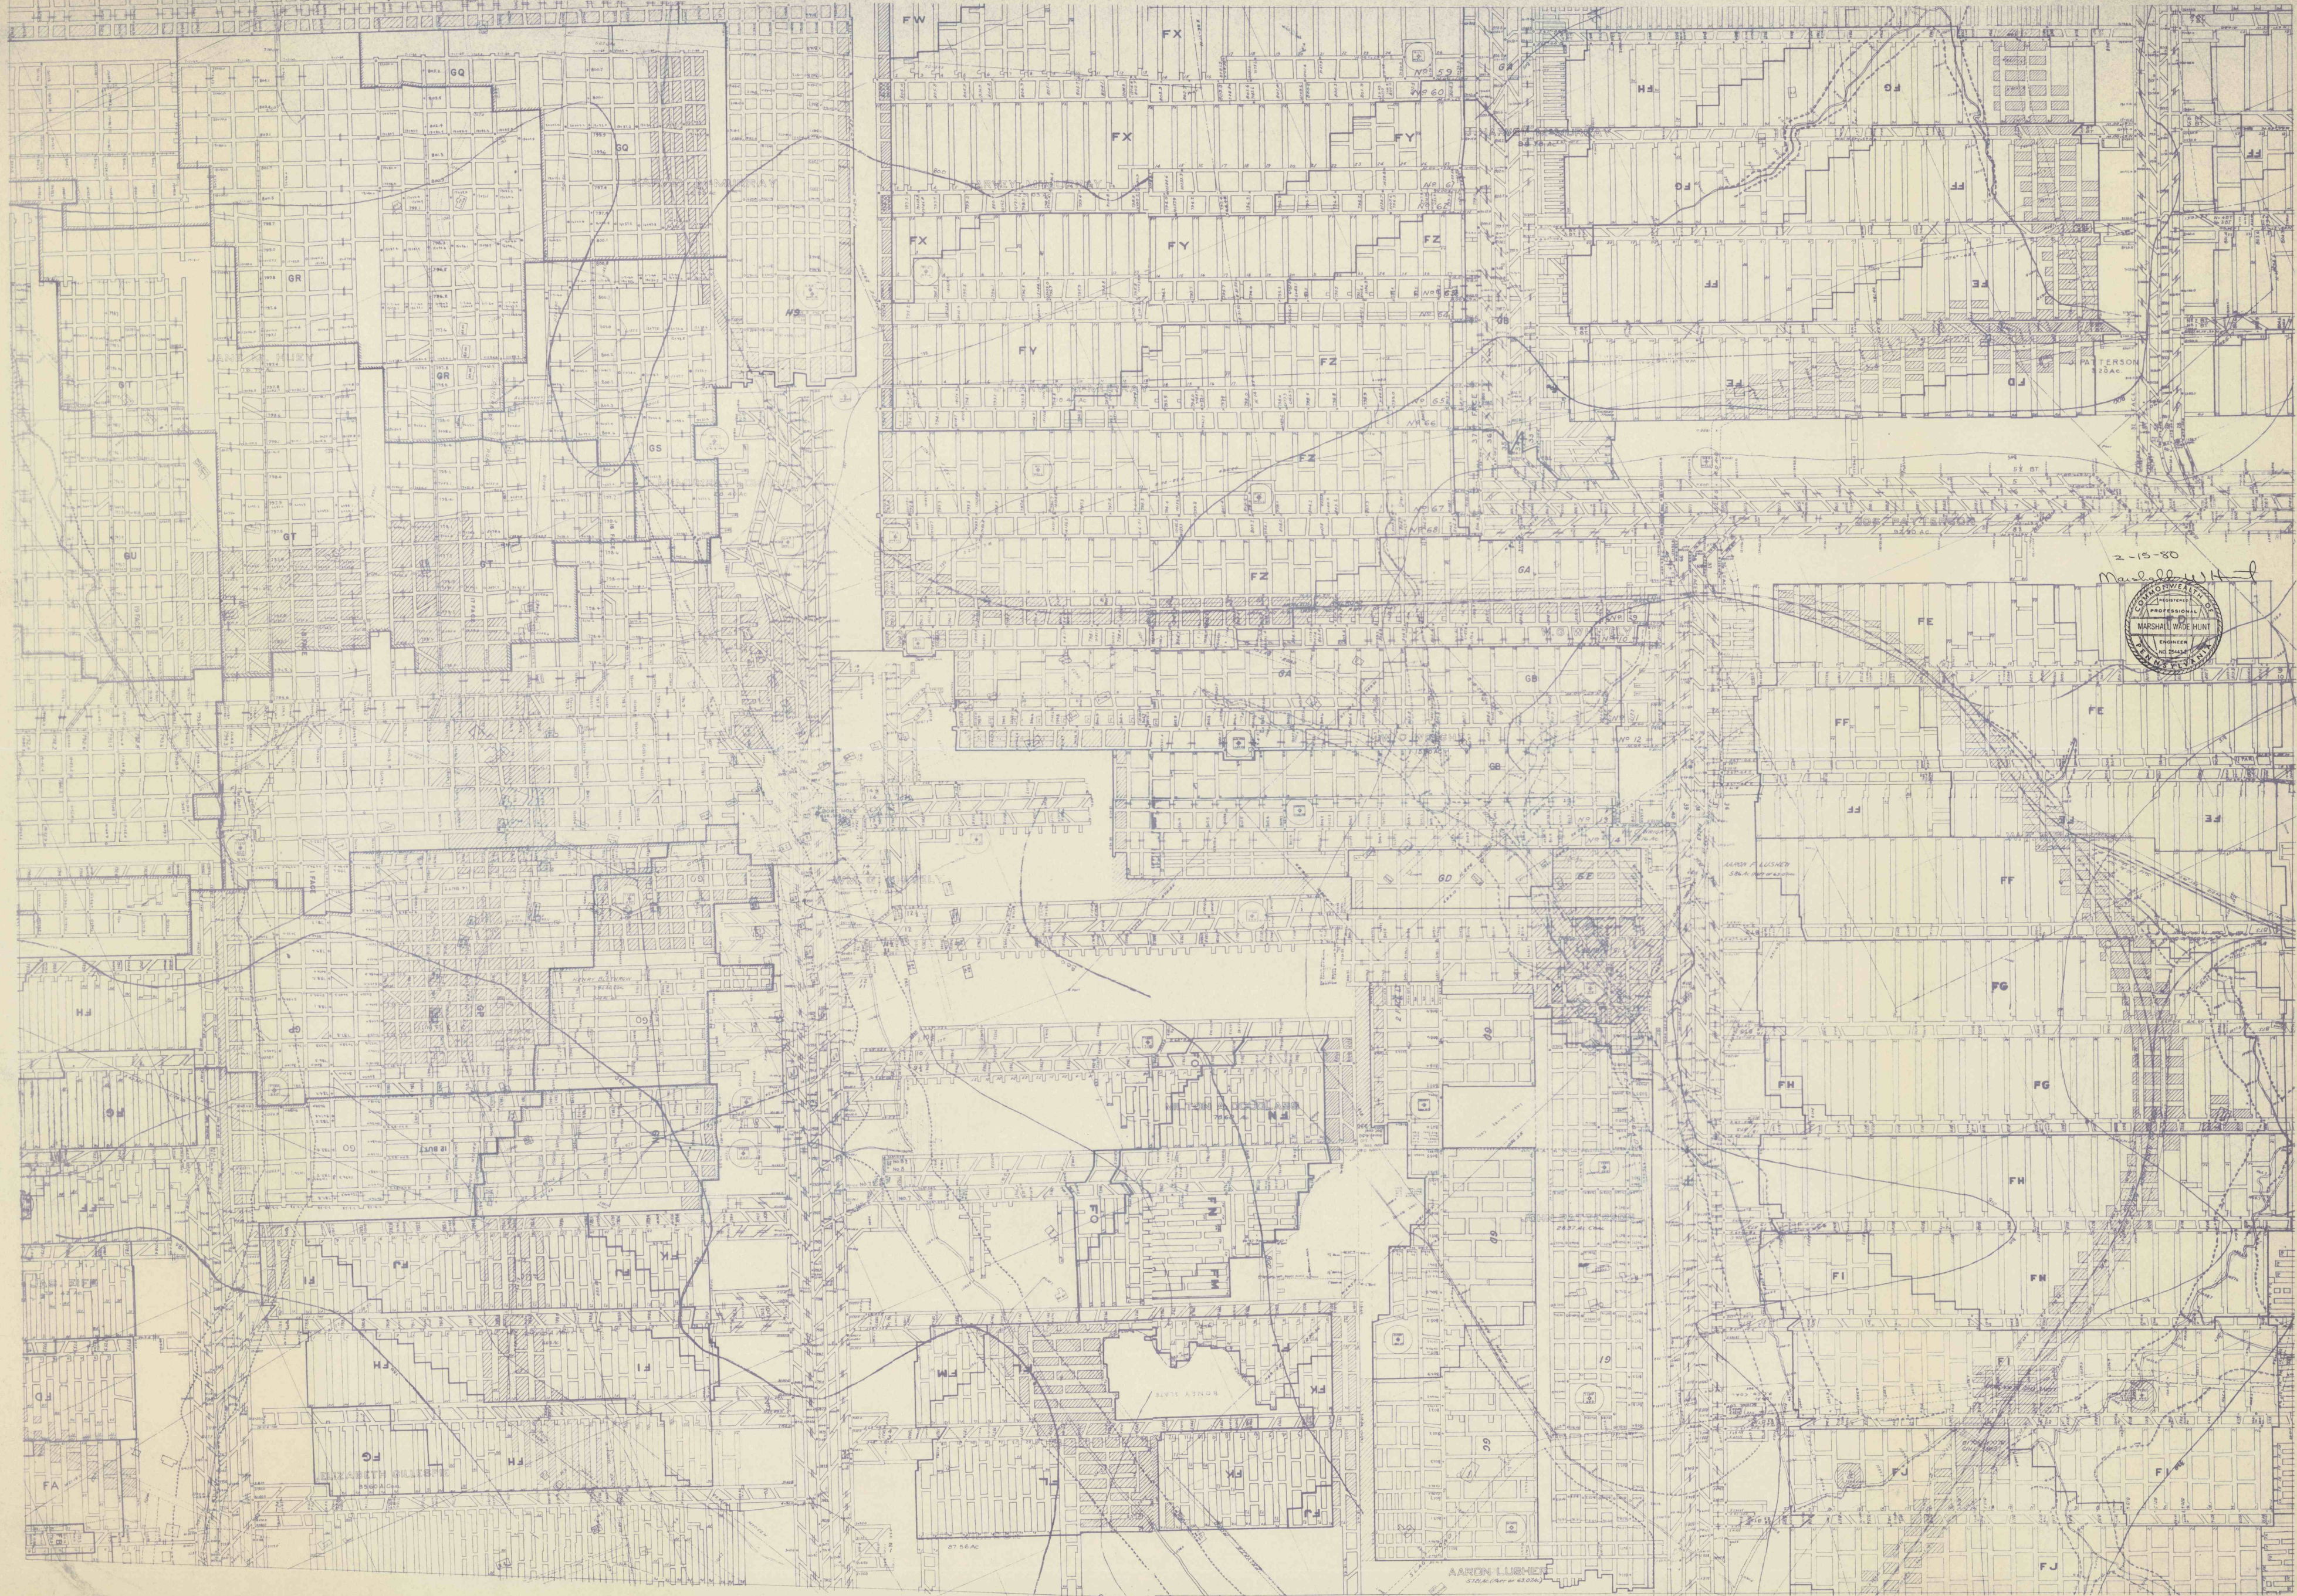

2-15-80

Marshall W. H.



