


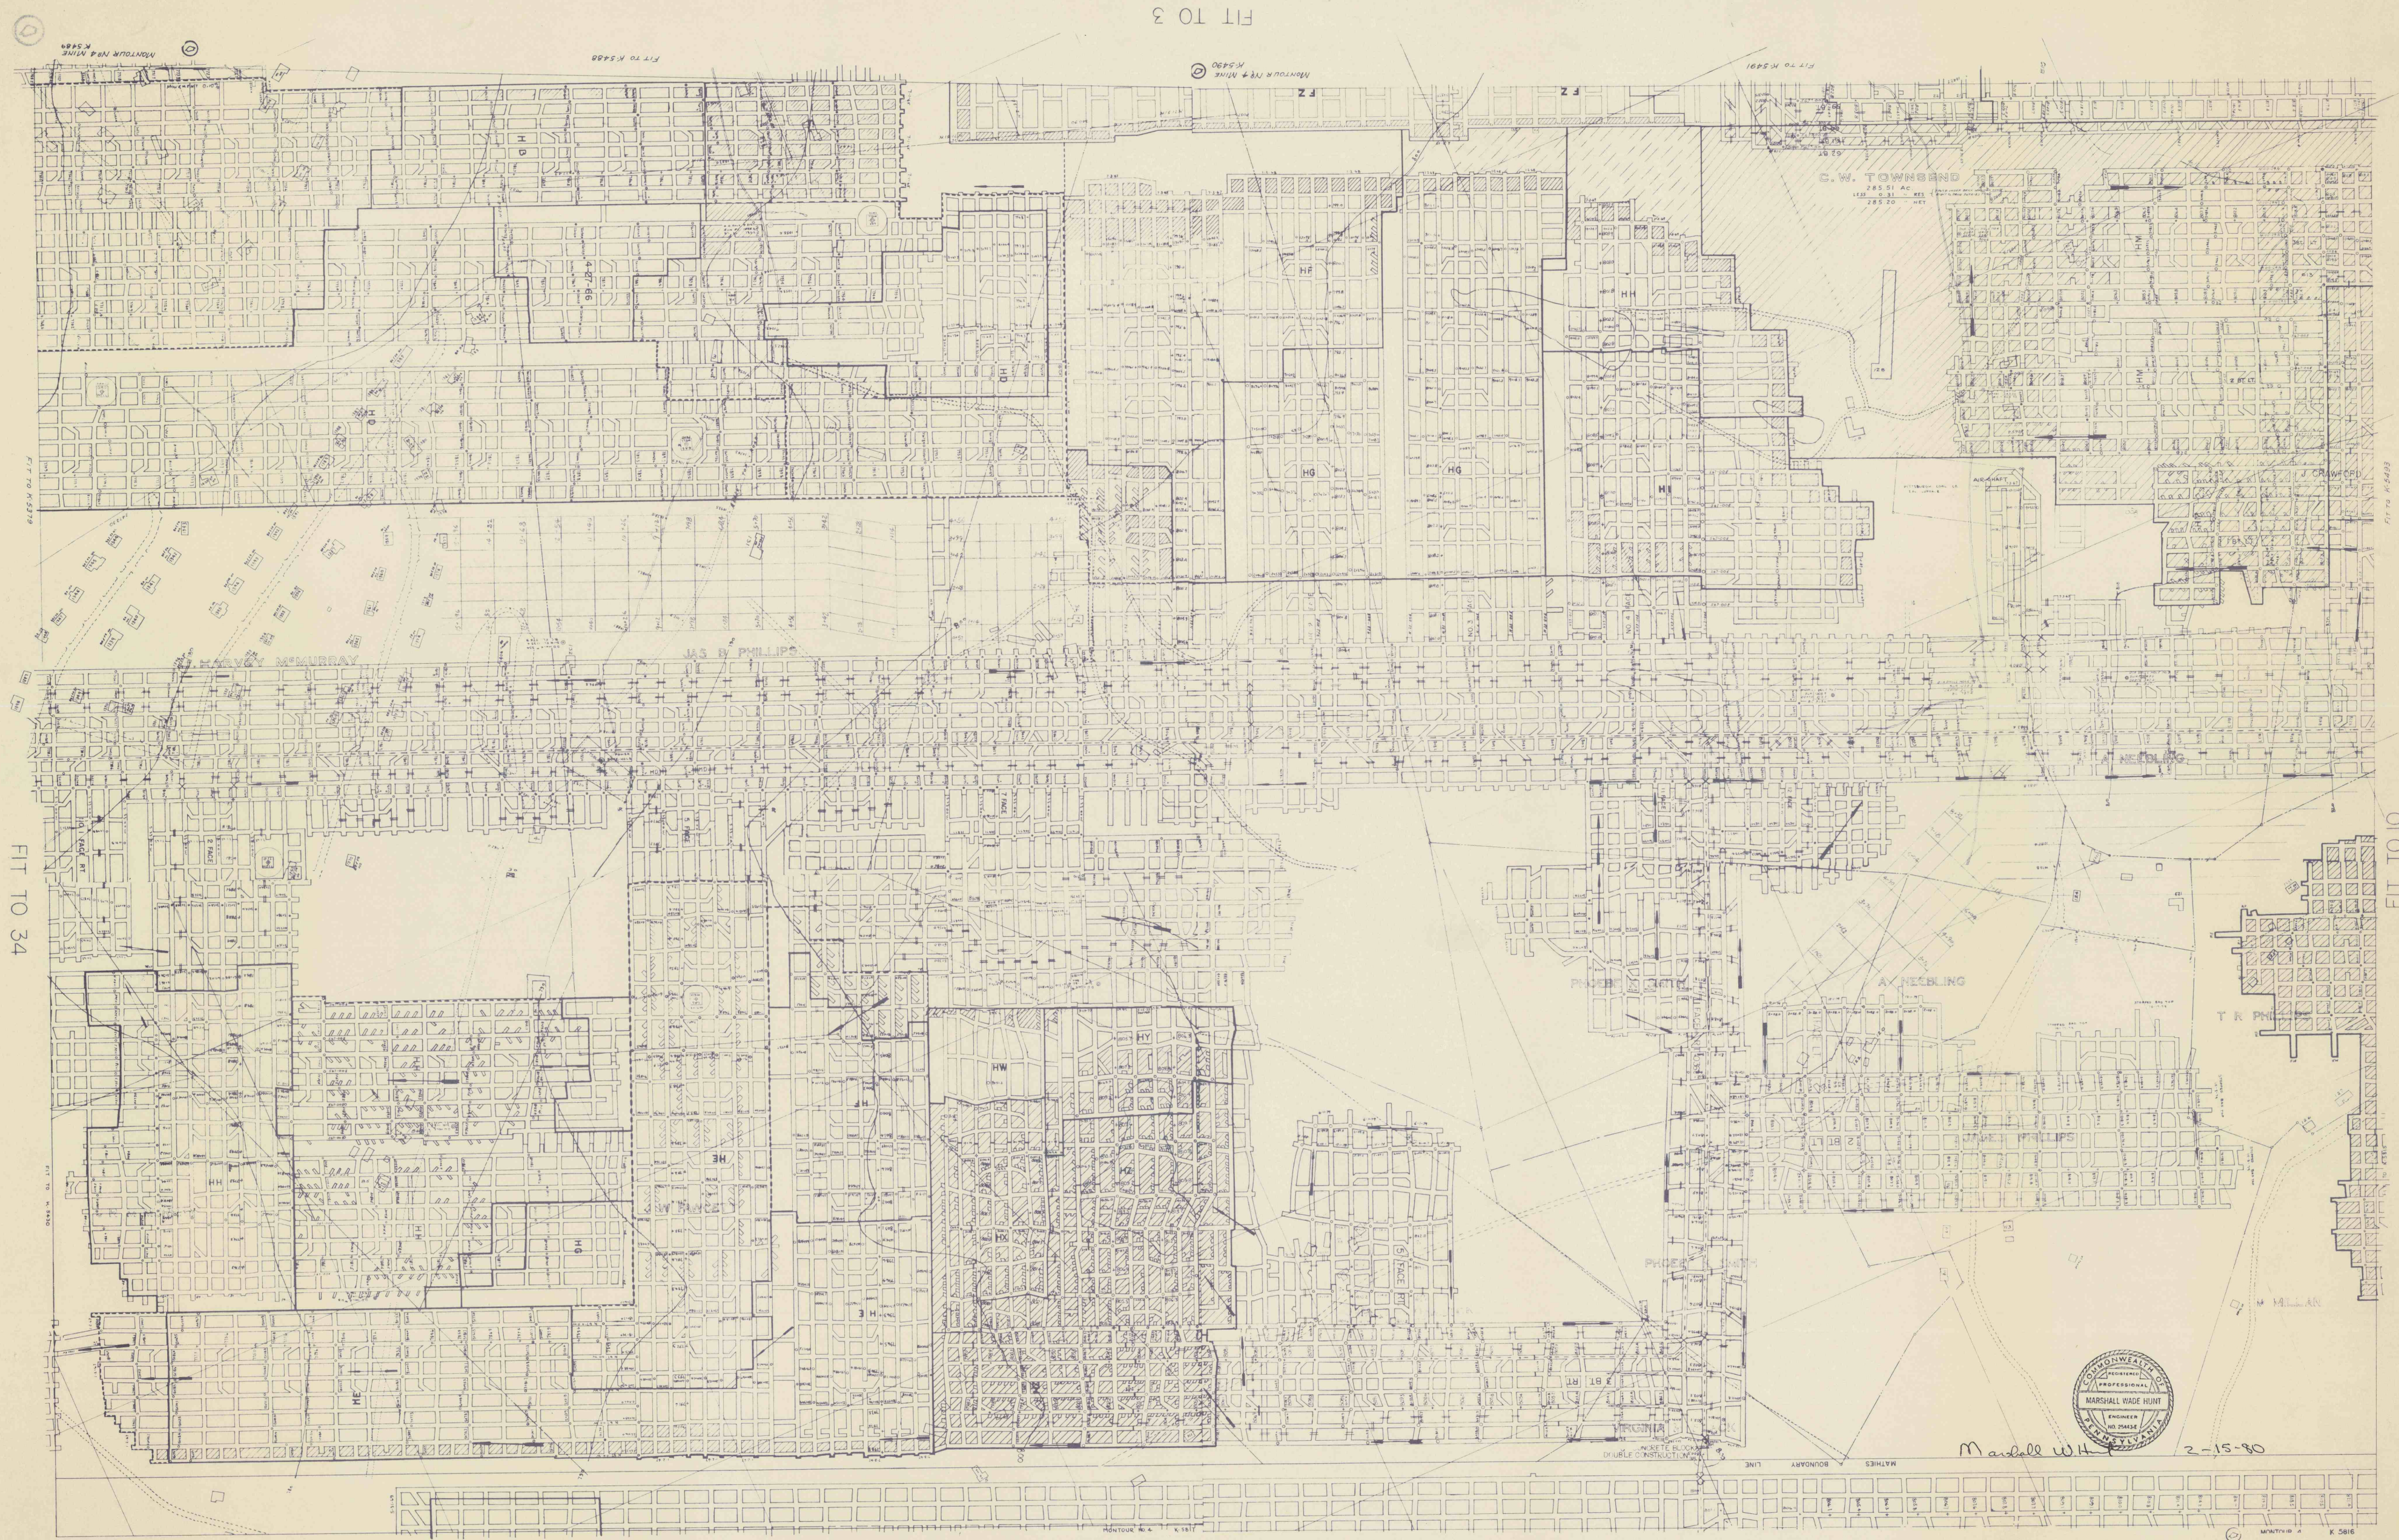

MATHIES MINE



Marshall Wade Hunt 2-15-80

FIT TO 34

FIT TO 3

FIT TO 10