


Mont 10 1"=200'



M.H. MAITS
47.82 A. DEED AREA

A. B. SICKMAN et al
16.27 A.
COAL OWNED BY S. FAYETTE COAL CO.

Marshall W. Hunt 2-15-80

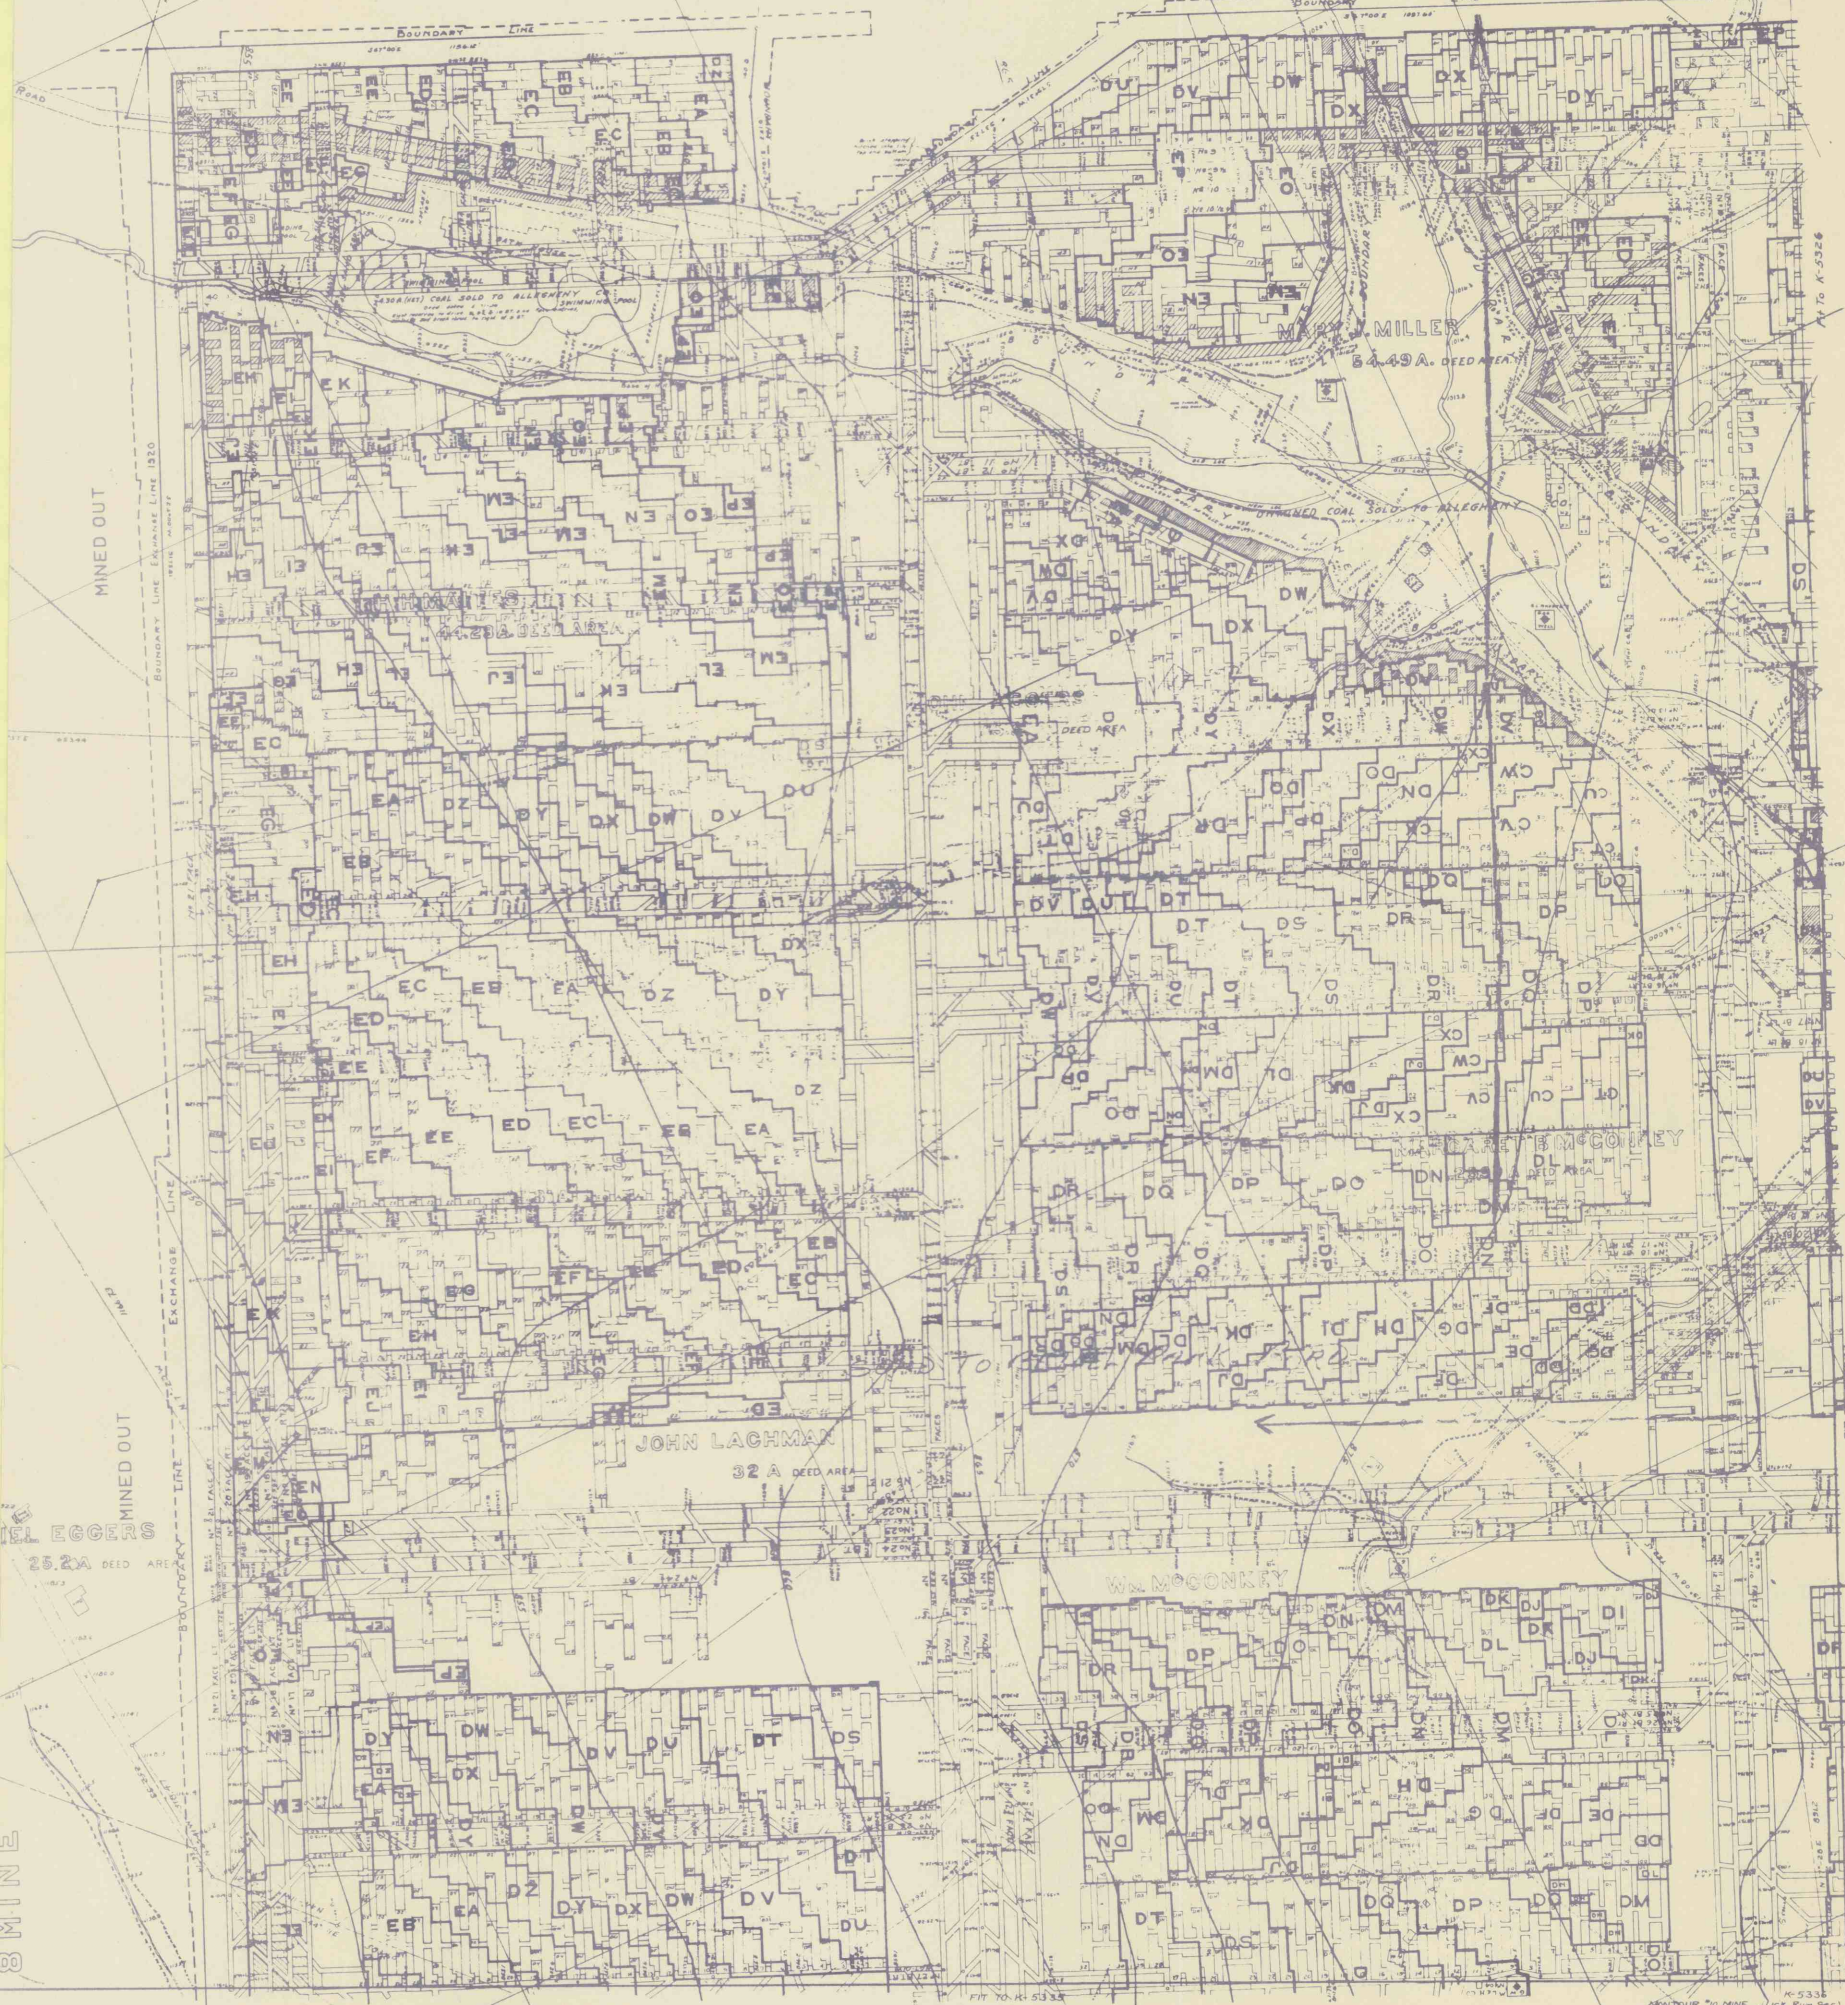

FIT TO 12

SOLD TO
SO. PARK T.

FIT TO 6

Mont 10 1"=200' 5