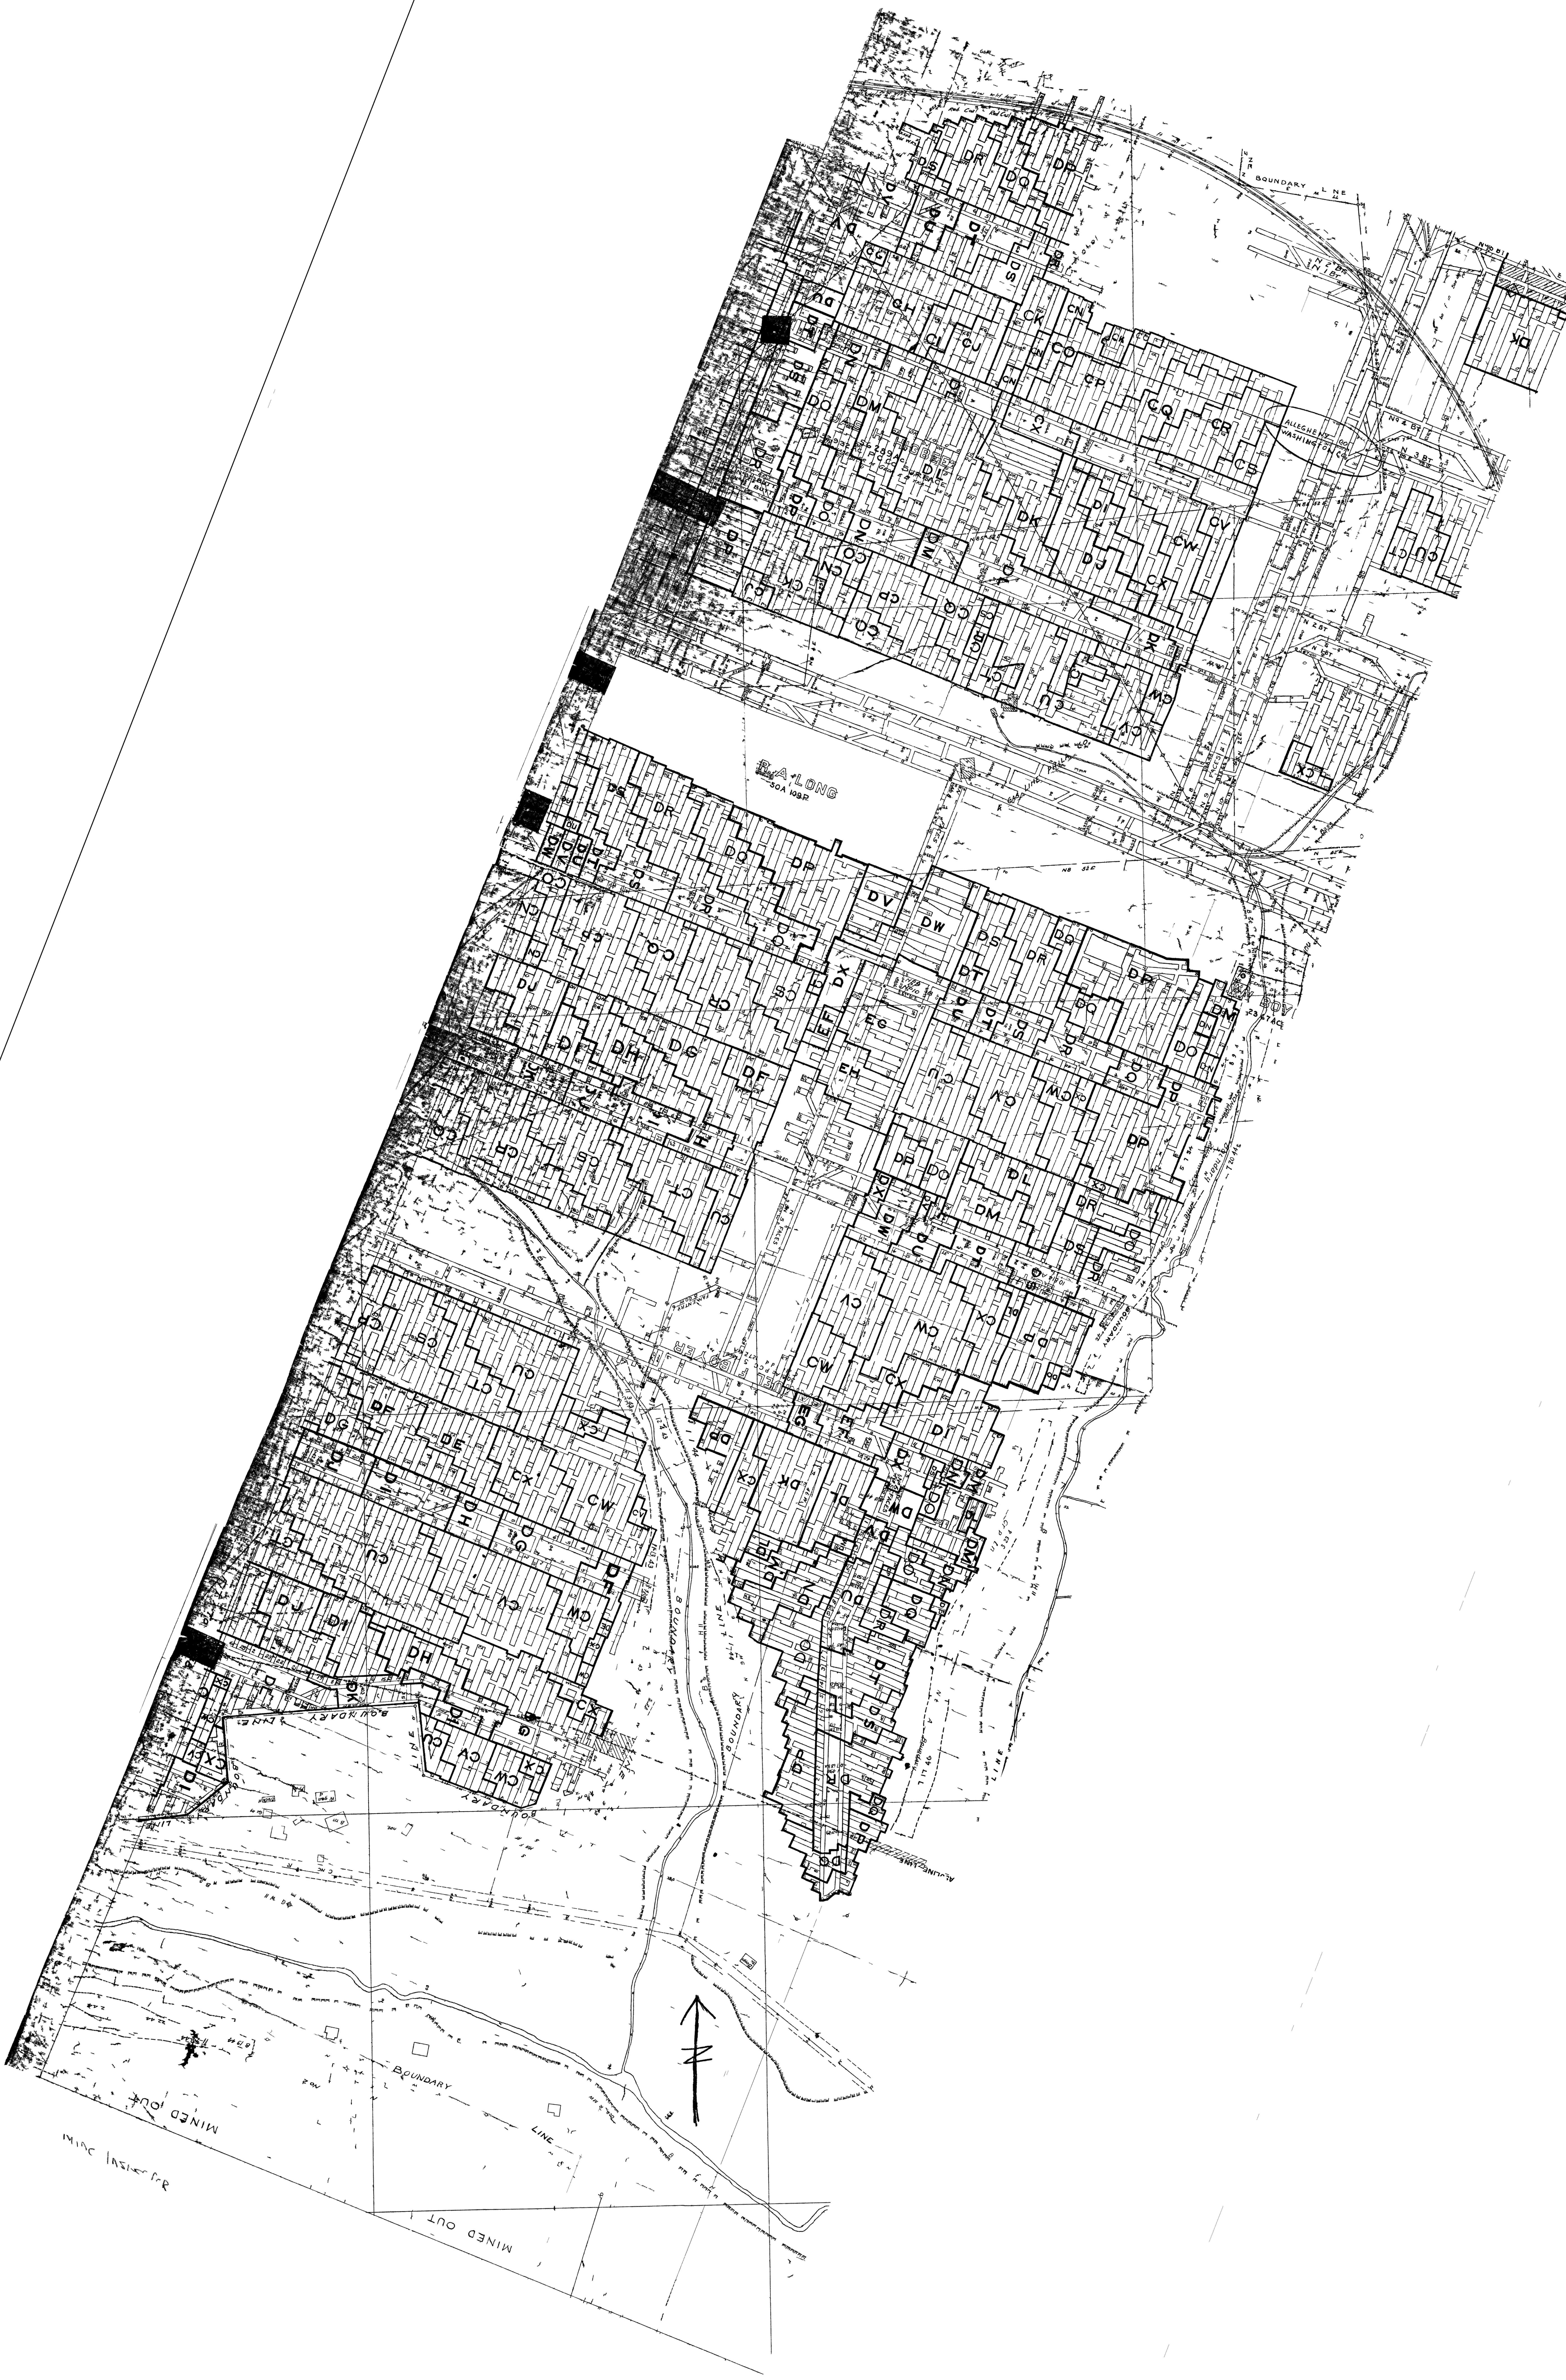
BOUNDARY LINE
N 2 BT
N 1 BT
N 8 BT
No 4 BT
N 3 BT
ALLEGHENY
WASHINGTON CO.
Red Coal
R. A. LONG
50A 109 P
GAS LINE PHILA
FACES
323.47 AC
BOUNDARY
LINE
N
MINED OUT
MINED OUT
DS
DR
DQ
DP
DO
DN
DM
DL
DK
DJ
DI
DH
DG
DF
DE
DT
DU
DV
DW
DX
EF
EG
EH
CJ
CK
CL
CN
CO
CP
CQ
CR
CS
CT
CU
CV
CW
CX

Mine Inspector