


#1149
12-17-97
CC



LEGEND

- Boundary Line
- Mining Completed
- Proposed 6 Mo. Mining
1-20-72 to 6-20-72

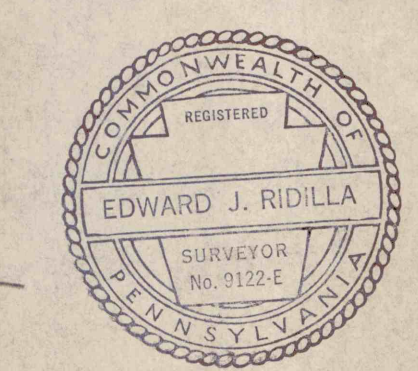

REVISED 6-22-67 EJR
MINING OPERATION MAP
for
IRVIN W. MOORE
No. 36 01475
MOORE MINE "E" SEAM
JENNER TWP. SOMERSET CO. PA.
SCALE 1"=100'
TRACED OCT 17, 1966 FROM
COSGROVE-MEEHAN COAL CO.
THERMAL No. 14 MINE
ACOSTA, PA DATED DEC 19, 1930
BY ELMER F. RHODES JR. P.E.

From PA. Abandoned Mine File