


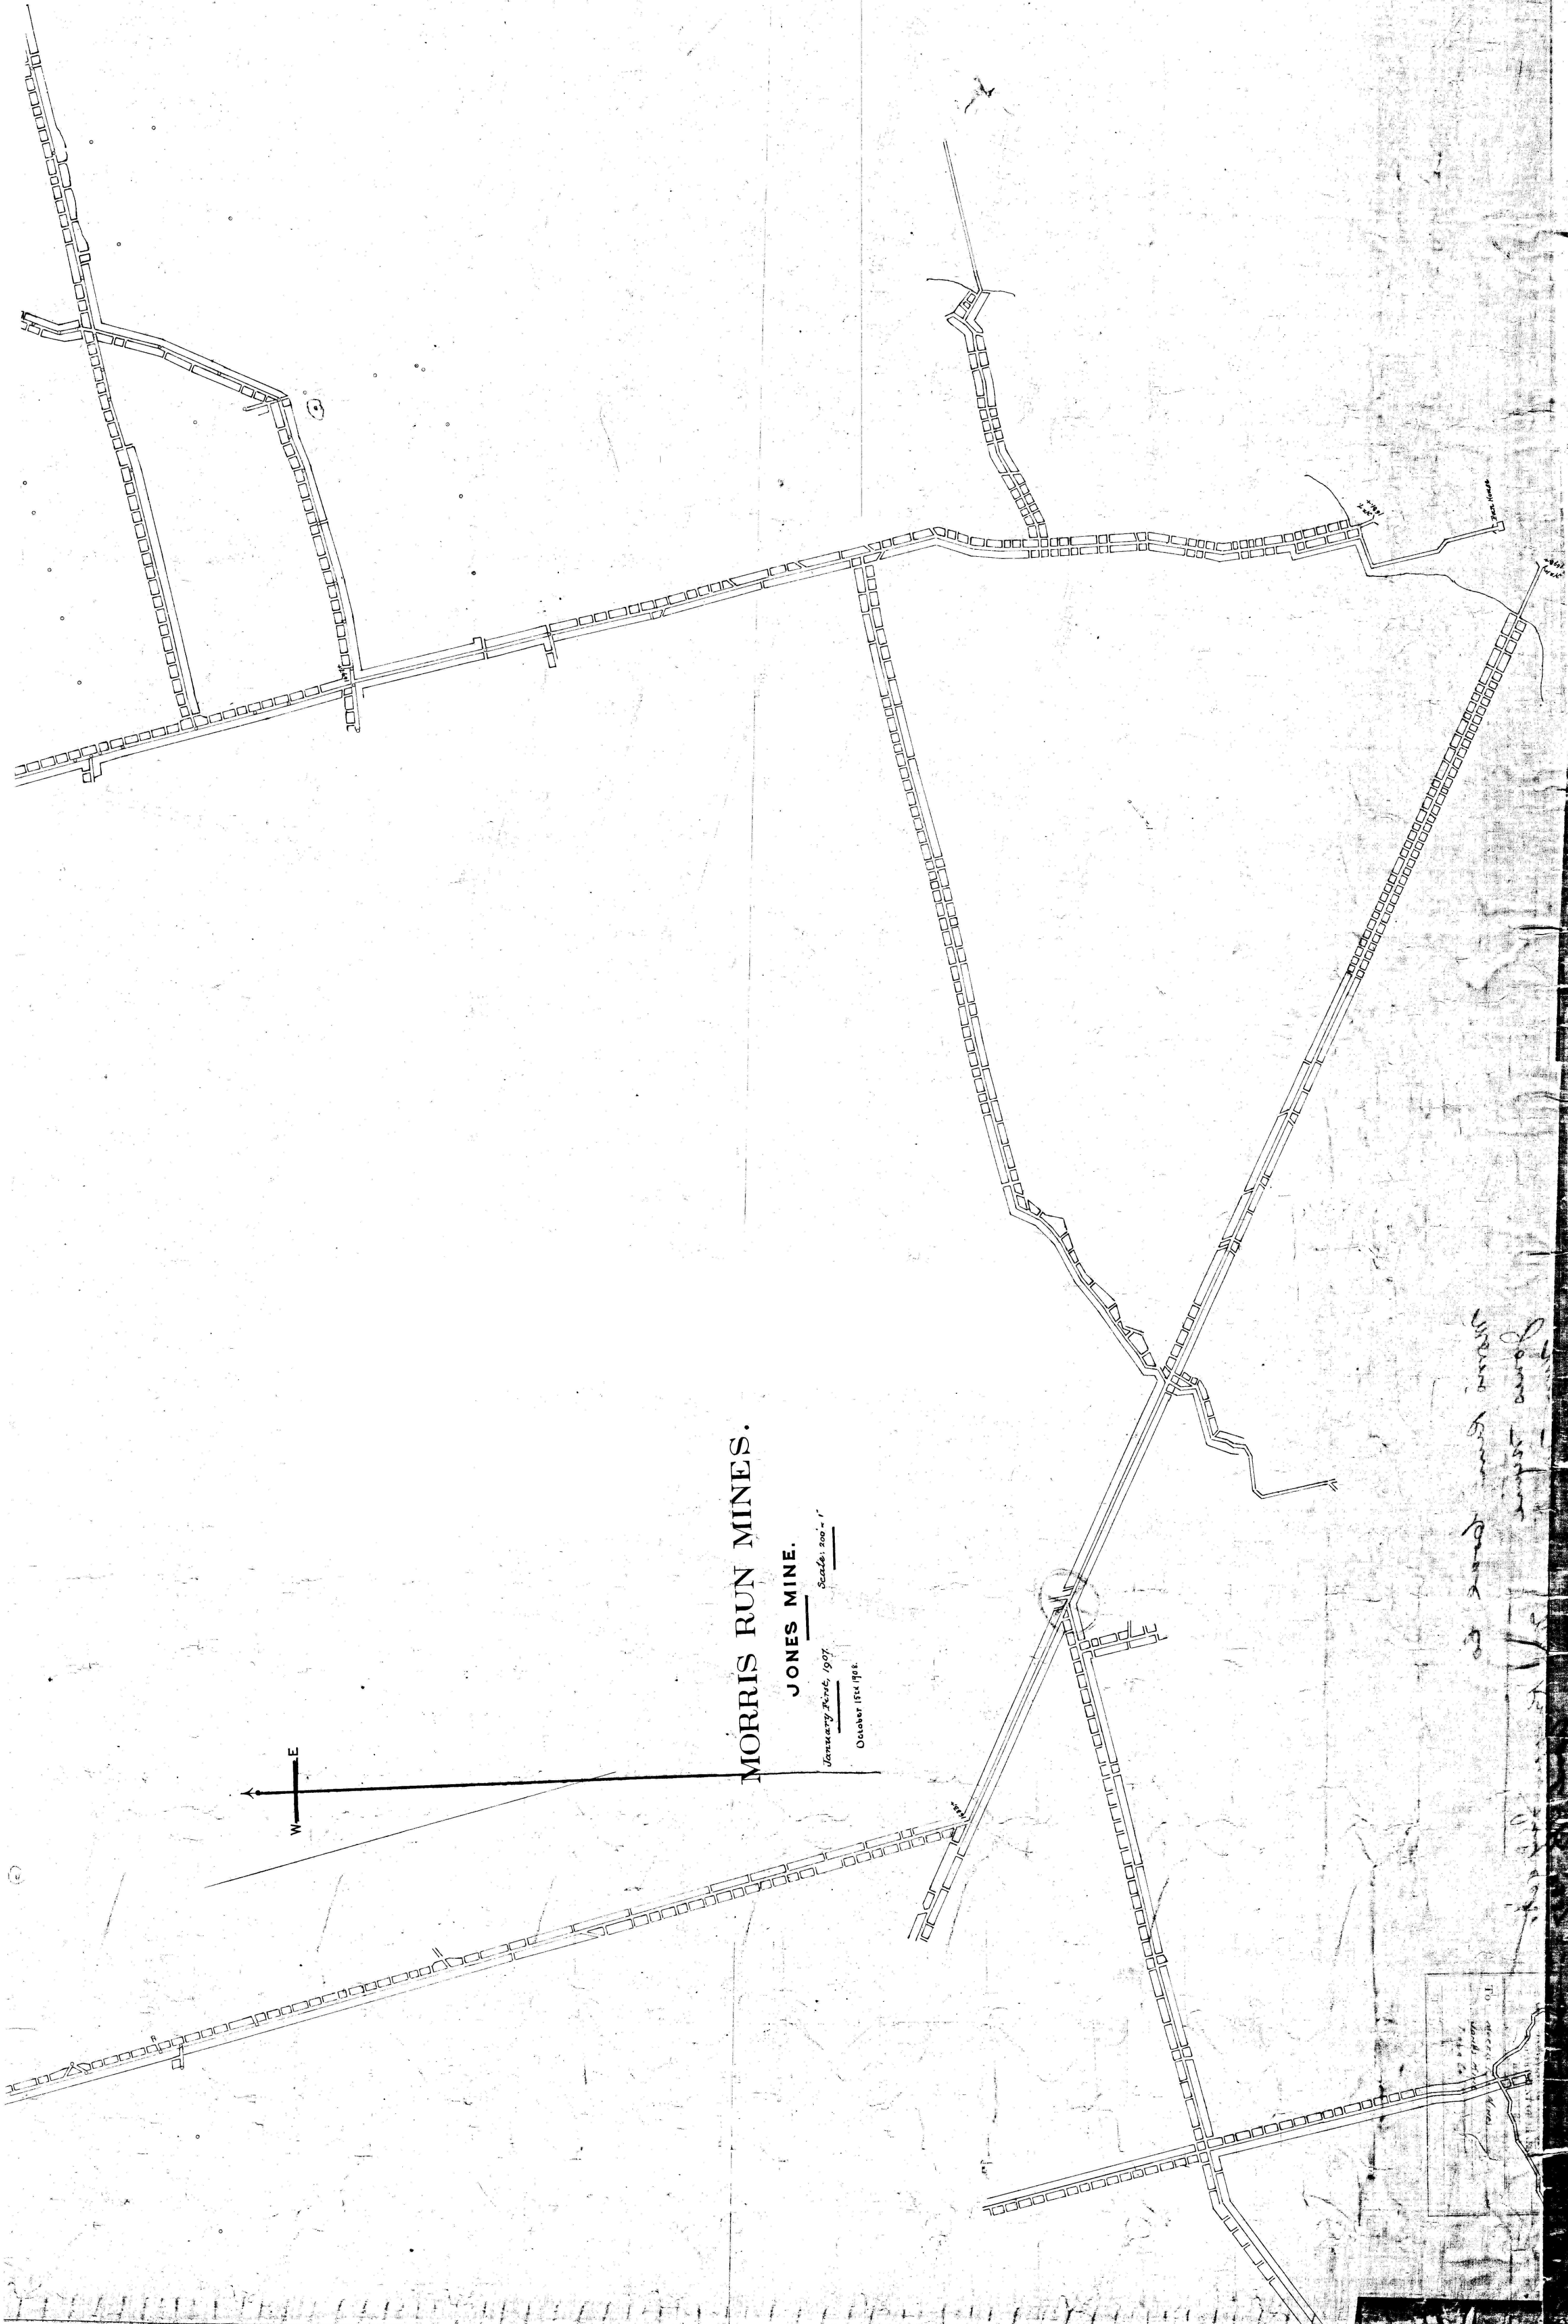

MORRIS RUN MINES.

JONES MINE.


Jones Mine
Morris Run

To Morris Run
Mines