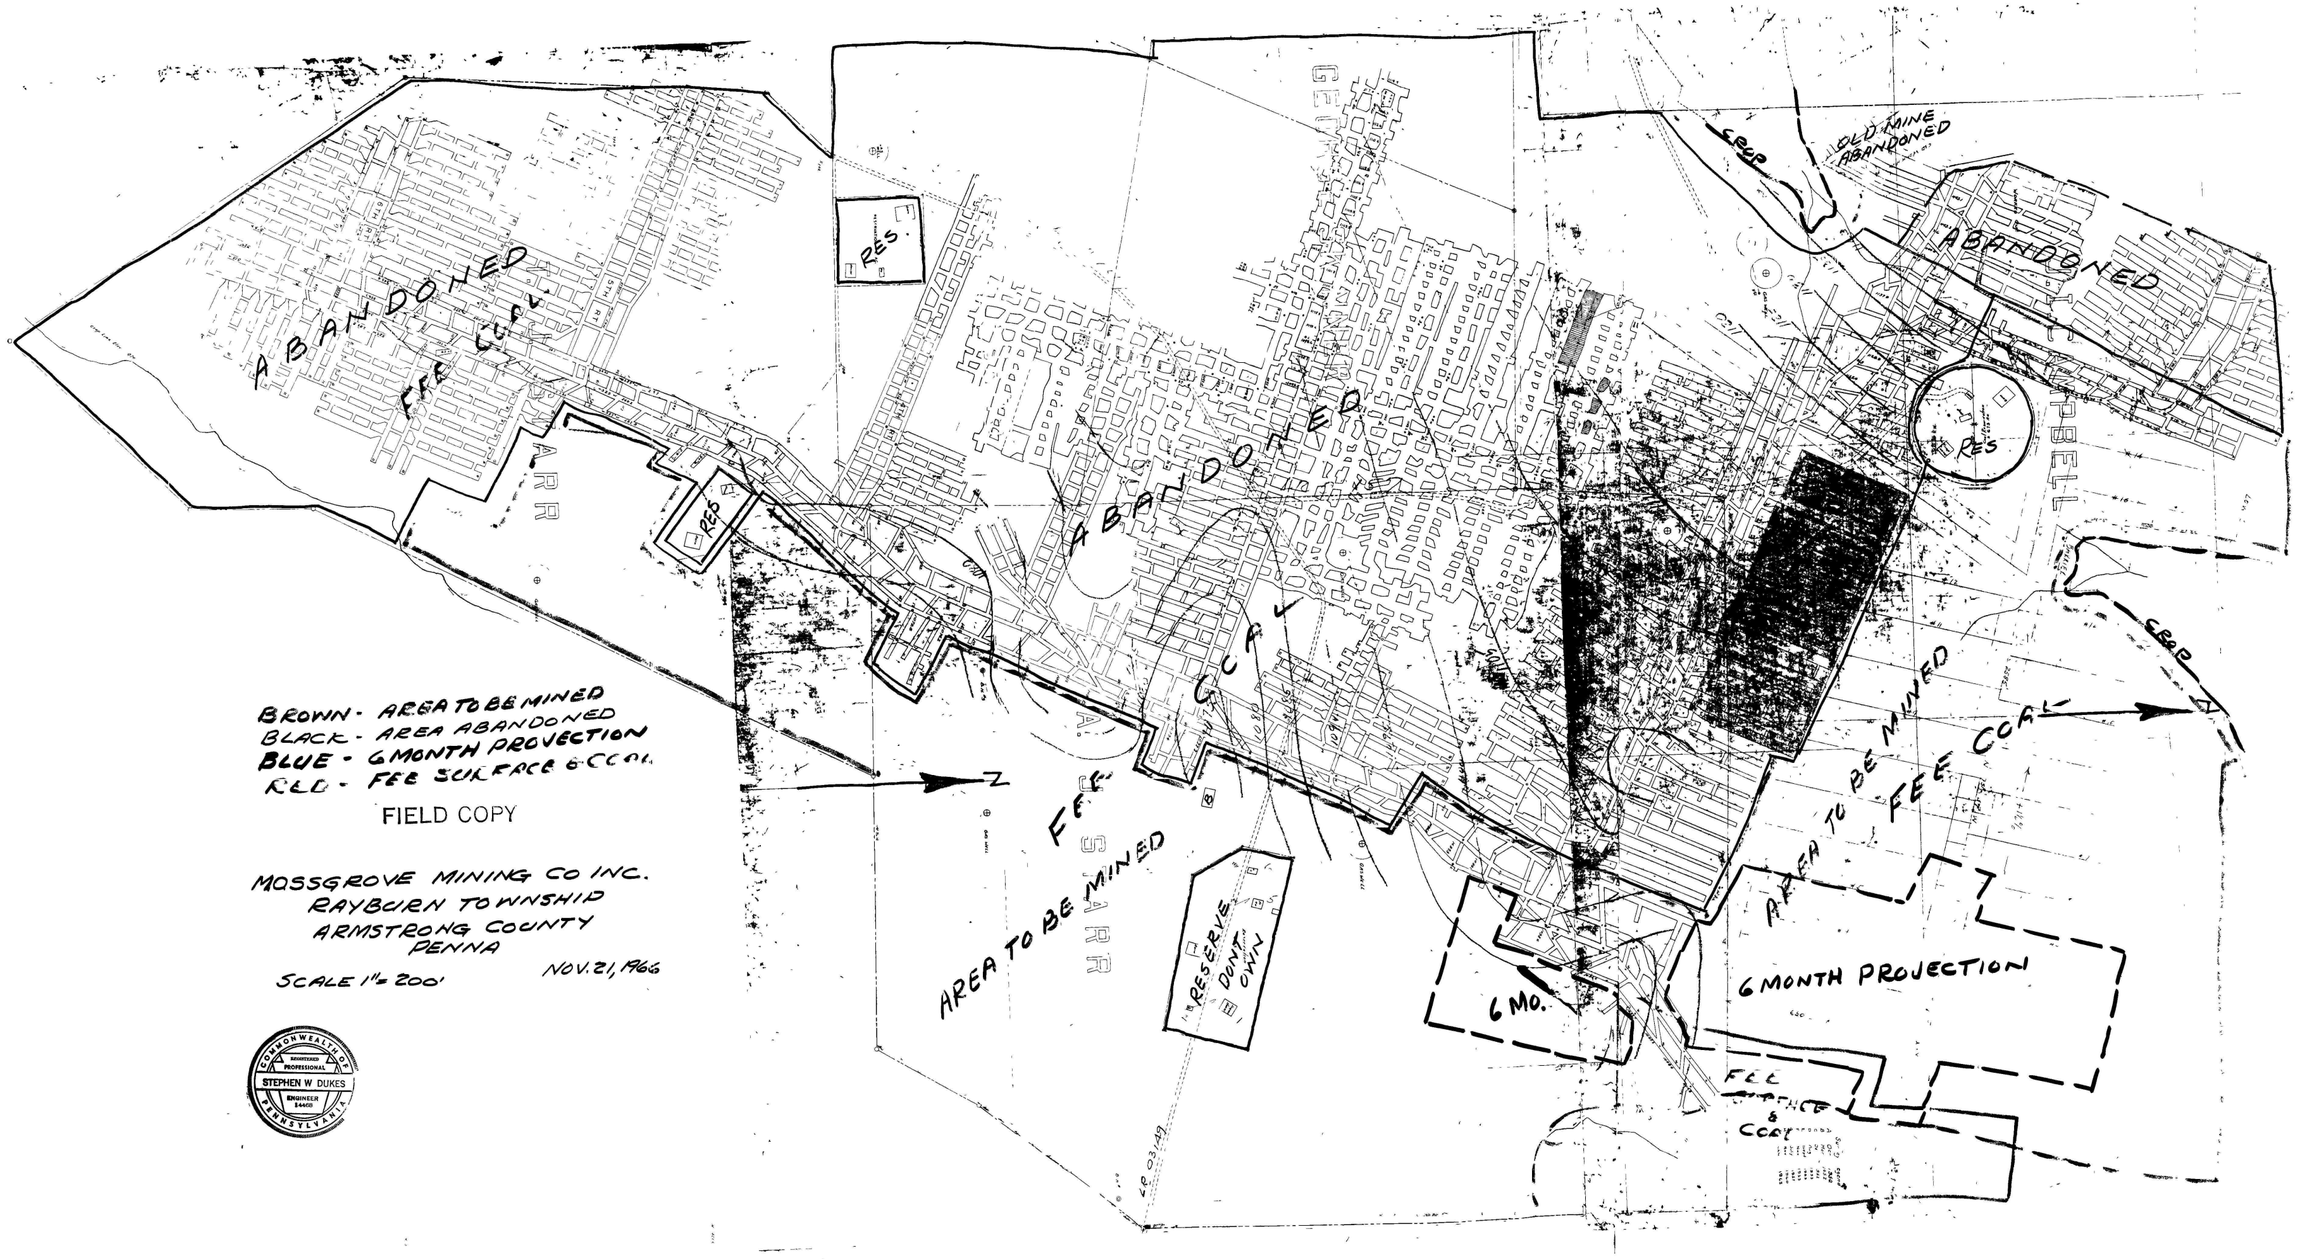

#1808
12-20-99
CC