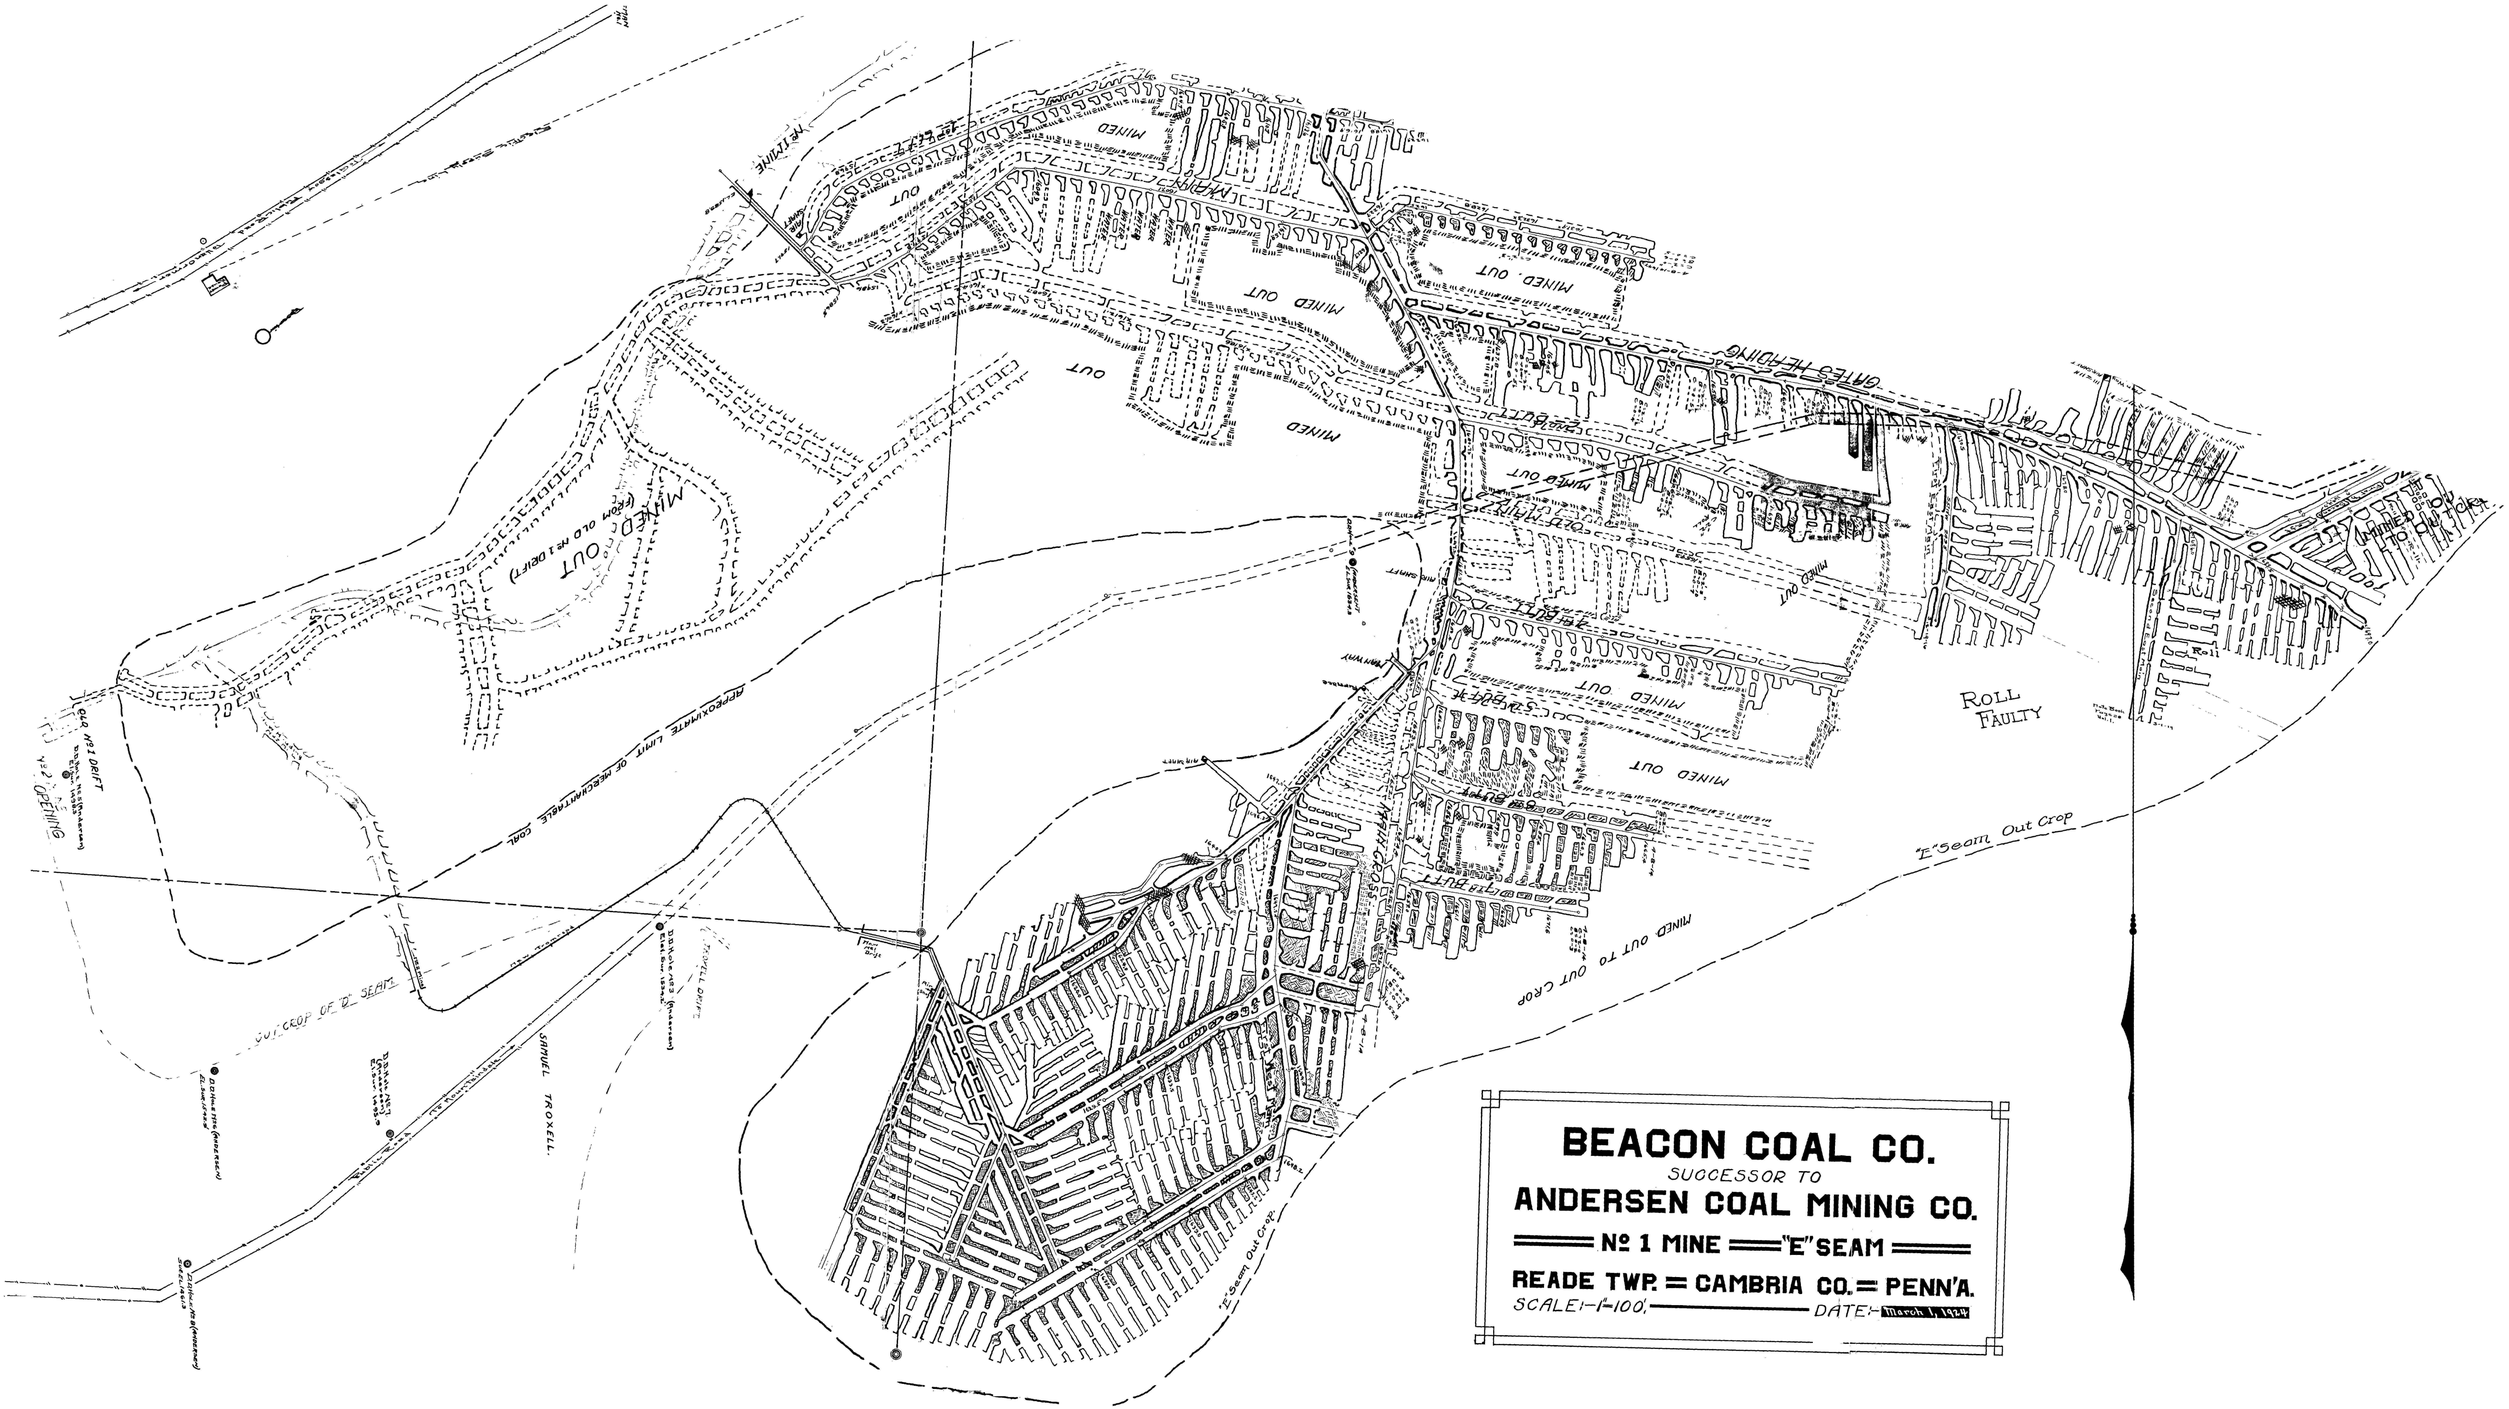
BEACON COAL CO.
SUCCESSOR TO
ANDERSEN COAL MINING CO.
Nº 1 MINE "E" SEAM
READE TWP. = CAMBRIA CO. = PENN'A.
SCALE:- 1" = 100'
DATE:- March 1, 1924
ROLL FAULTY
"E" Seam Out Crop
MINED OUT
MINED OUT TO OUT CROP
GATES TIE HOLING
OUT CROP OF "D" SEAM
APPROXIMATE LIMIT OF RECLAIMABLE COAL
SAMUEL TROXELL
No 1 DRIFT
OPENING
MINED OUT (FROM OLD No 1 DRIFT)